


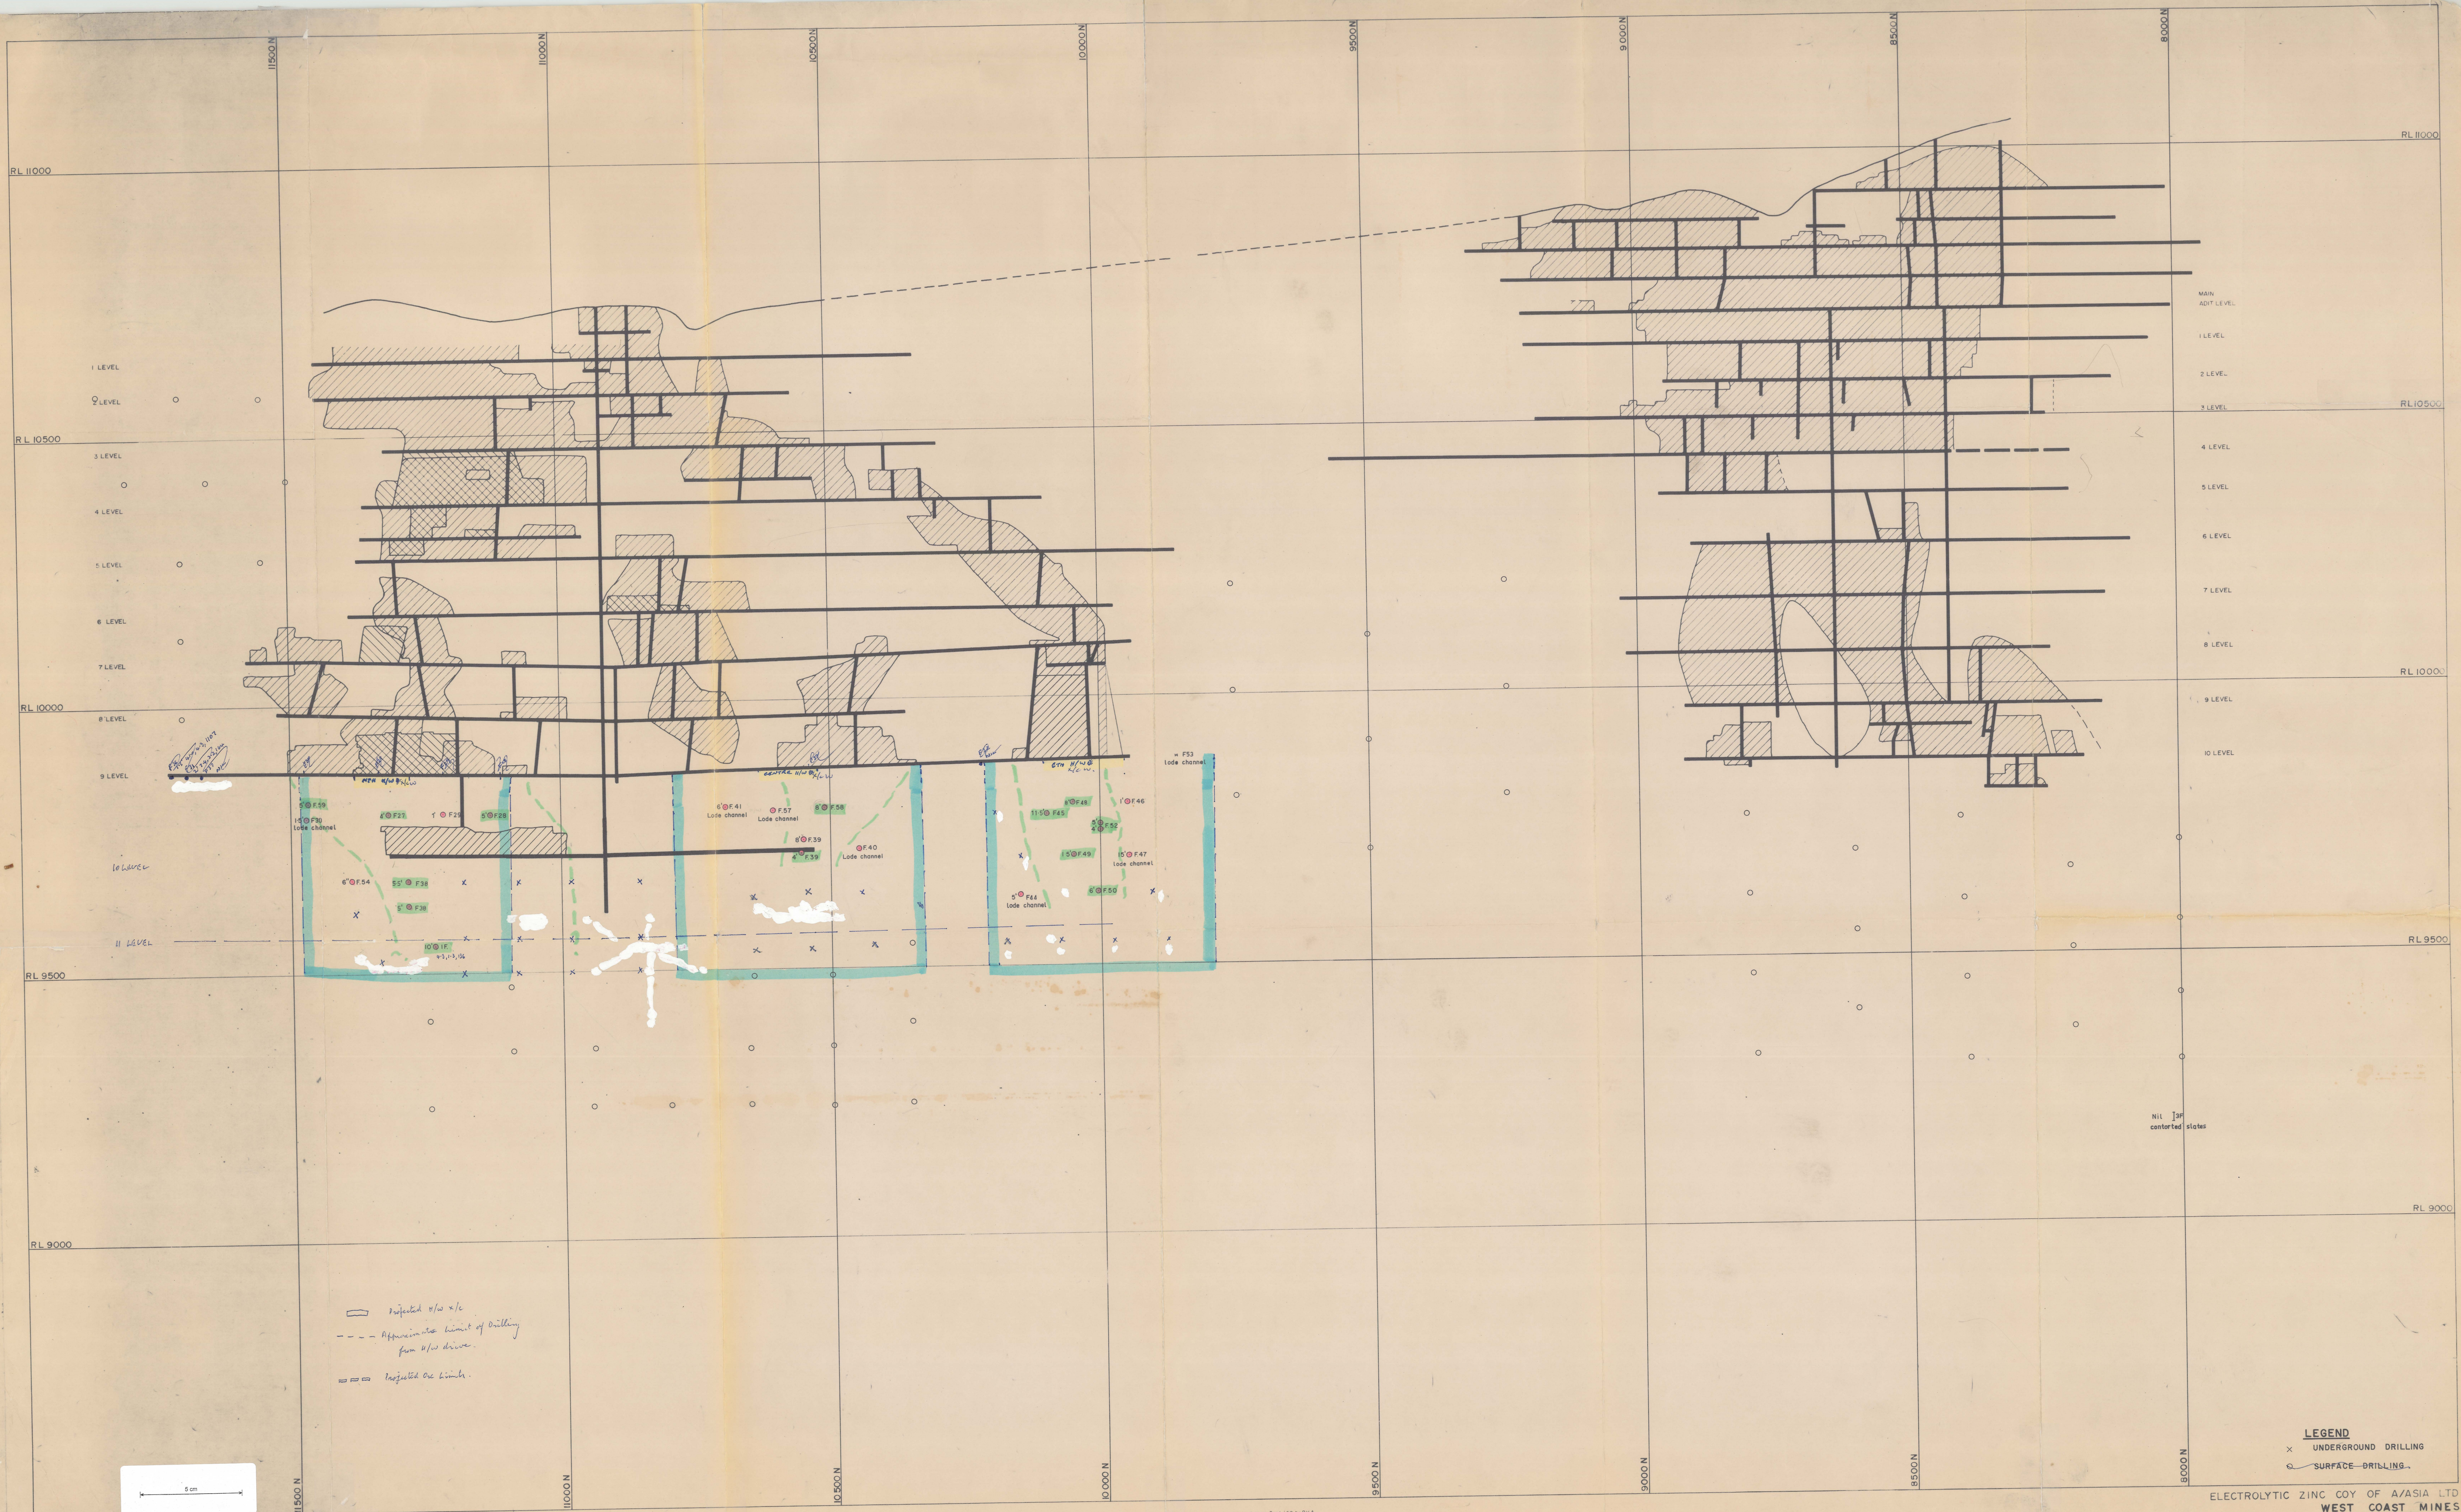

FARRELL MINE
LONGITUDINAL PROJECTION
 SCALE 1" = 100'

LEGEND
 X UNDERGROUND DRILLING
 O SURFACE DRILLING

ELECTROLYTIC ZINC COY OF ASIA LTD
WEST COAST MINES
 MINING DEPARTMENT

910-1900