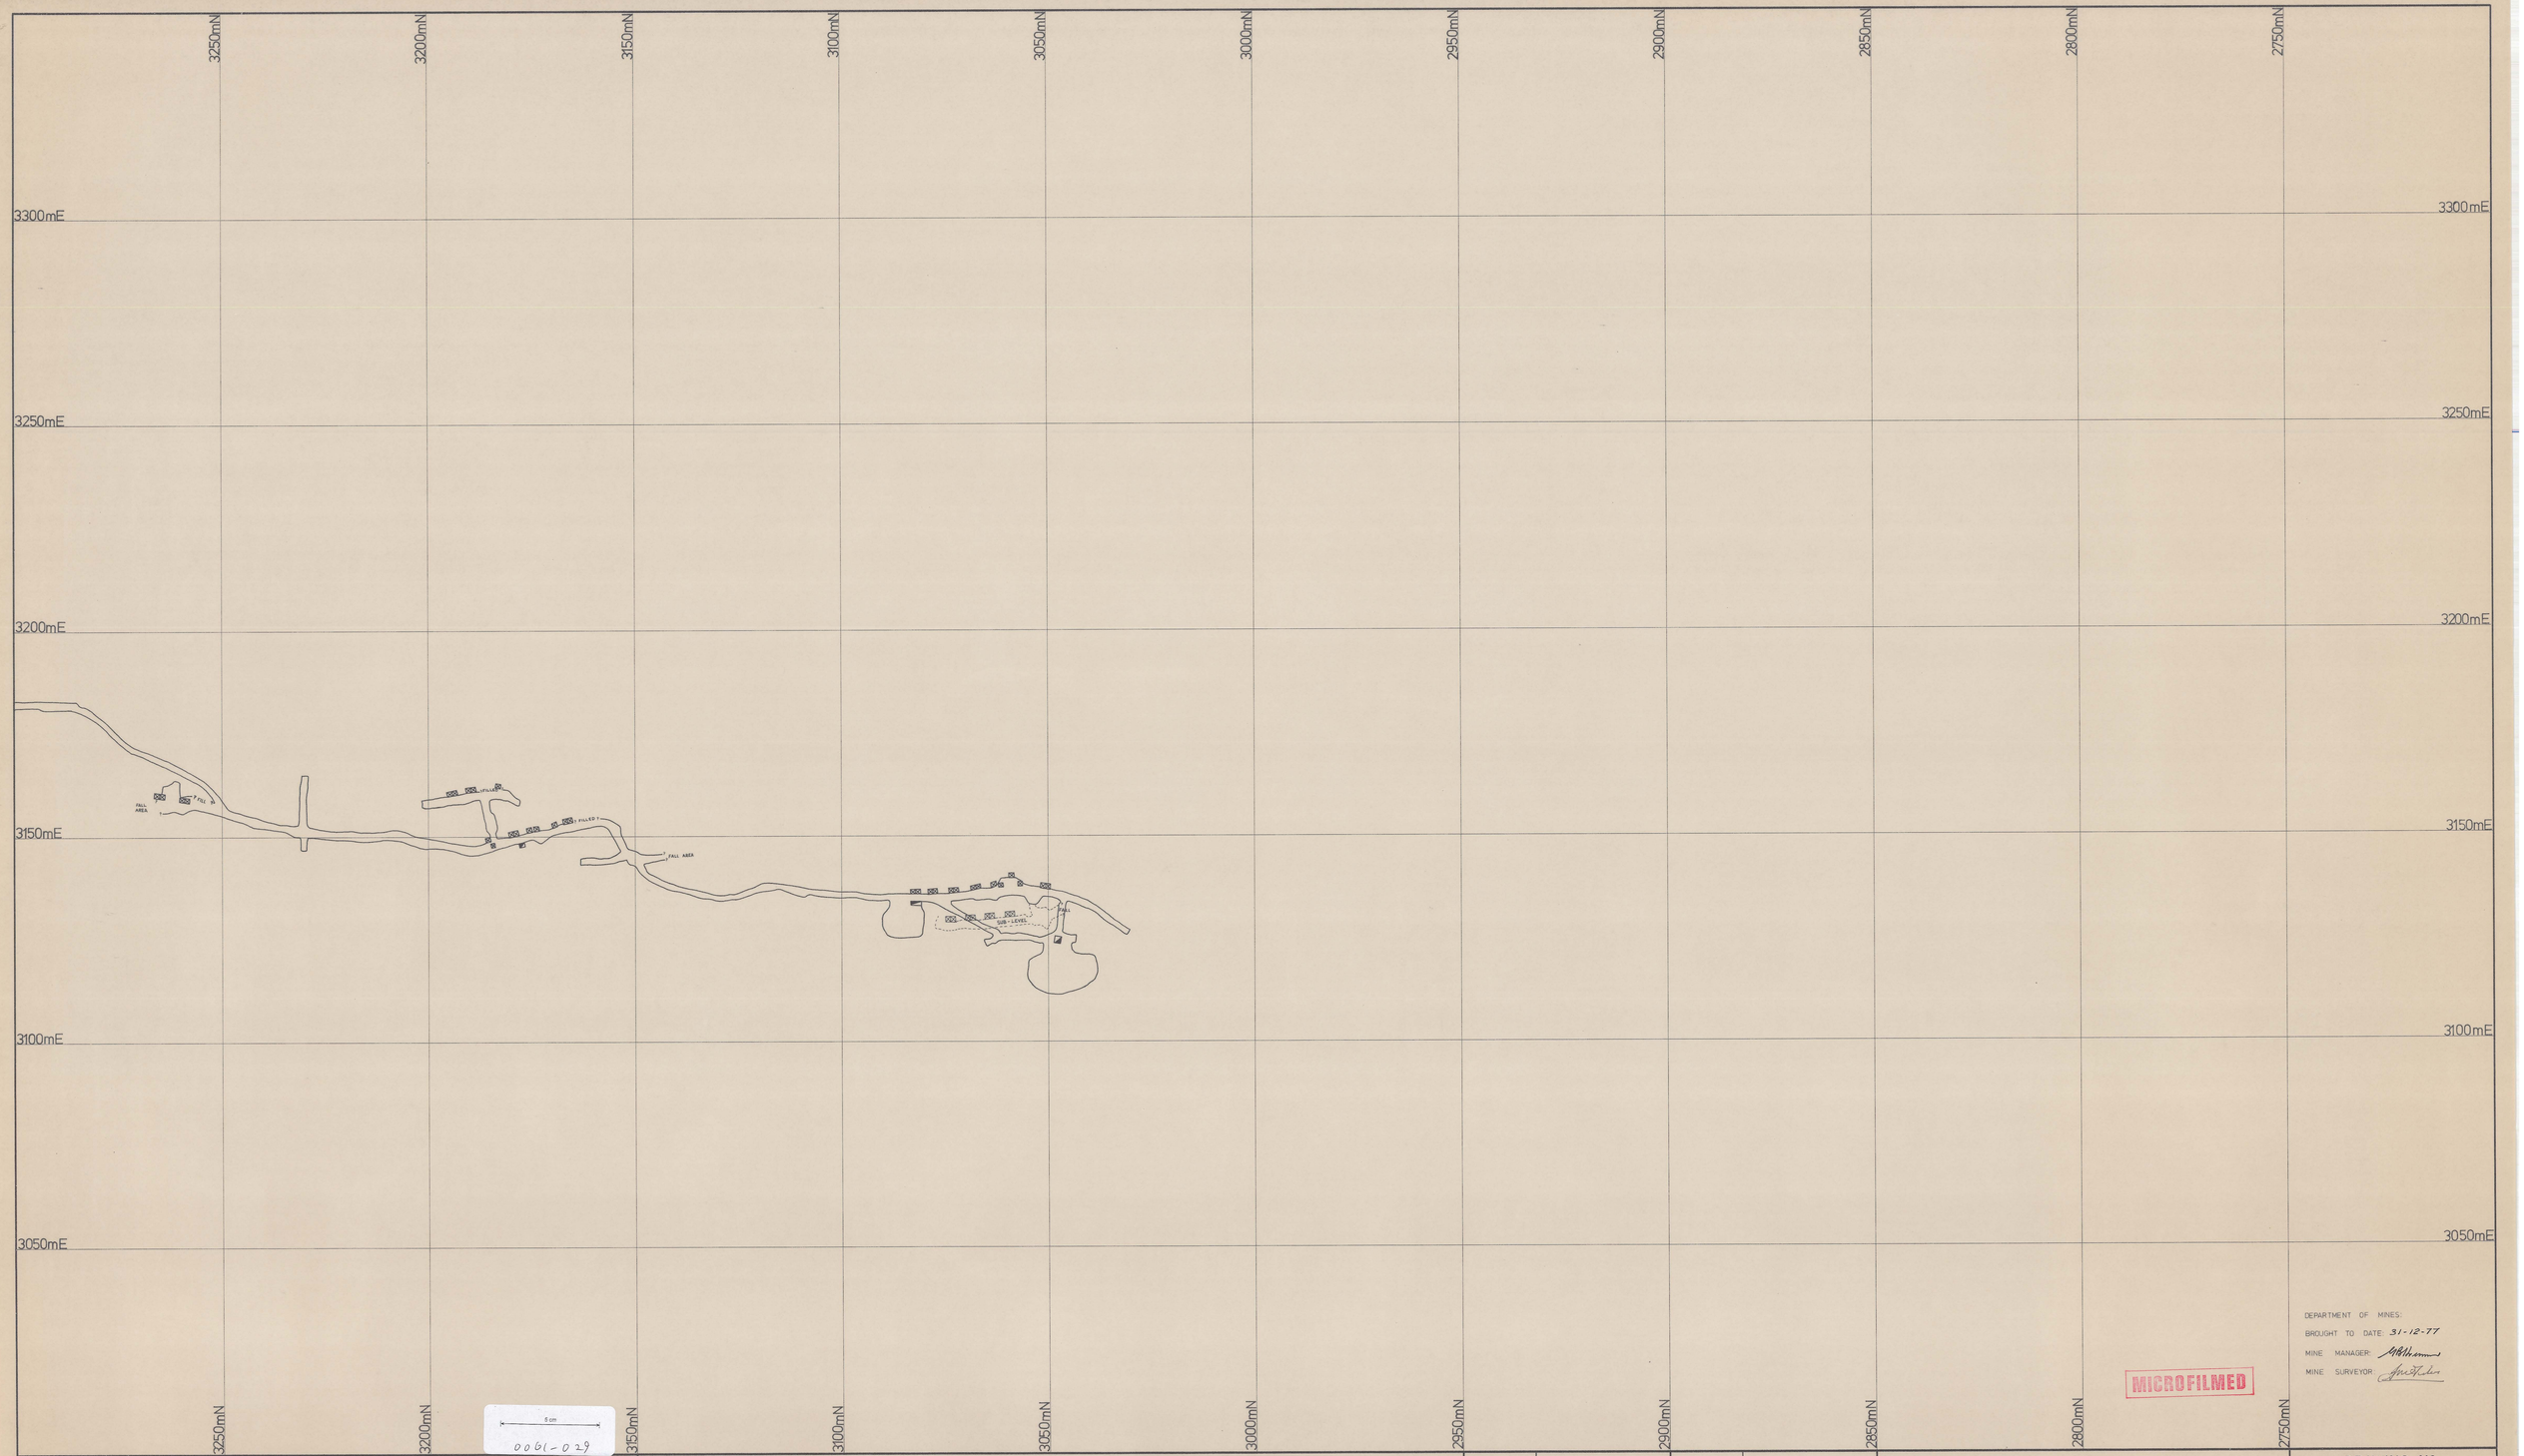

SCALE SHOWING 1:500 METRES AND EQUIVALENT FEET

0 25 50 75 100 Metres

0 100 200 300 400 Feet

ELECTROLYTIC ZINC COMPANY OF AUSTRALASIA LIMITED

WEST COAST MINES, TAS.

SURVEY BY		SCALE	1 : 500
DRAWN BY		DATE	1975
TRACED BY		REFERENCE	

FARRELL MINE

Nº 7 LEVEL (2)

DRAWING Nº: (1) (2) 73158