


0061-031



5m
0061-031

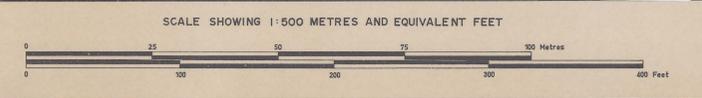

ELECTROLYTIC ZINC COMPANY OF AUSTRALASIA LIMITED
WEST COAST MINES, T.A.S.

SURVEY BY		SCALE	1:500
DRAWN BY		DATE	1975
TRACED BY		REFERENCE	

FARRELL MINE
No 6 LEVEL (2)

MICROFILMED

DEPARTMENT OF MINES
BROUGHT TO DATE 31-12-77
MINE MANAGER *A. H. ...*
MINE SURVEYOR *...*

DRAWING No: ① 78136