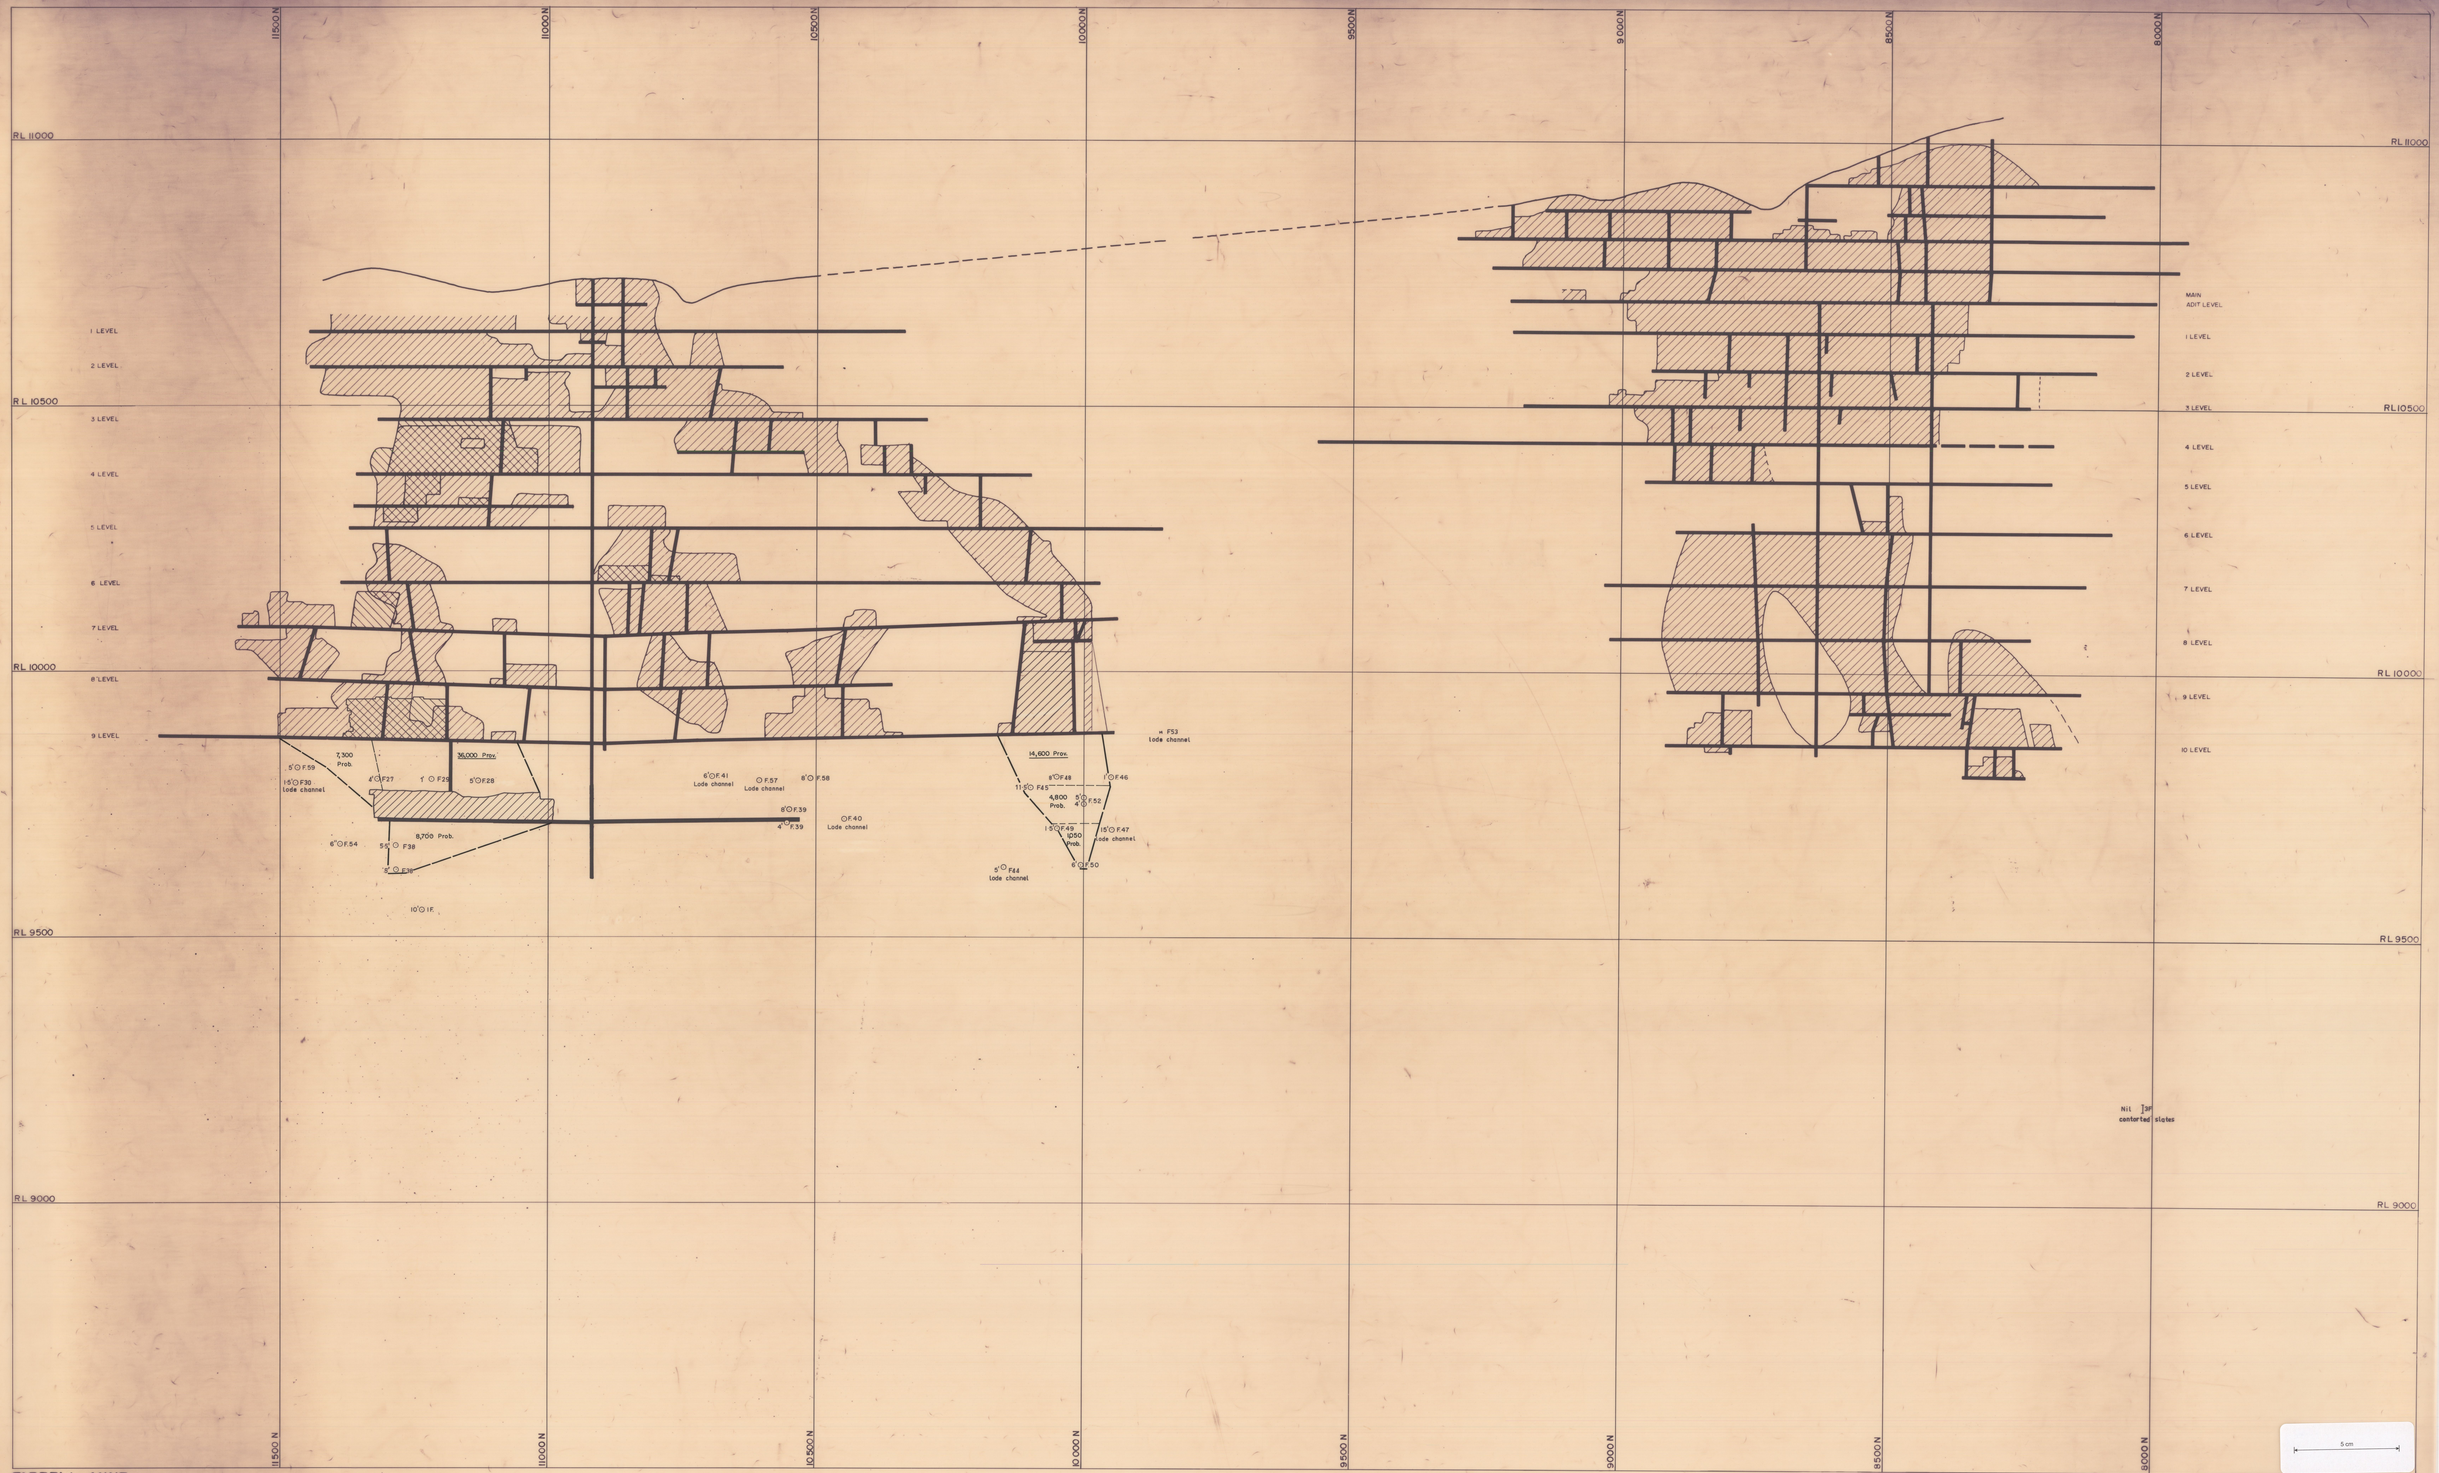

FARRELL MINE
LONGITUDINAL PROJECTION
SCALE 1" = 100'

NOTE: This plan was re-drawn during Sept '69 by P.K.A. Section below 7 Lev. in the northern mine is based on present day survey. All other sections based on old information.

ELECTROLYTIC ZINC COY OF A/ASIA LTD
WEST COAST MINES
MINING DEPARTMENT

0061_041B