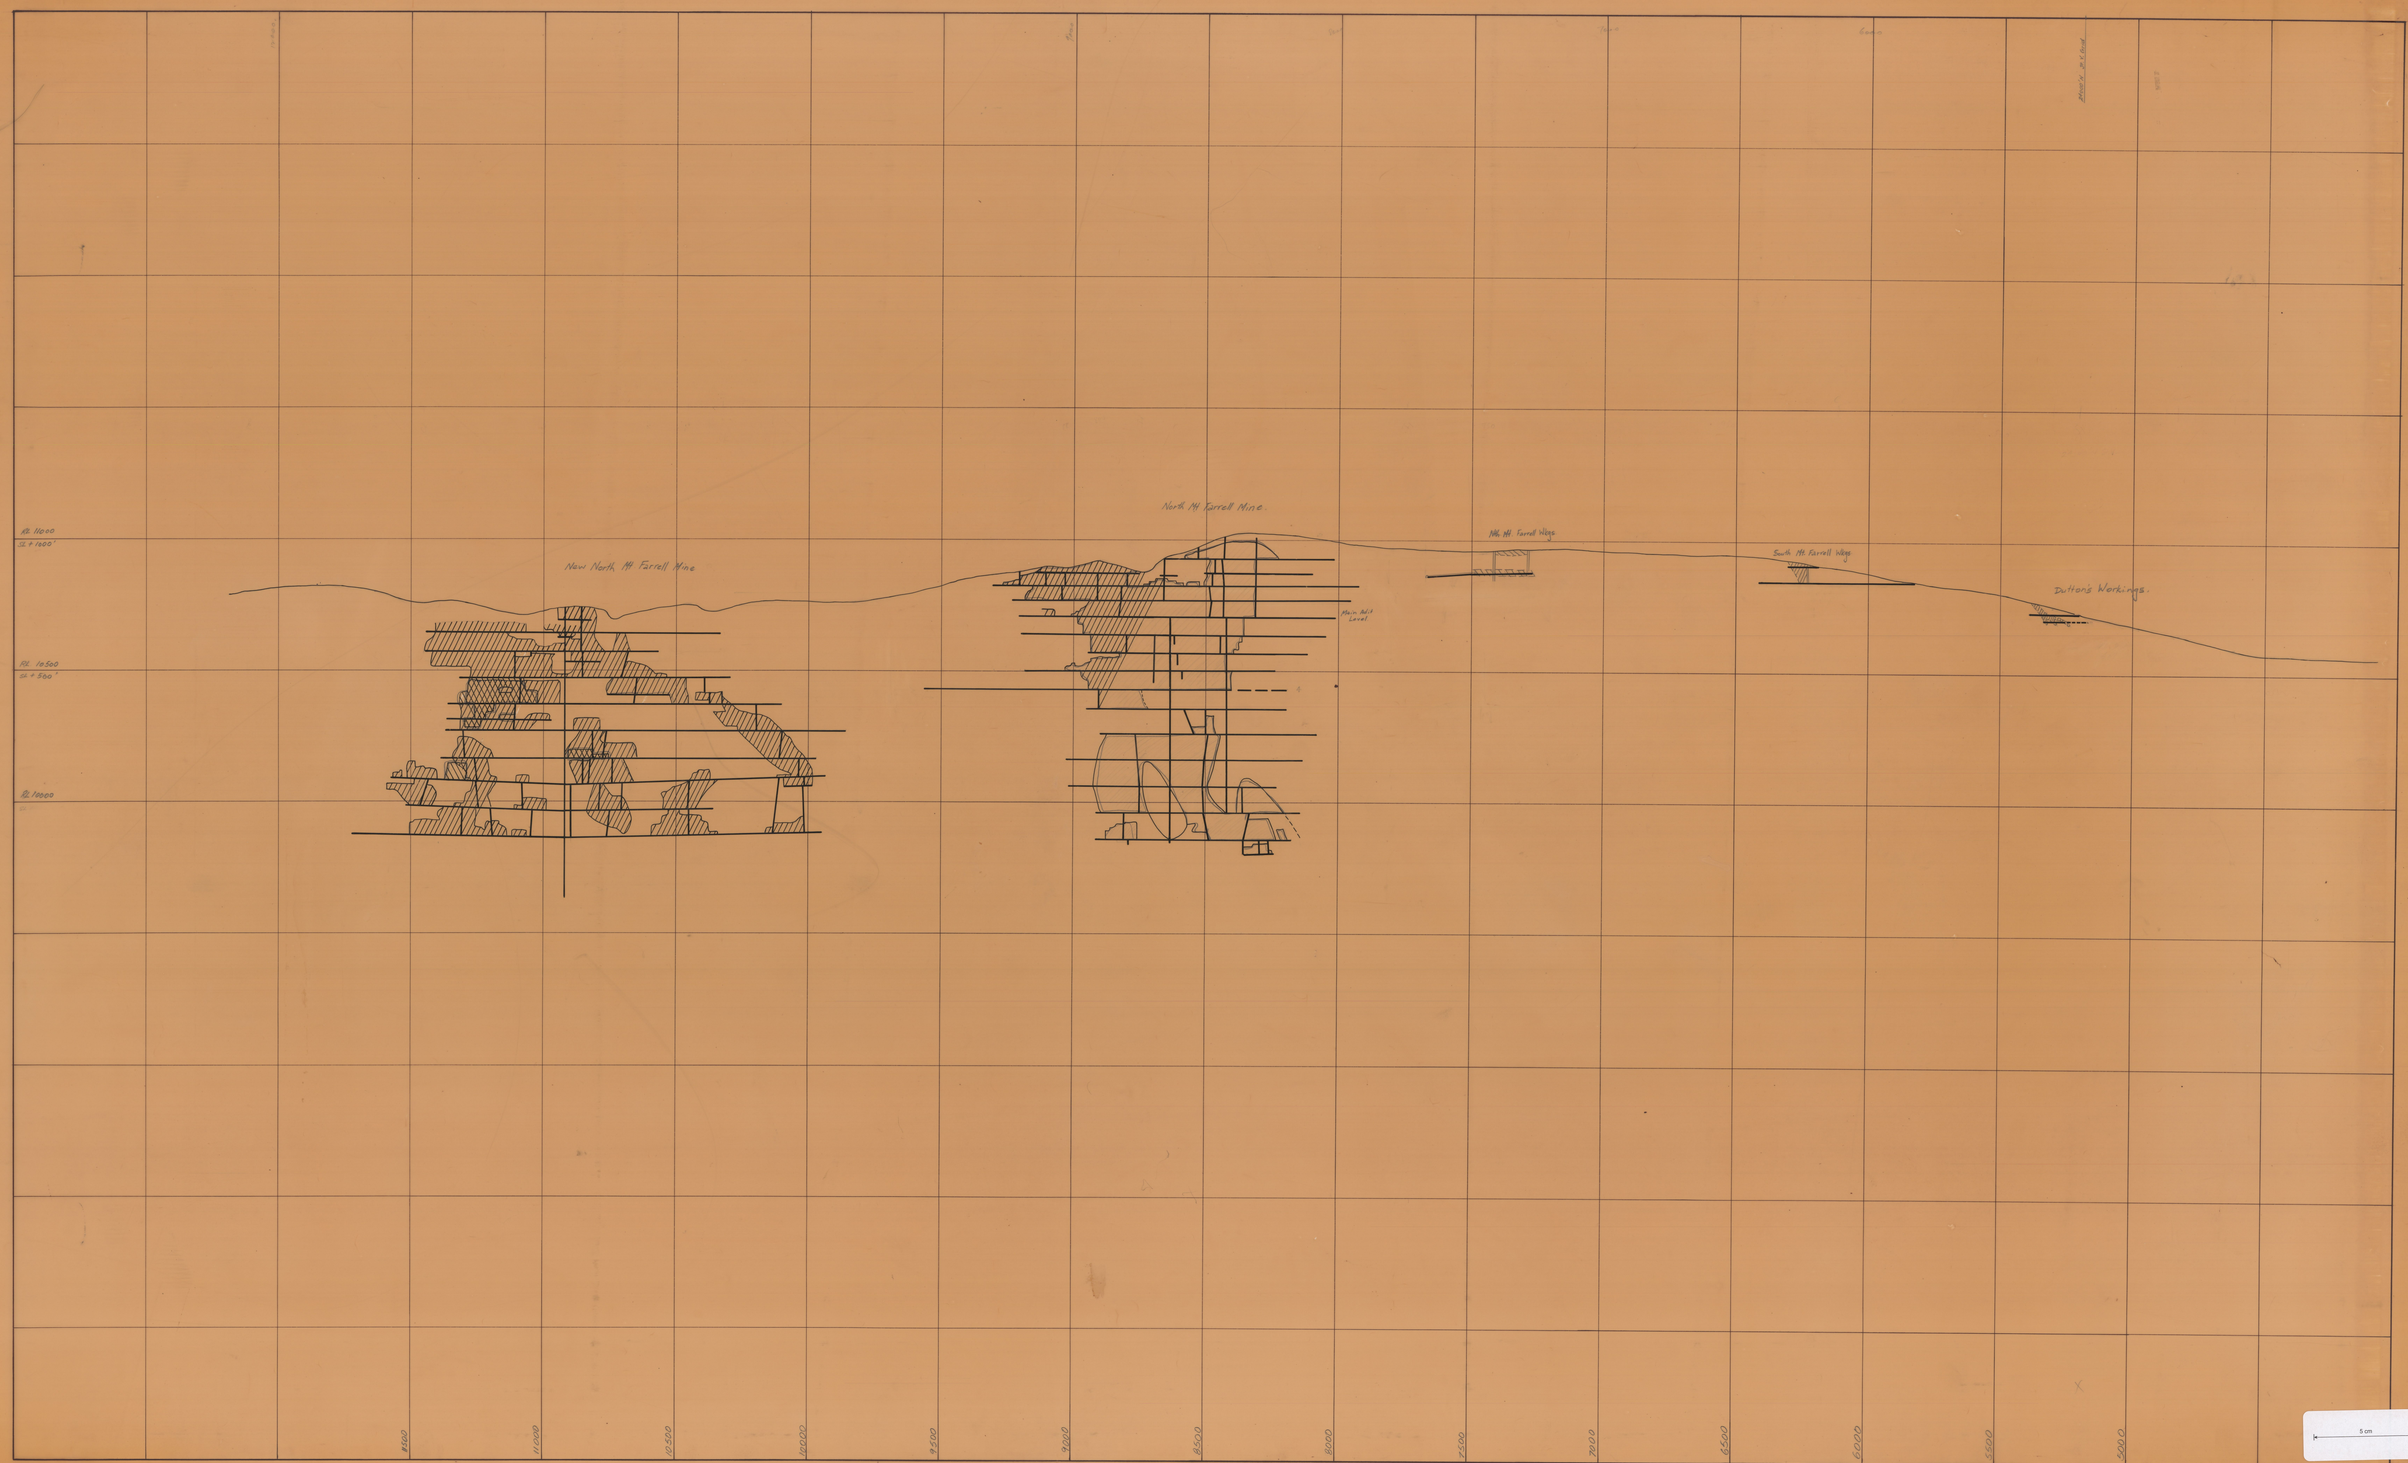
RL 11000
RL 10500
RL 10000
New North Mt Farrell Mine
North Mt Farrell Mine.
Main Adit Level
Mt Mt Farrell Vlegs
South Mt Farrell Vlegs
Duttons Workings.
11500
11000
10500
10000
9500
9000
8500
8000
7500
7000
6500
6000
5500
5000
5 cm

0061_041C