


0061\_041D

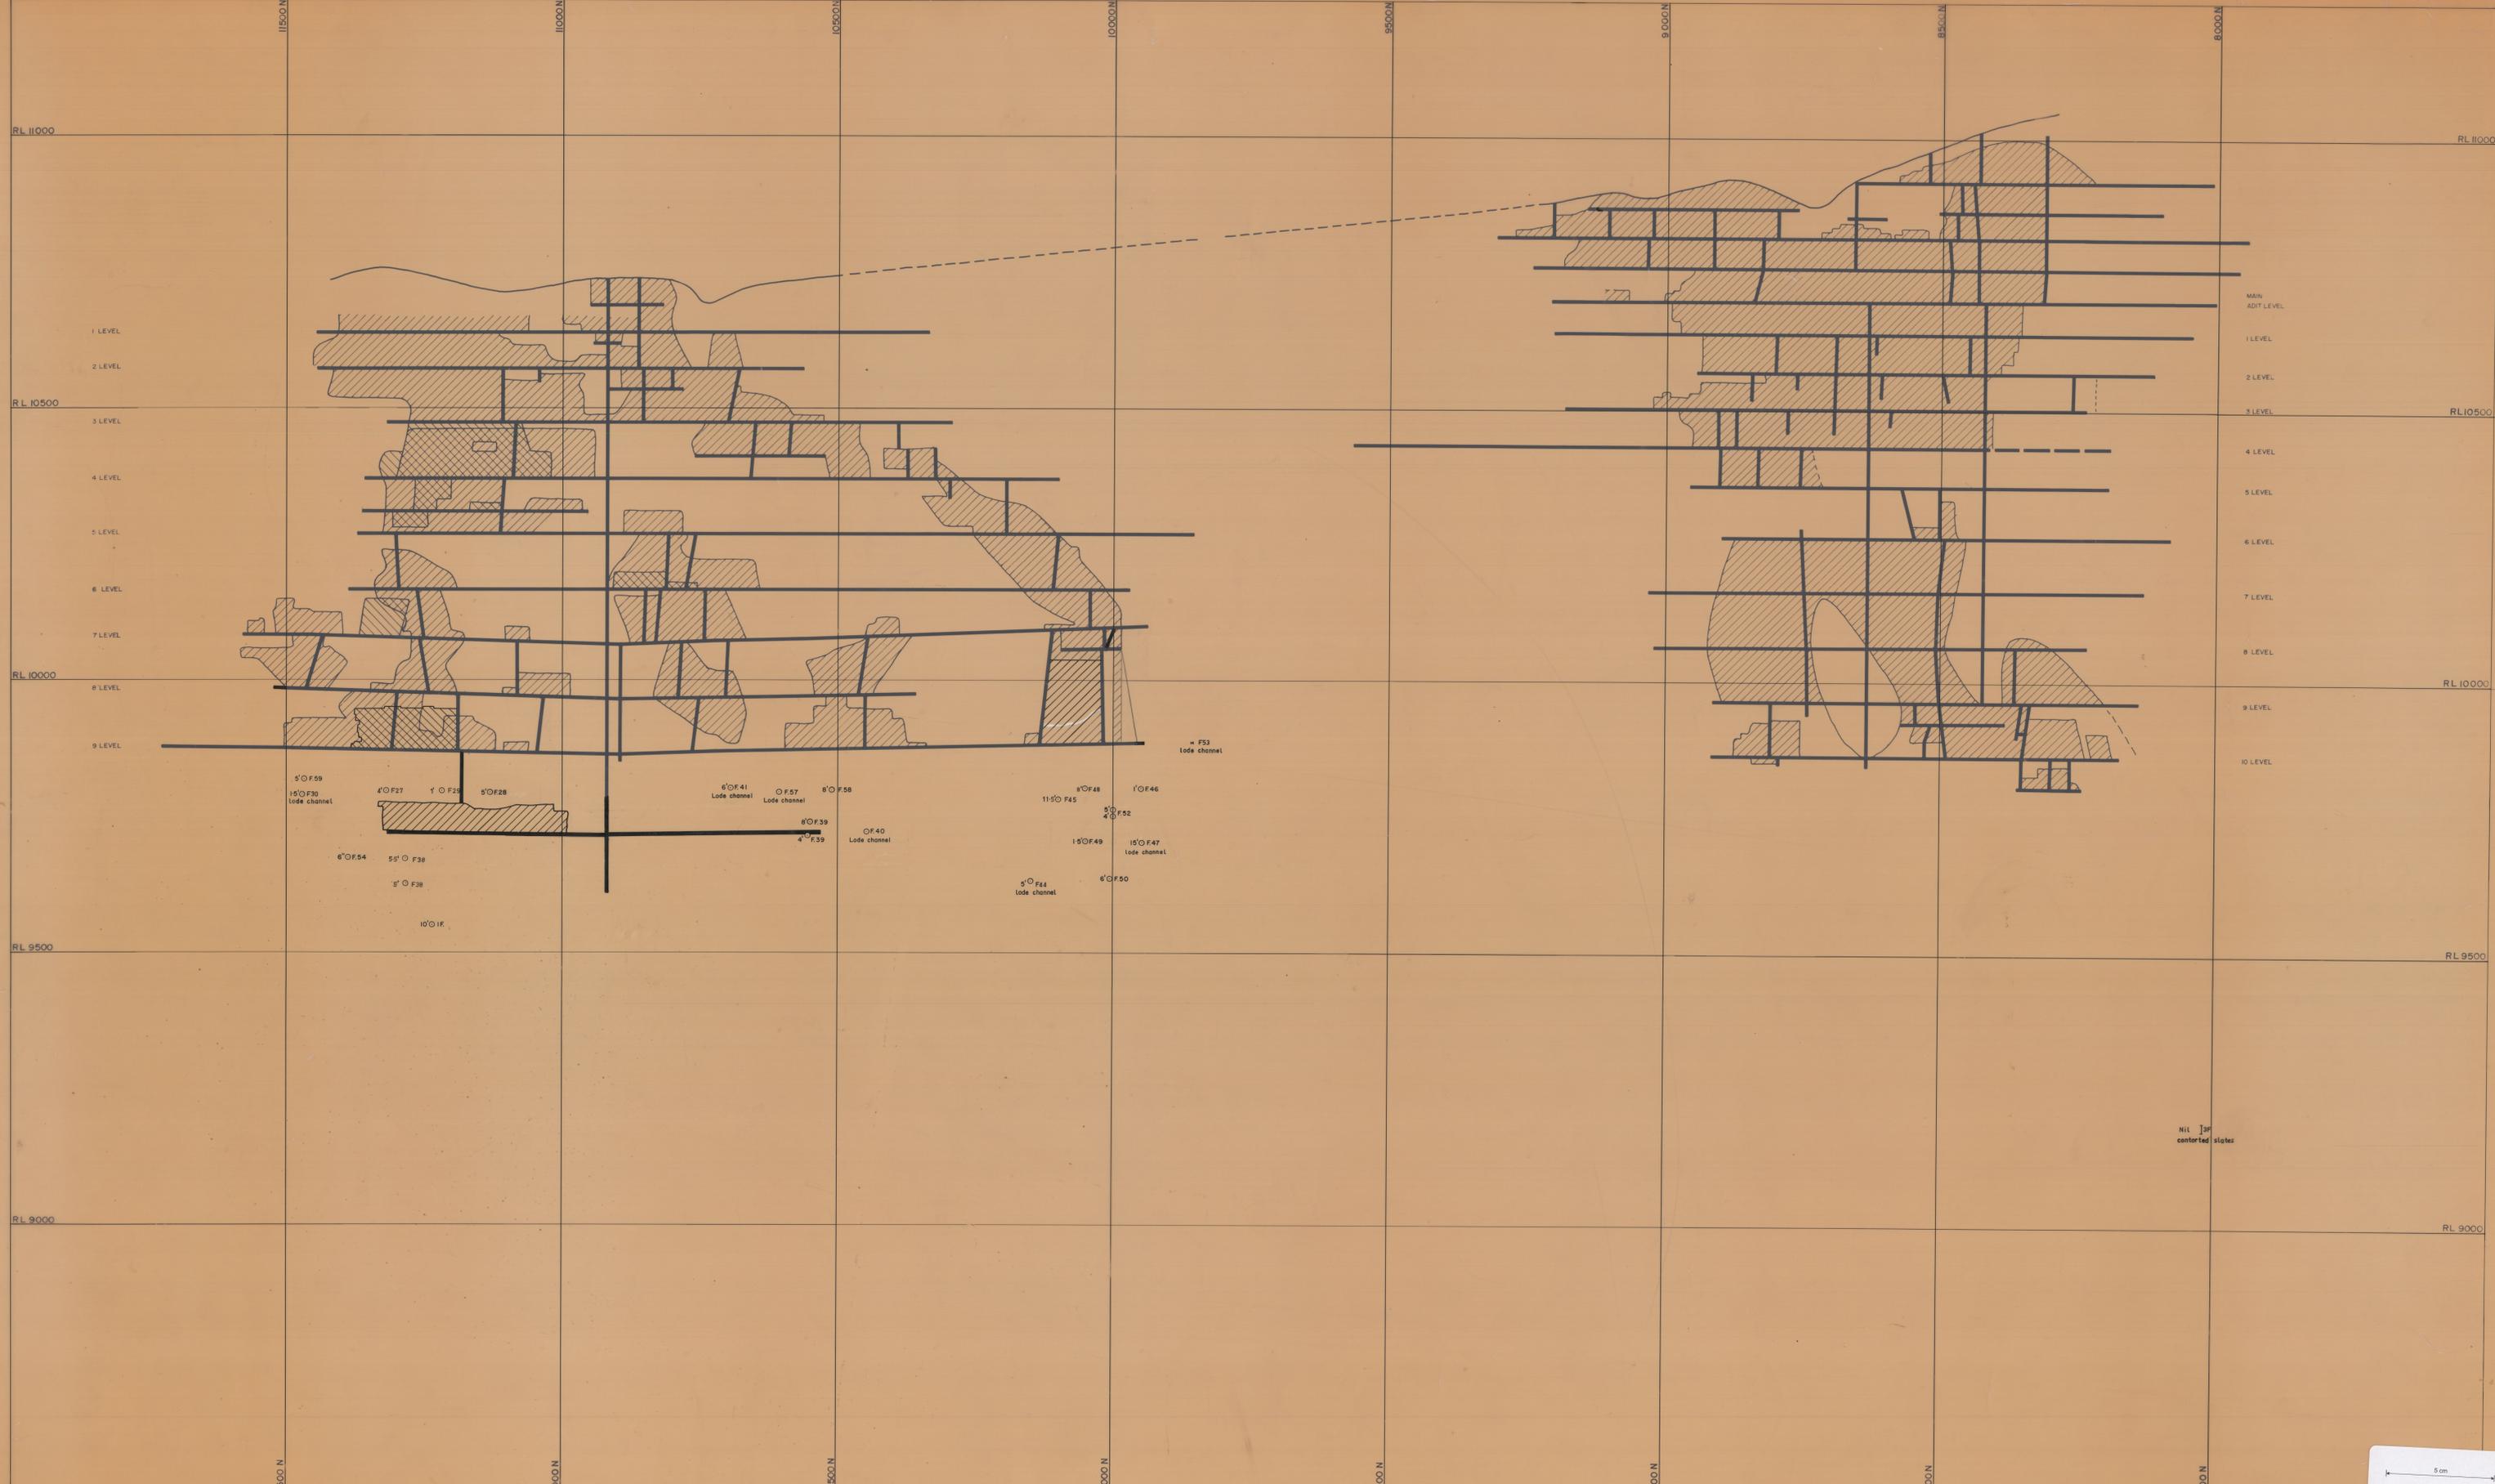

FARRELL MINE  
 LONGITUDINAL PROJECTION  
 SCALE 1" = 100'

NOTE: This plan was prepared during Sept '68 by P.A. Section below 7' level in the northern area is based on present day survey. All other sections based on old information.

Nil [?] contorted slates



ELECTROLYTIC ZINC COY OF A/ASIA LTD  
 WEST COAST MINES  
 MINING DEPARTMENT