


0061_042

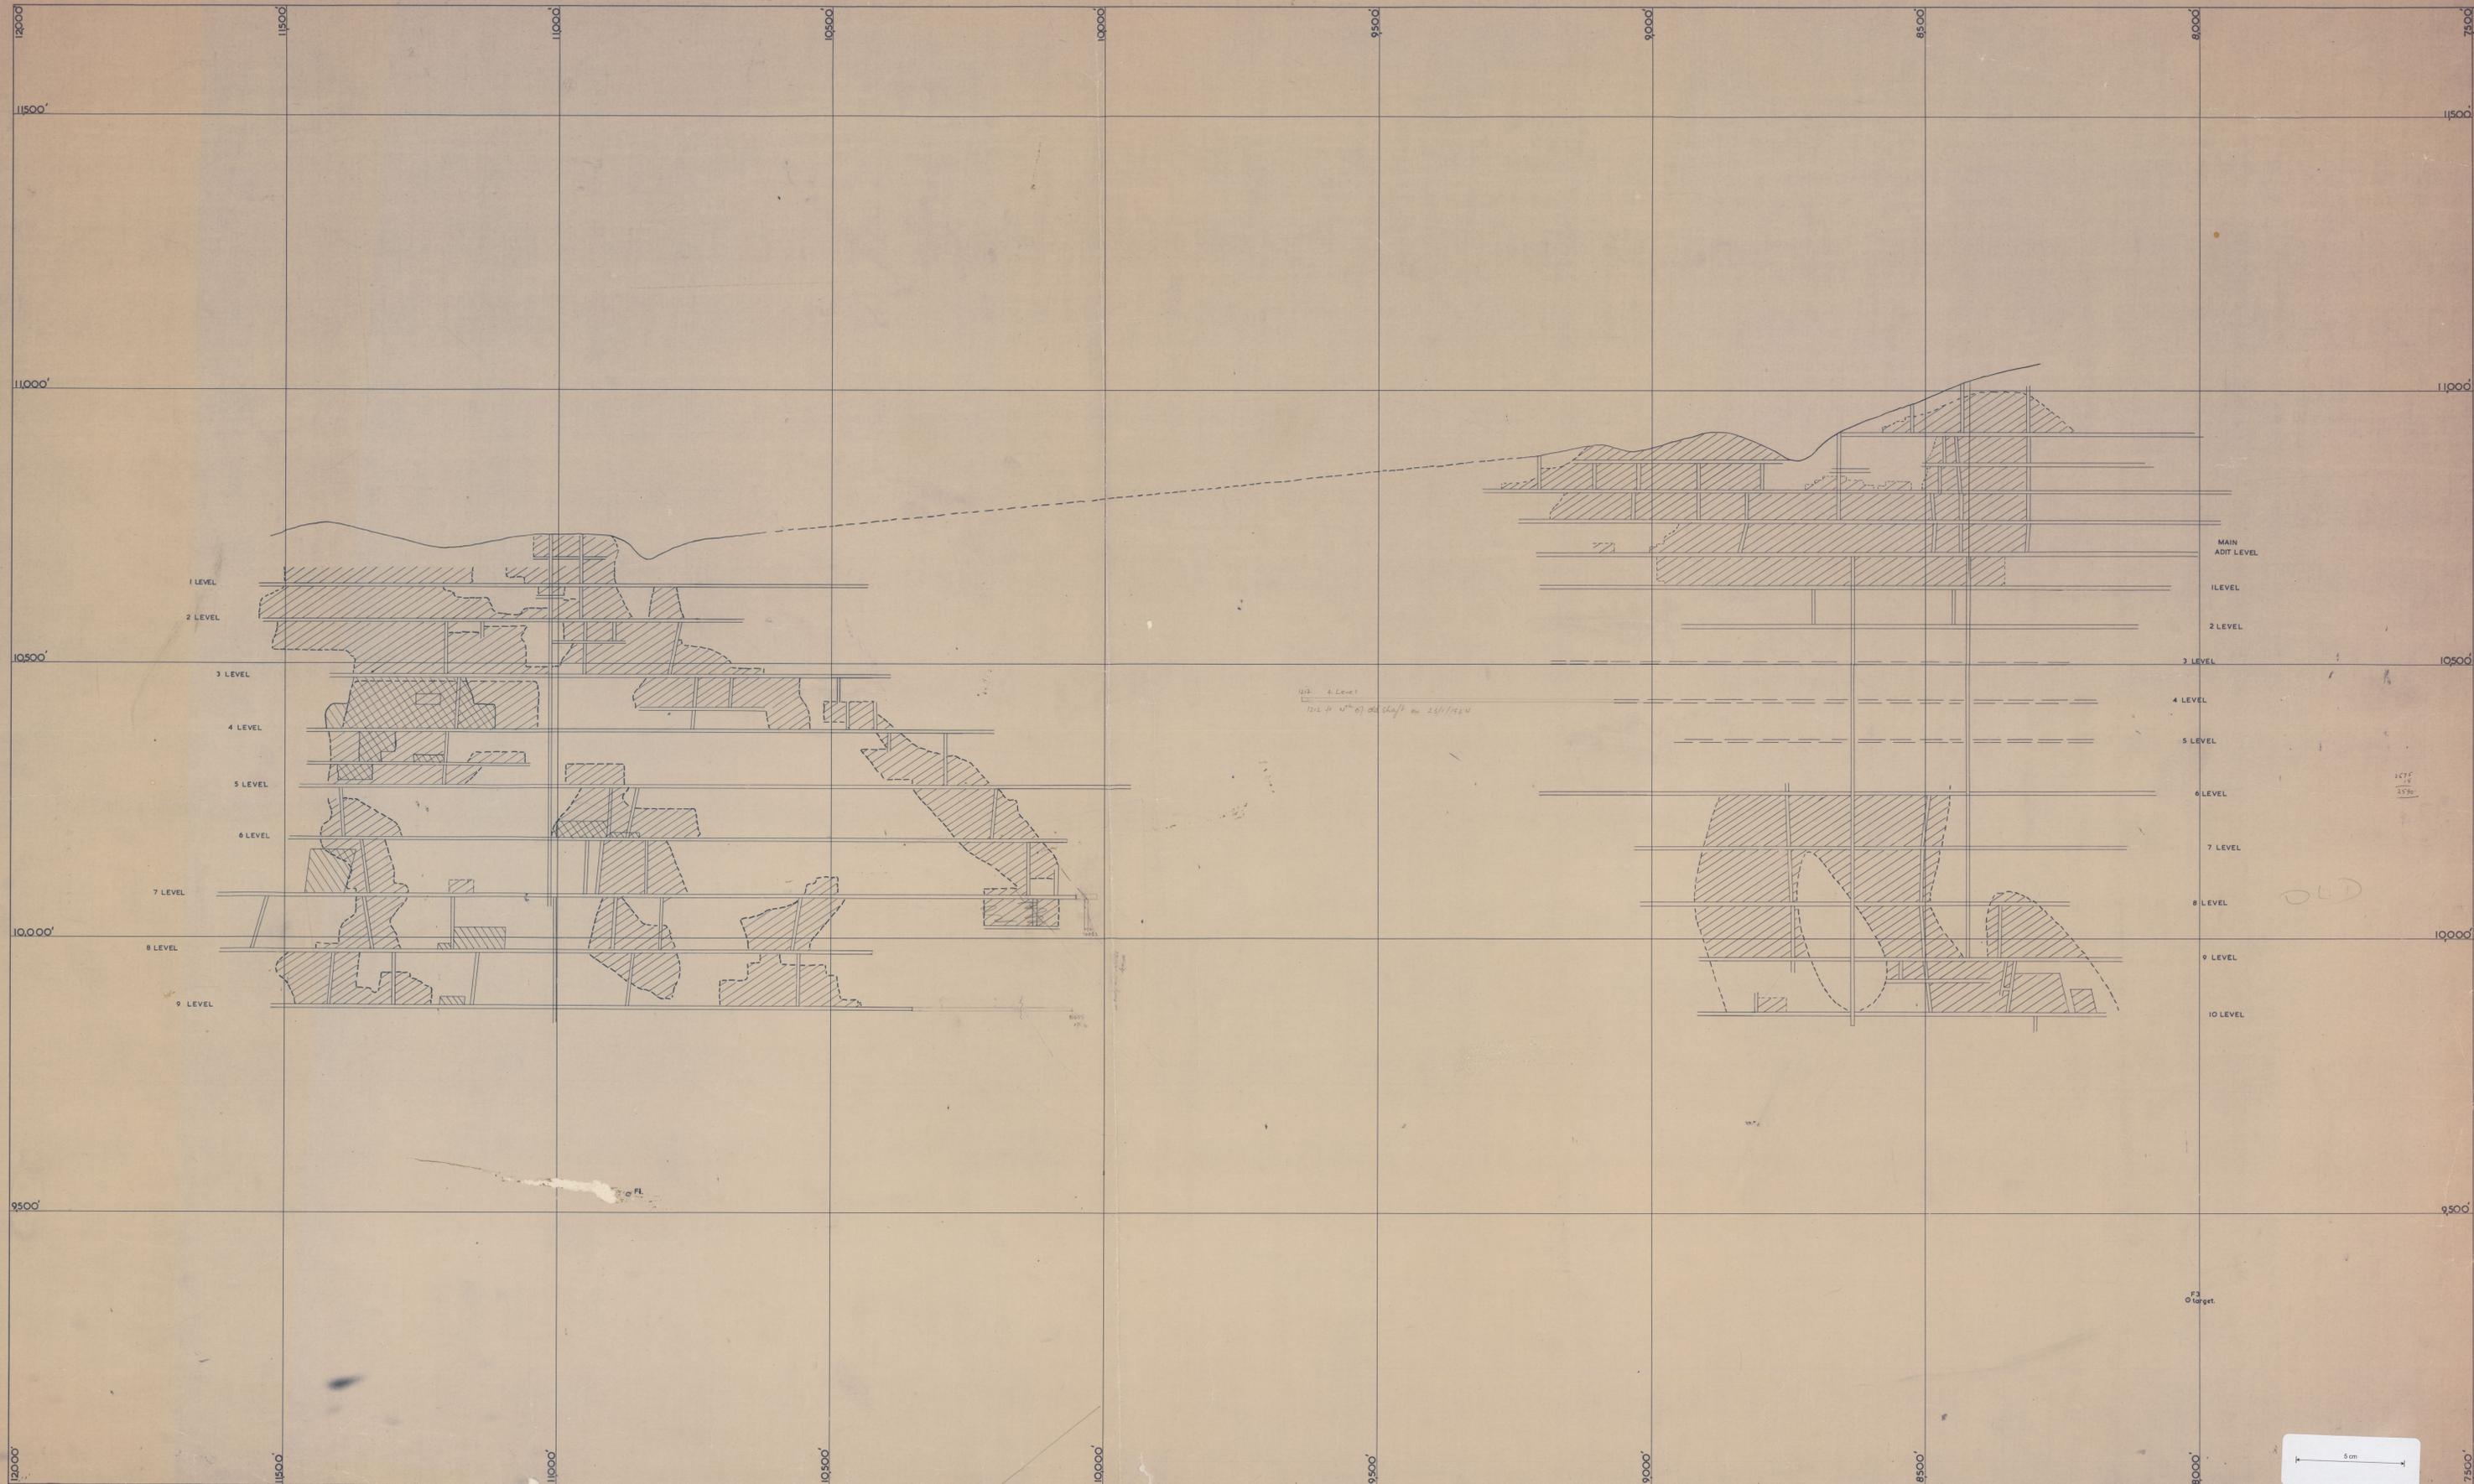

ELECTROLYTIC ZINC CO. OF A'ASIA

GEOLOGICAL DEPARTMENT

Date: Copy for:

NORTH MOUNT FARRELL MINE
NEW NORTH MOUNT FARRELL MINE

Nº 3 LOD

Scale: 1" = 100'

LONGITUDINAL PROJECTION