


0061_050

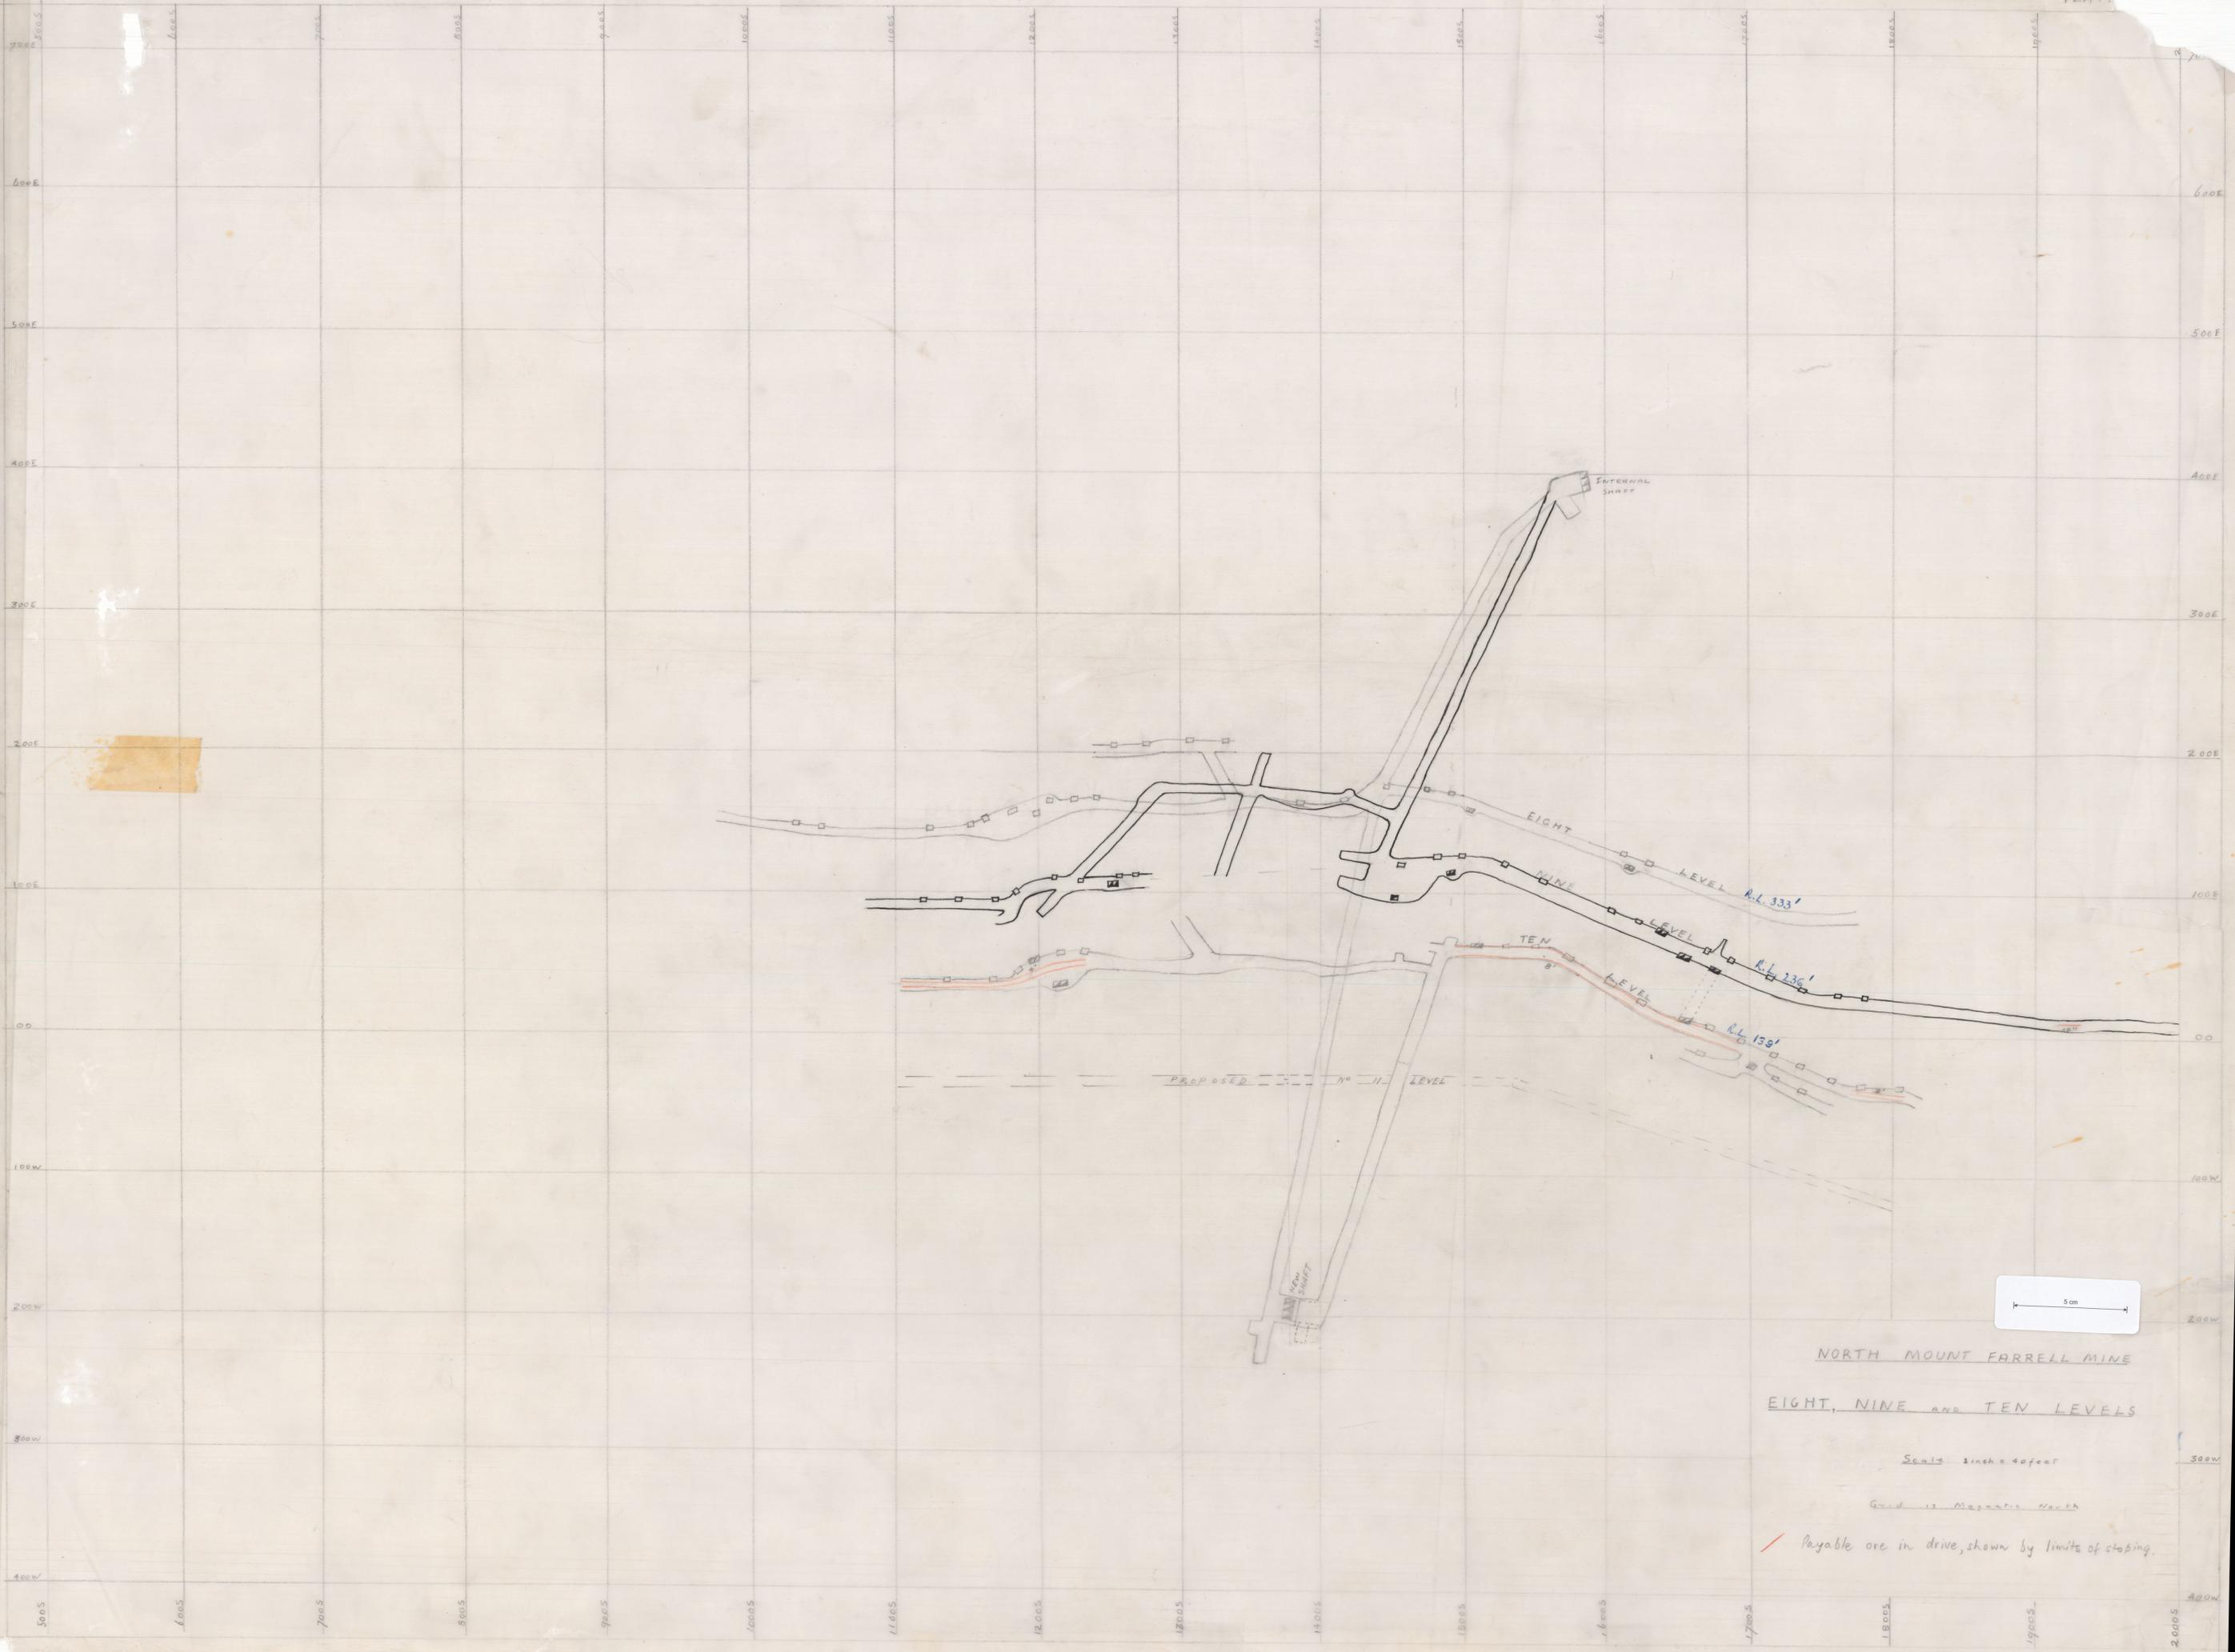

NORTH MOUNT FARRELL MINE
EIGHT, NINE and TEN LEVELS

Scale: 1 inch = 40 feet

Grid is Magnetic North

Payable ore in drive, shown by limits of stoping.