


0061_051

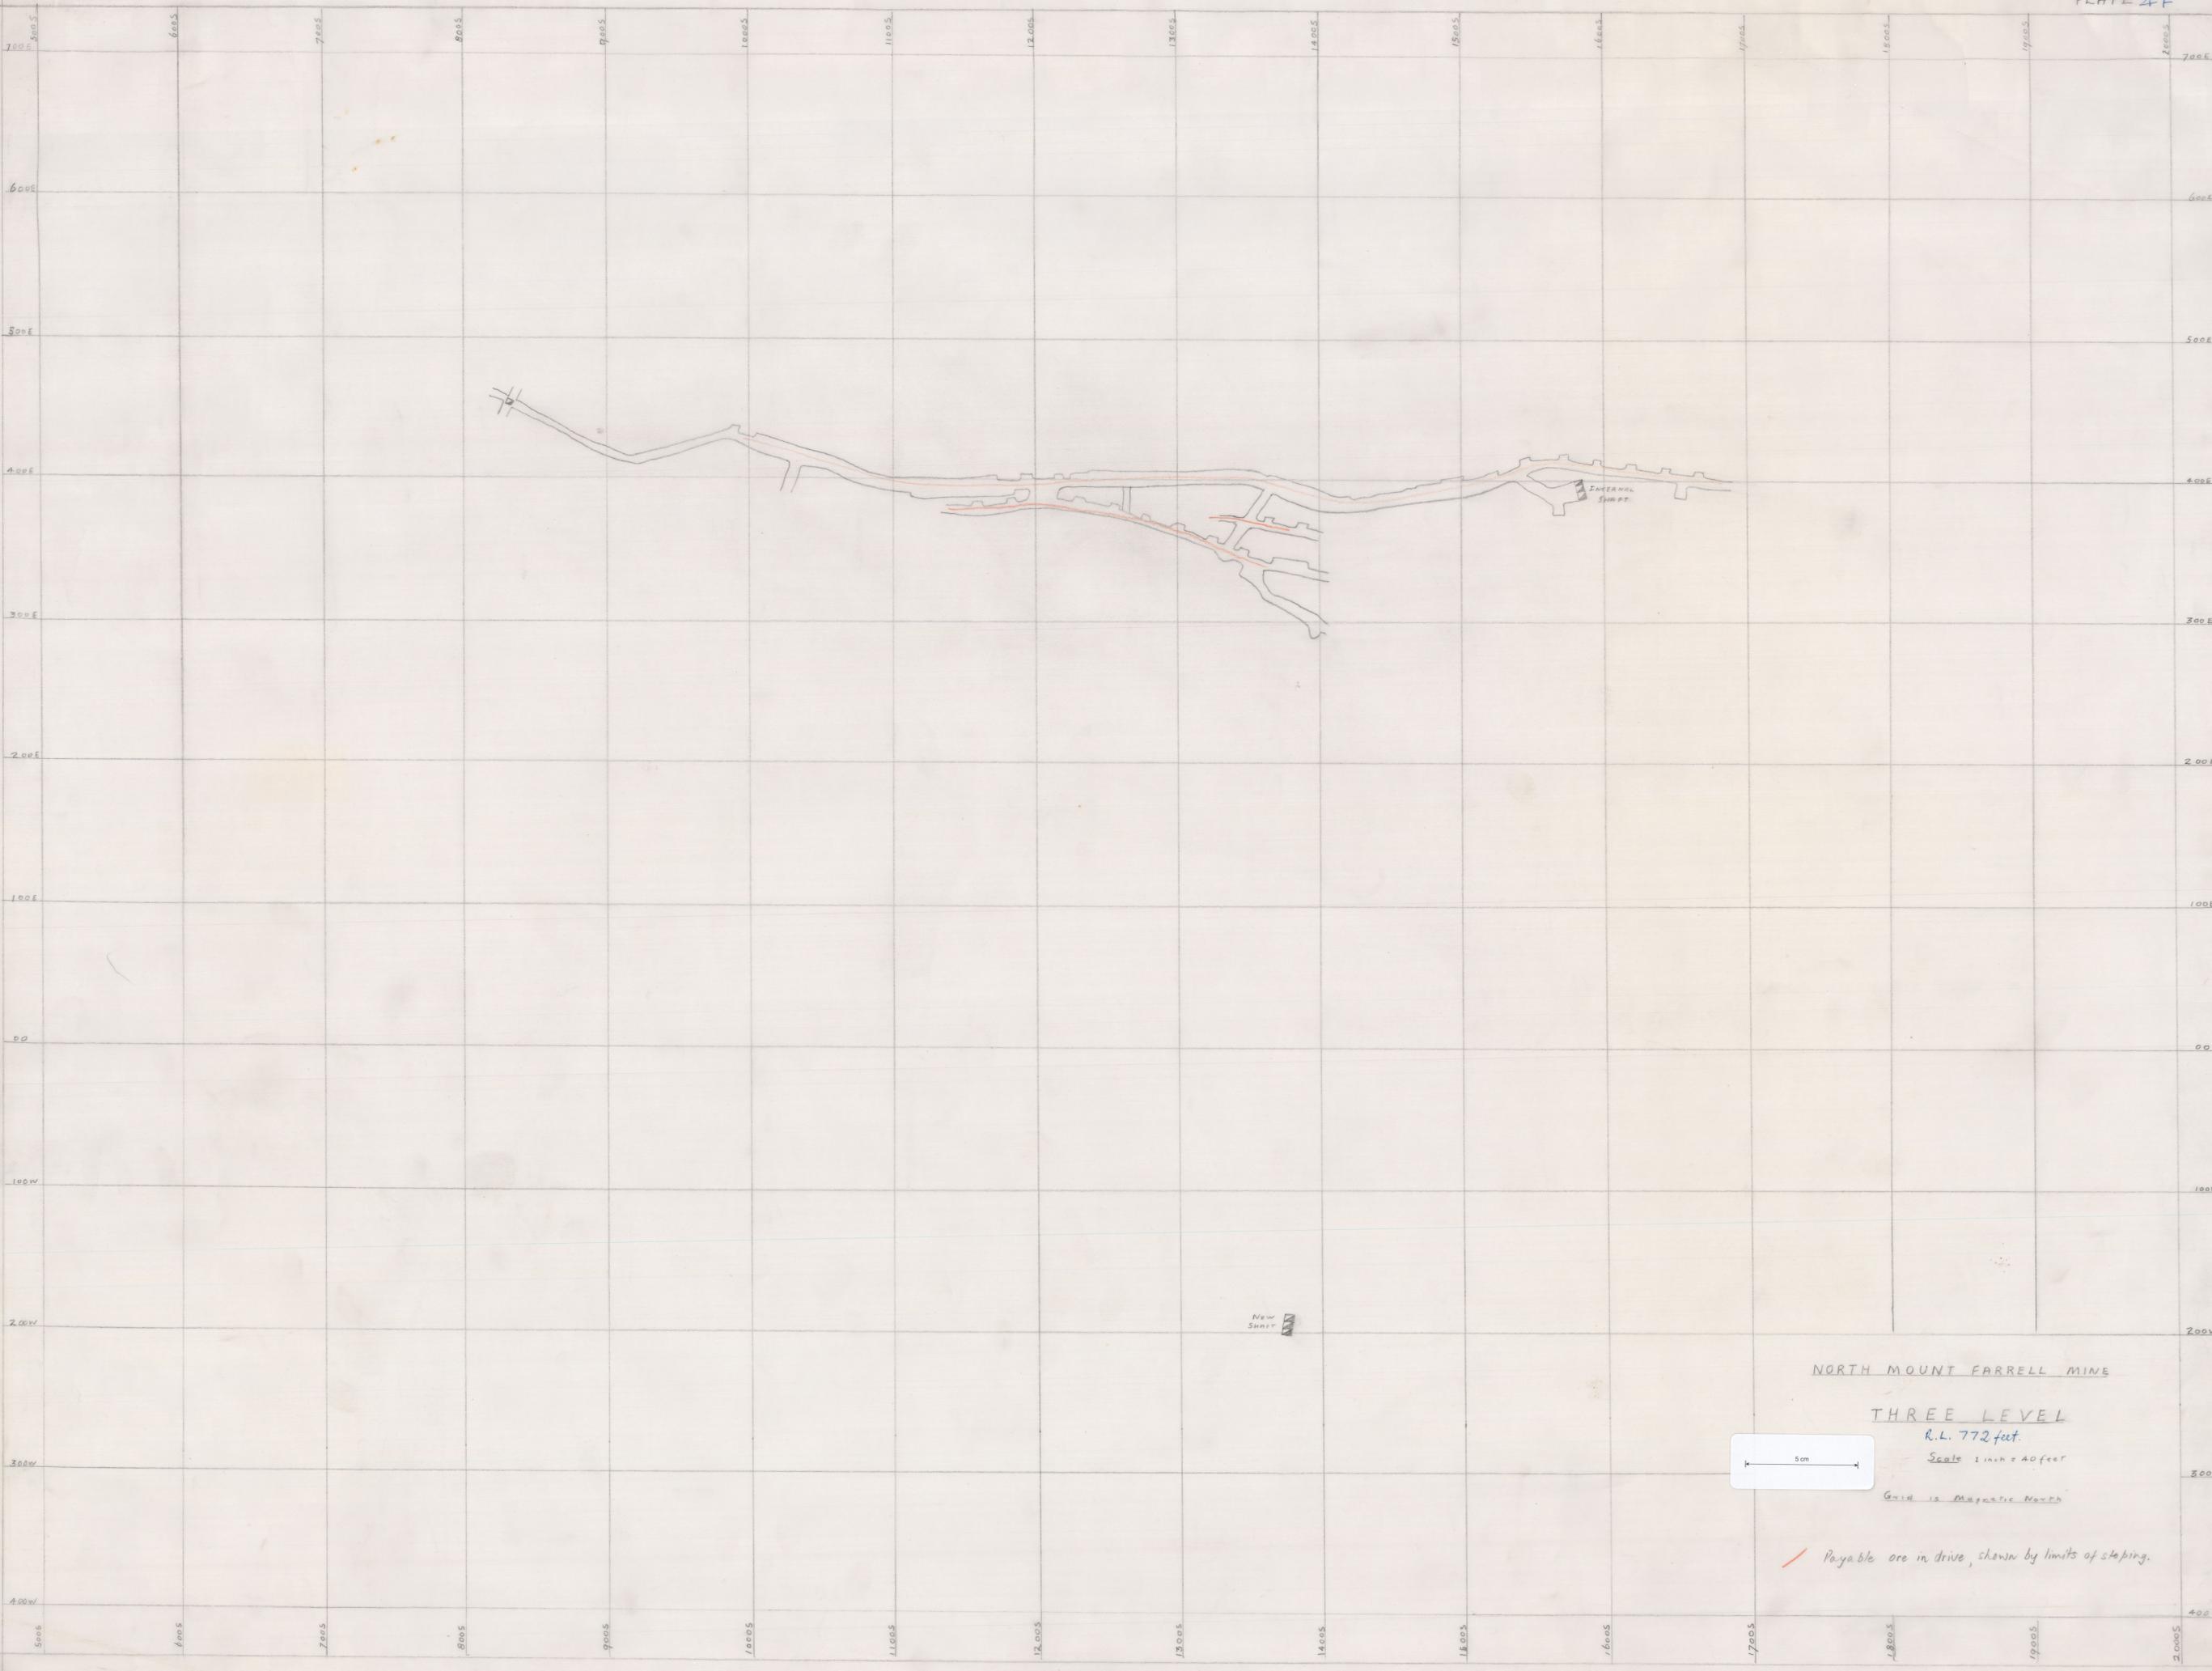

NORTH MOUNT FARRELL MINE

THREE LEVEL

R.L. 772 feet.

Scale 1 inch = 40 feet

Grid is Magnetic North



Payable ore in drive, shown by limits of stoping.