


0061_052

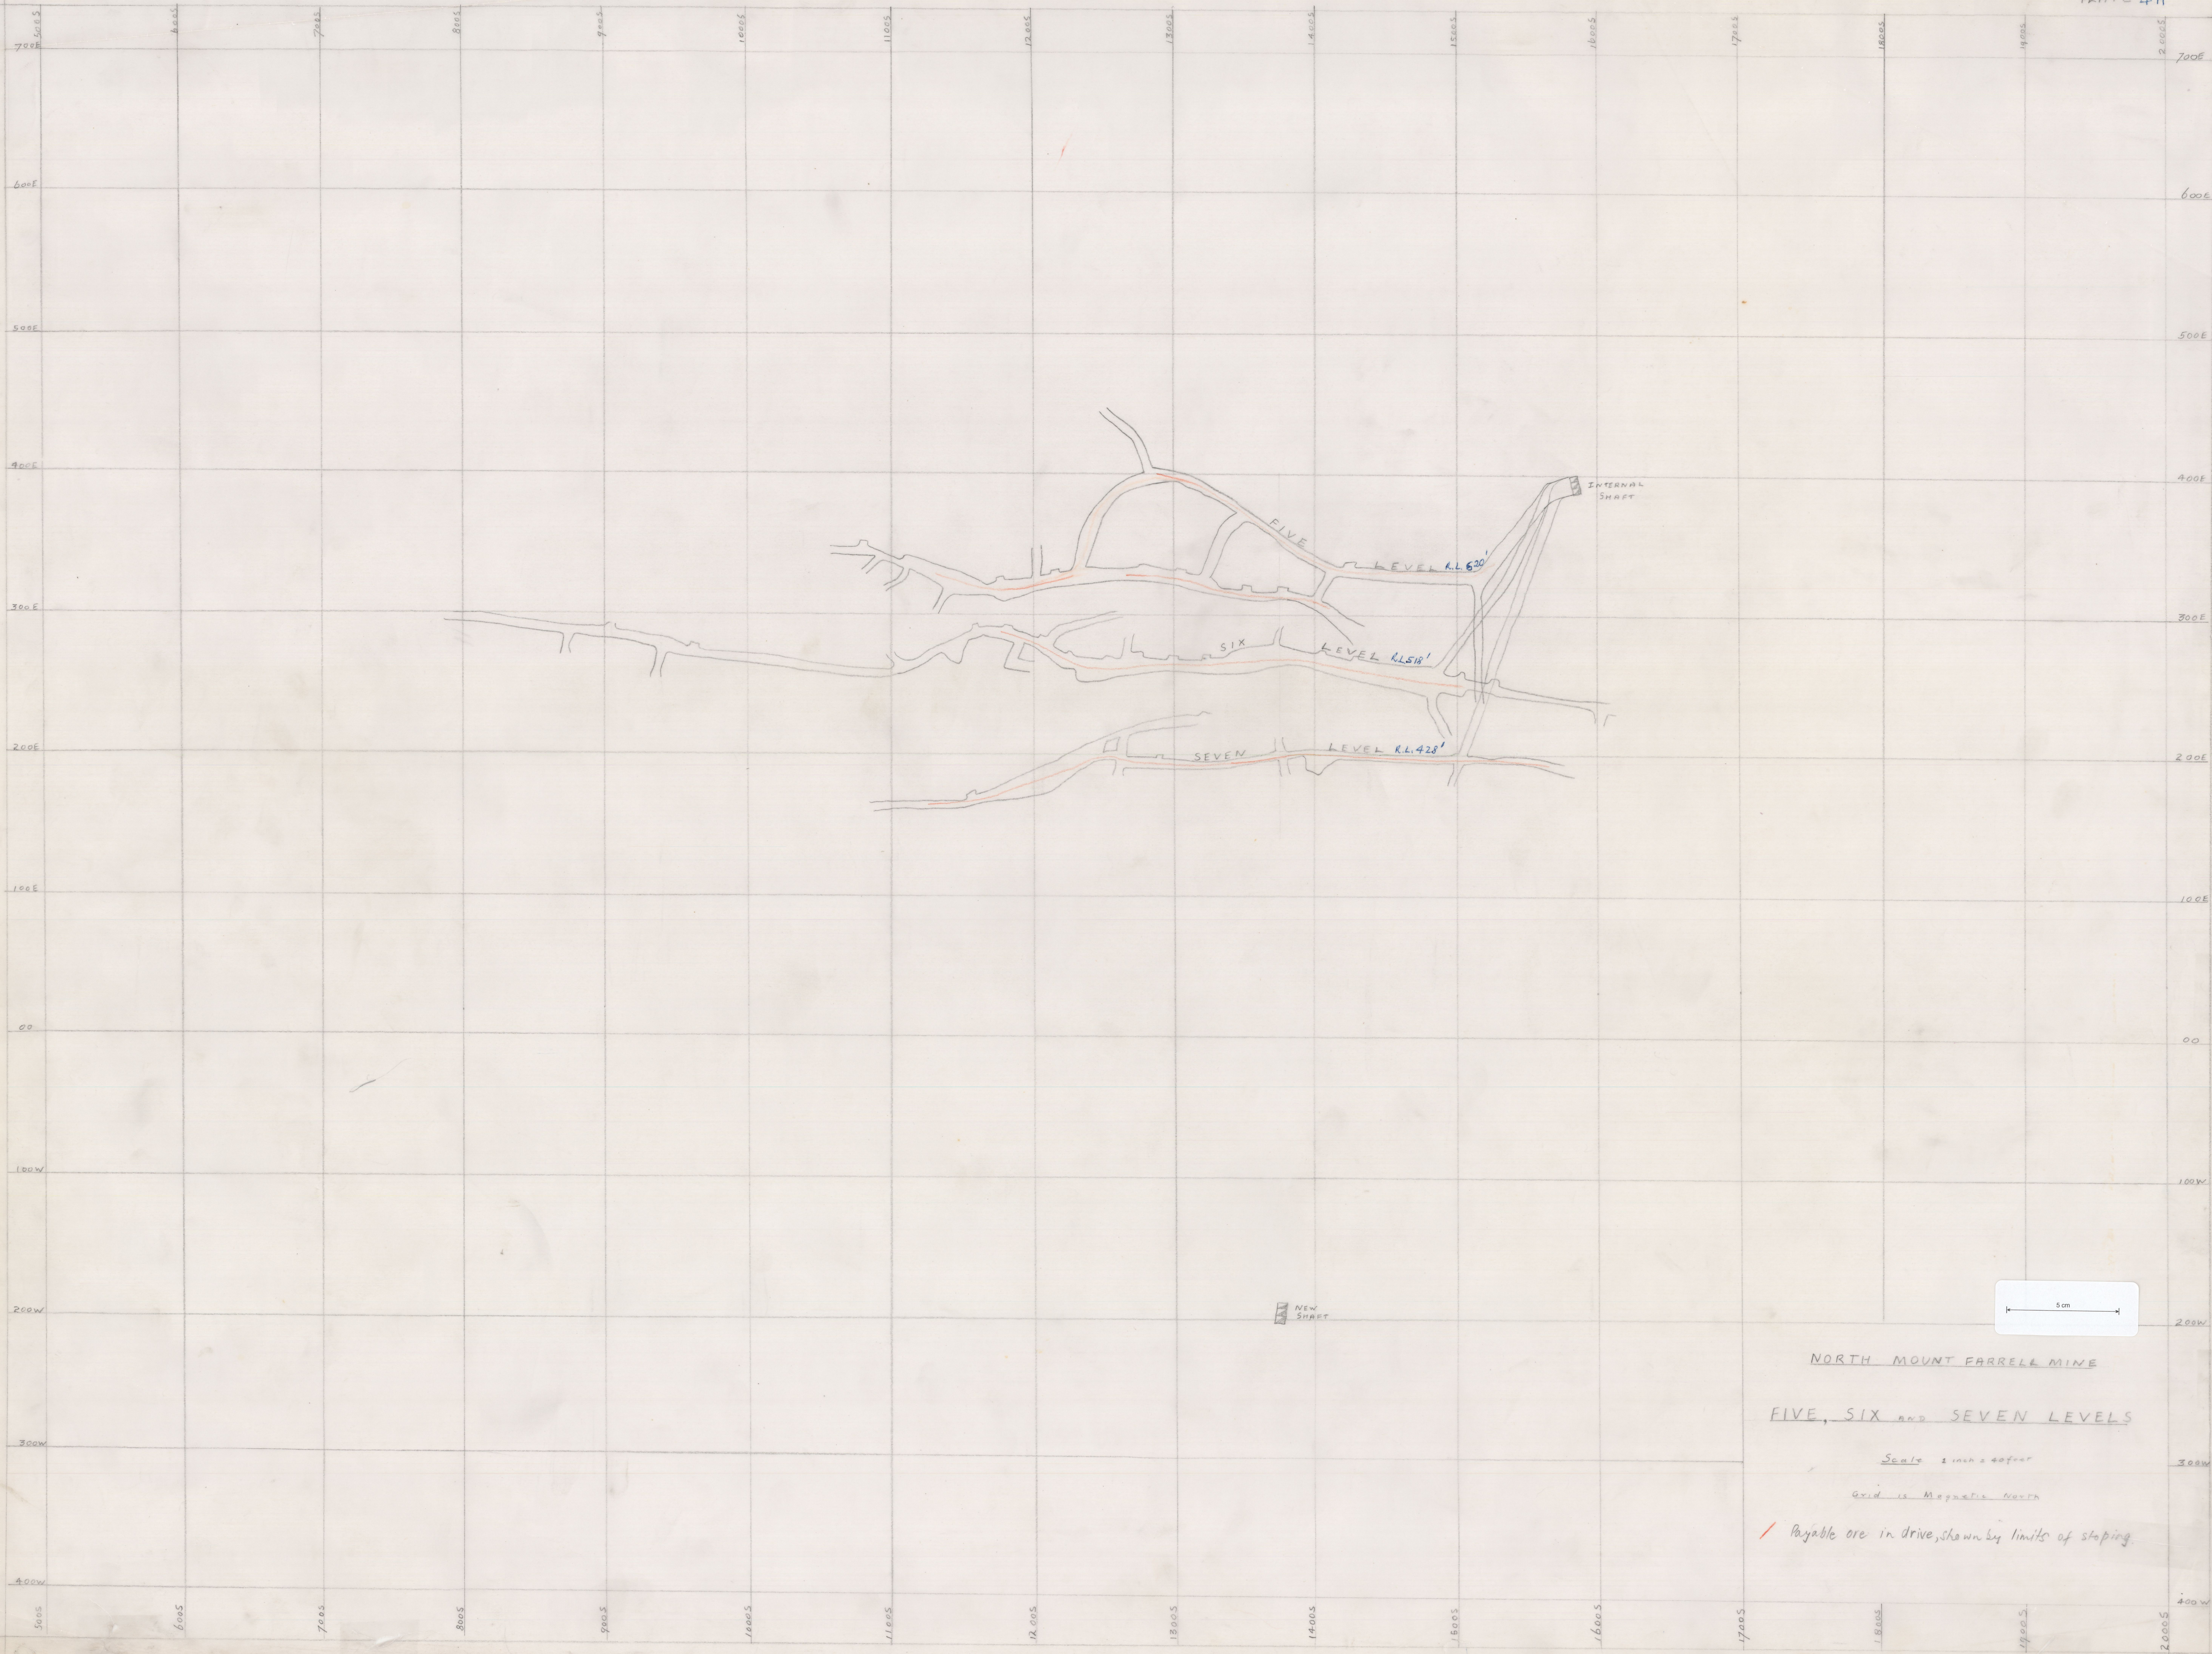

NORTH MOUNT FARRELL MINE

FIVE, SIX AND SEVEN LEVELS

Scale 1 inch = 40 feet

Grid is Magnetic North

/ Payable ore in drive, shown by limits of stoping.