


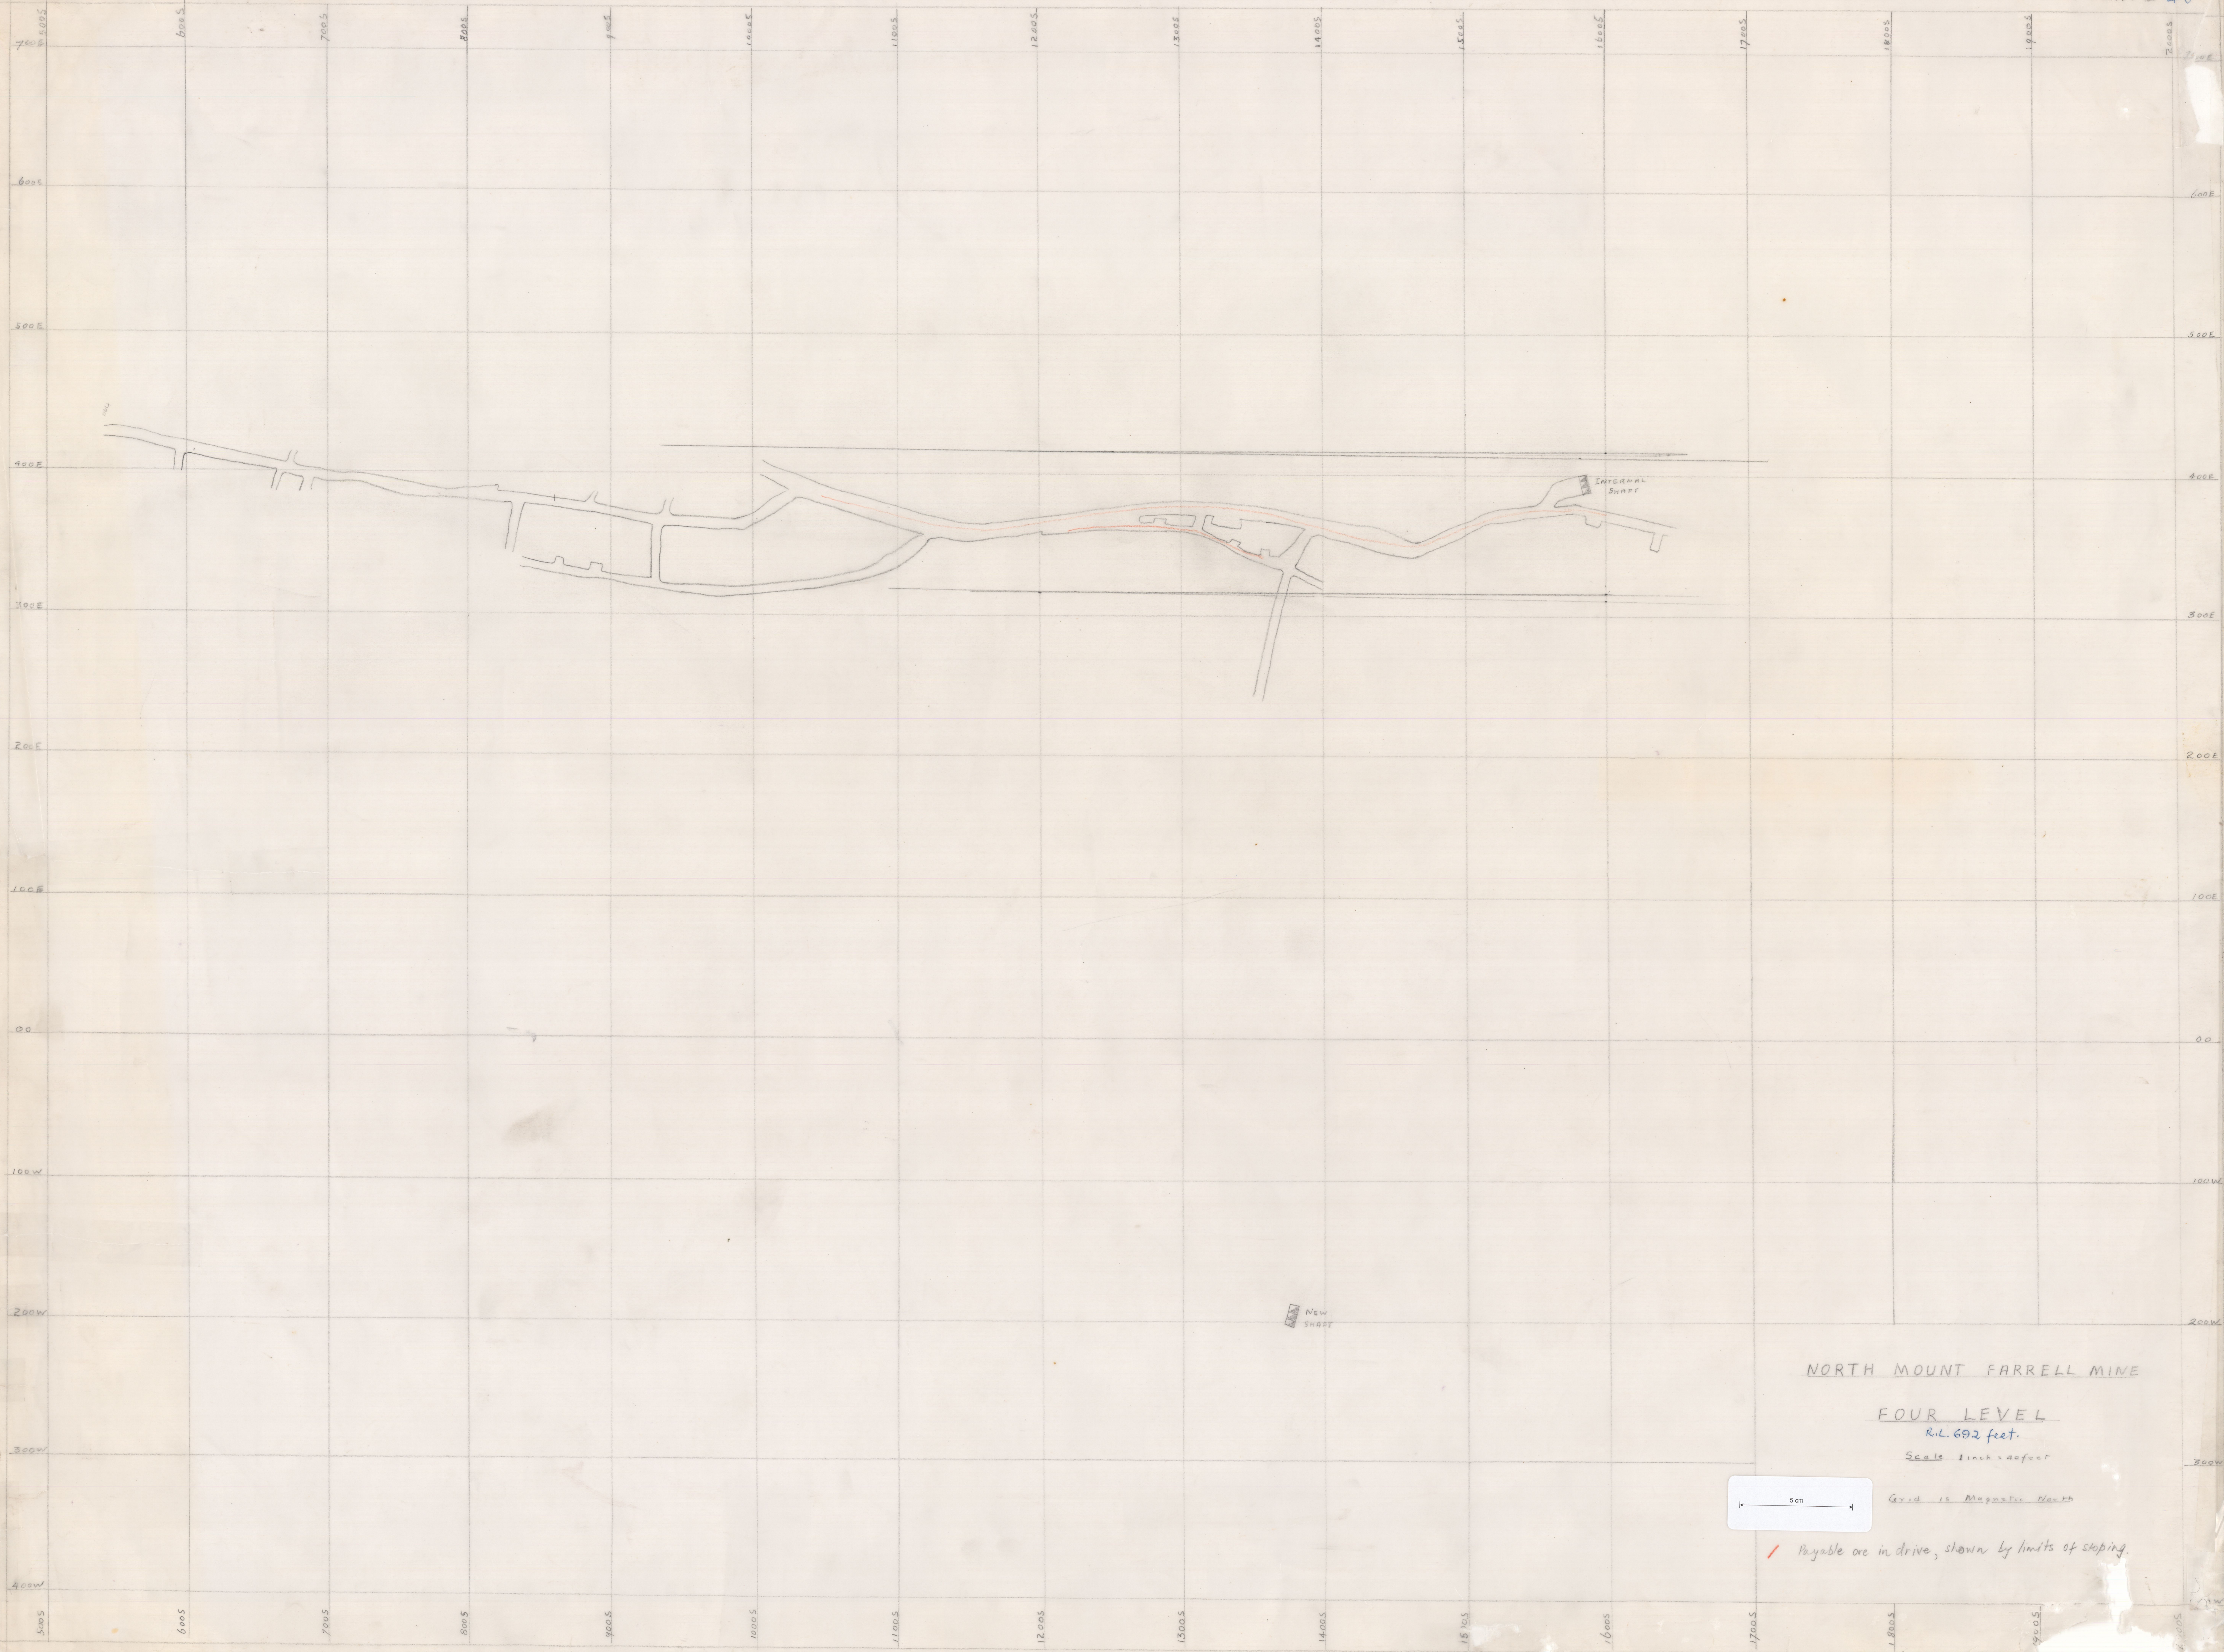

NORTH MOUNT FARRELL MINE

FOUR LEVEL

R.L. 692 feet.

Scale 1 inch = 20 feet

Grid is Magnetic North

/ Payable ore in drive, shown by limits of staking.

0061_056