


0061_074

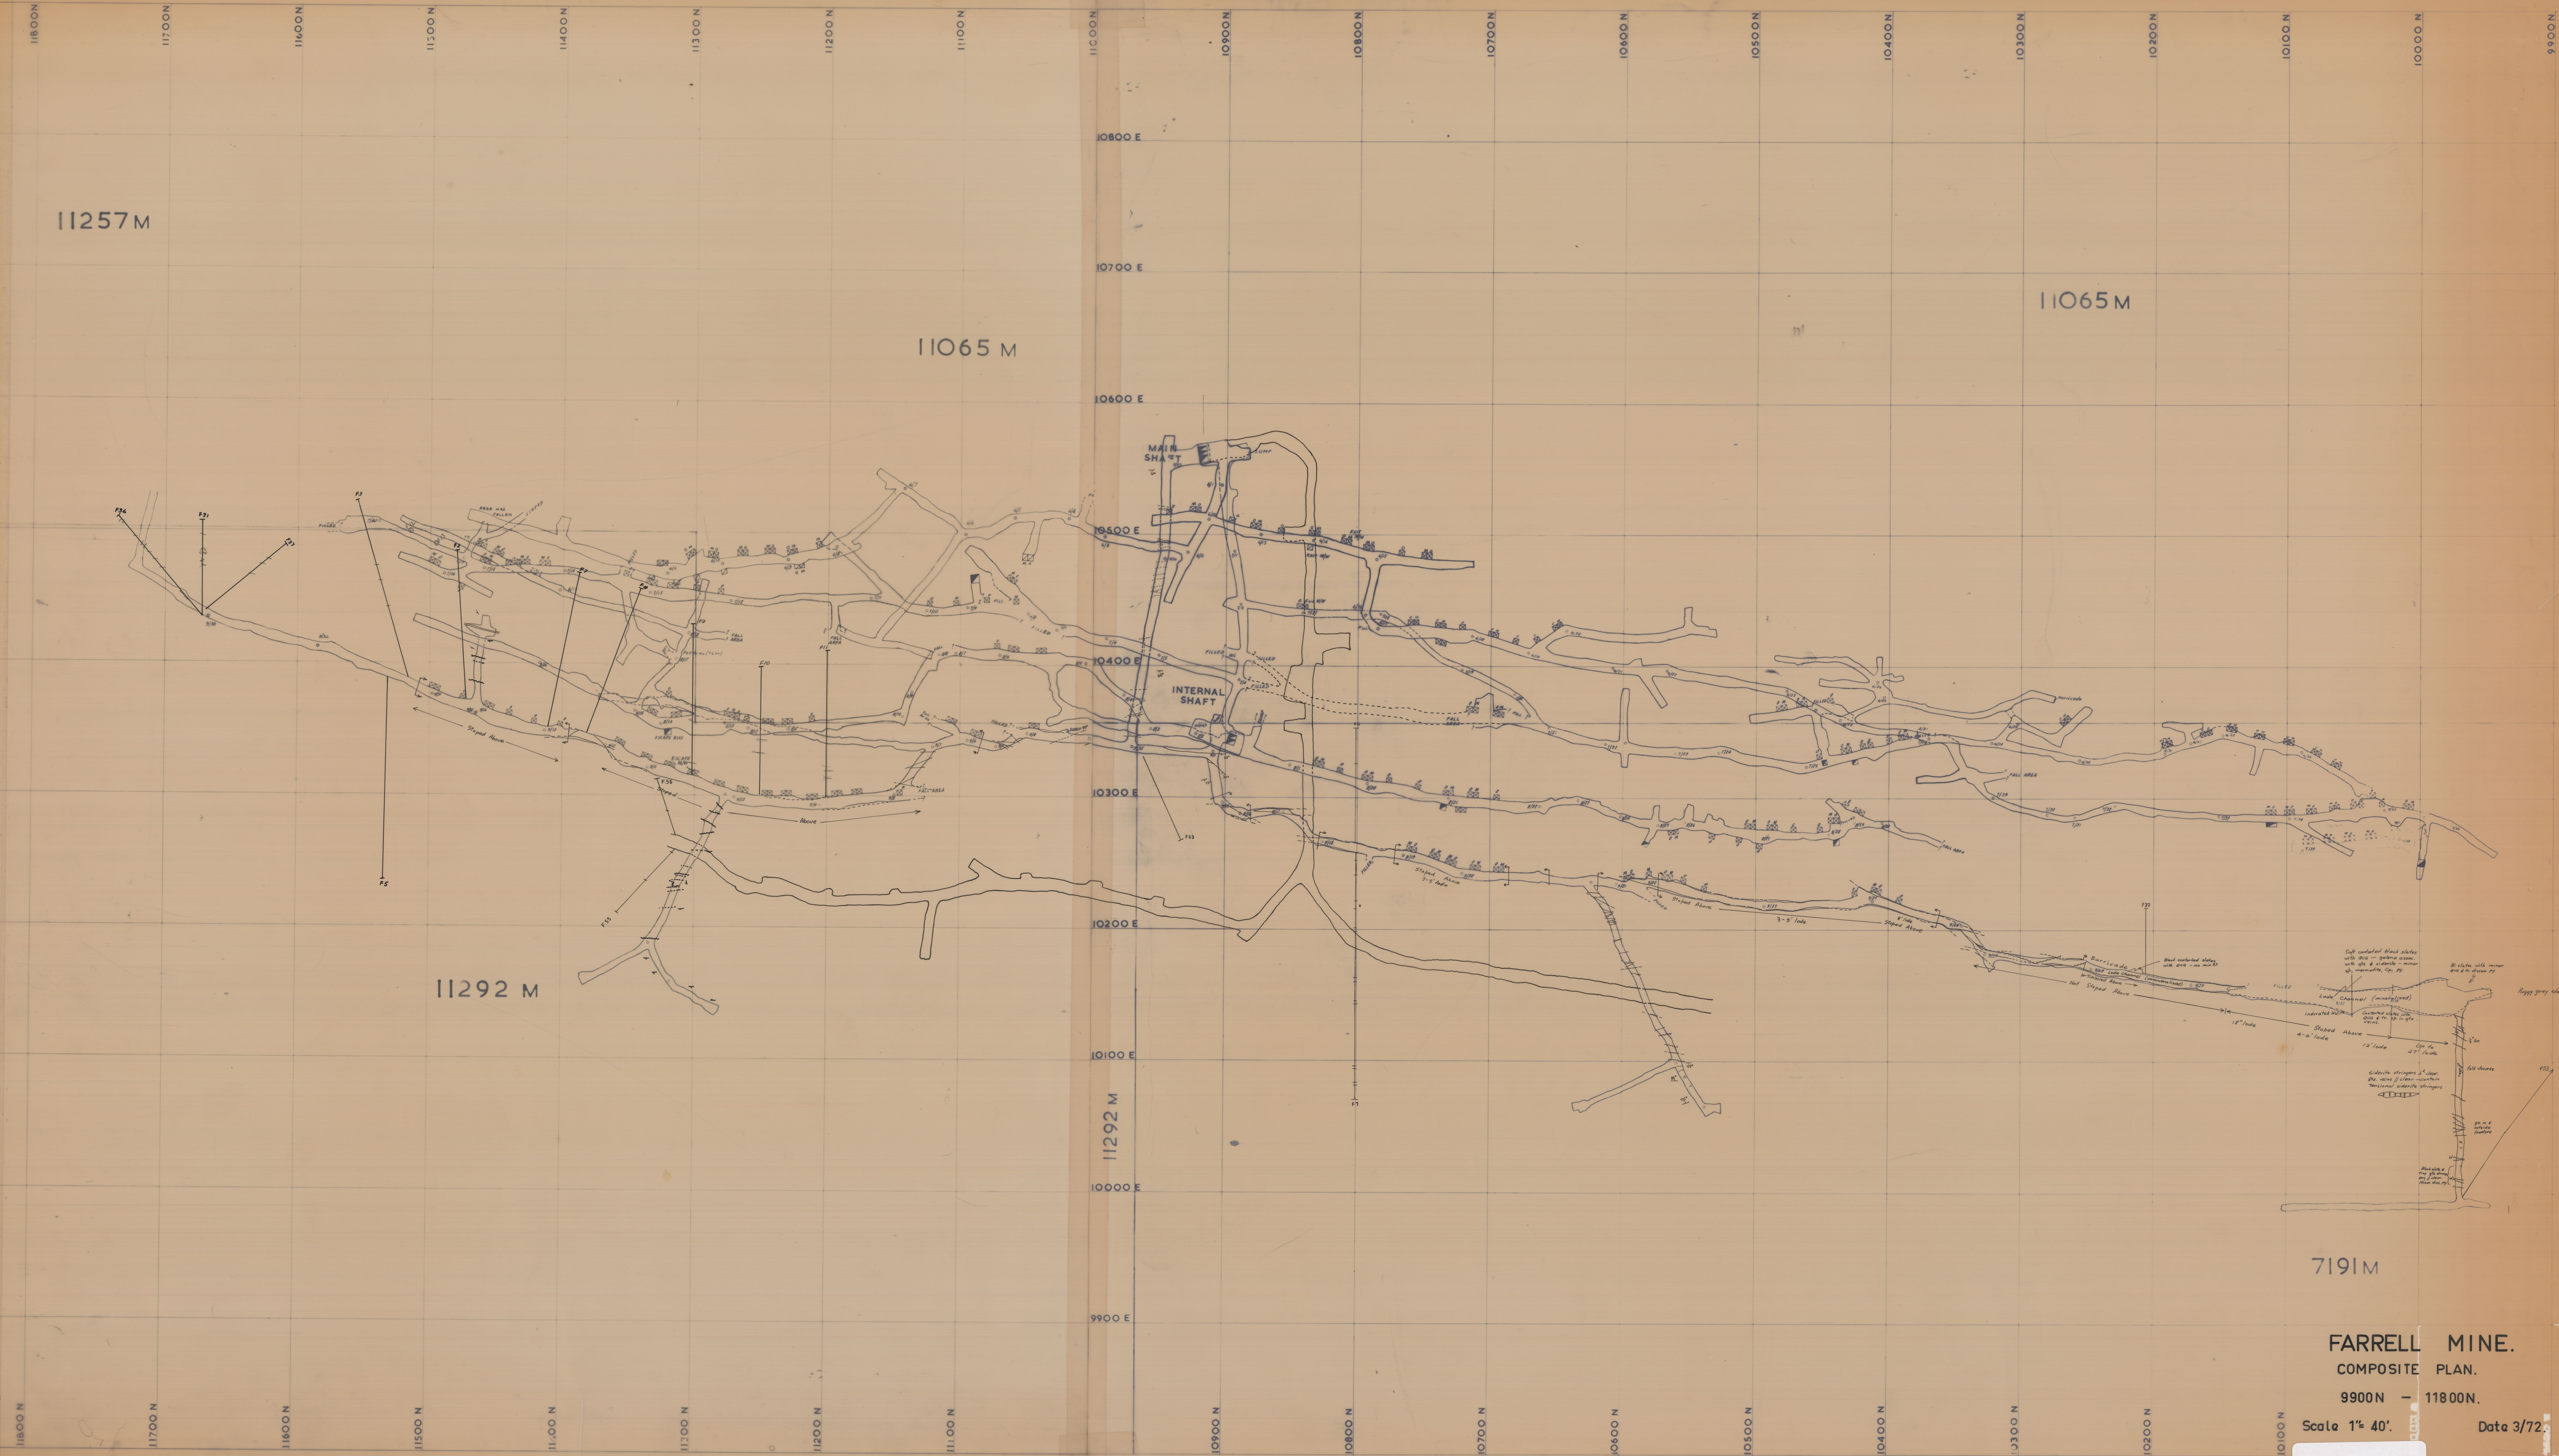

FARRELL MINE.
COMPOSITE PLAN.
9900 N - 11800 N.