


62-05

5 cm

62-05

DALMAYNE COLLIERY

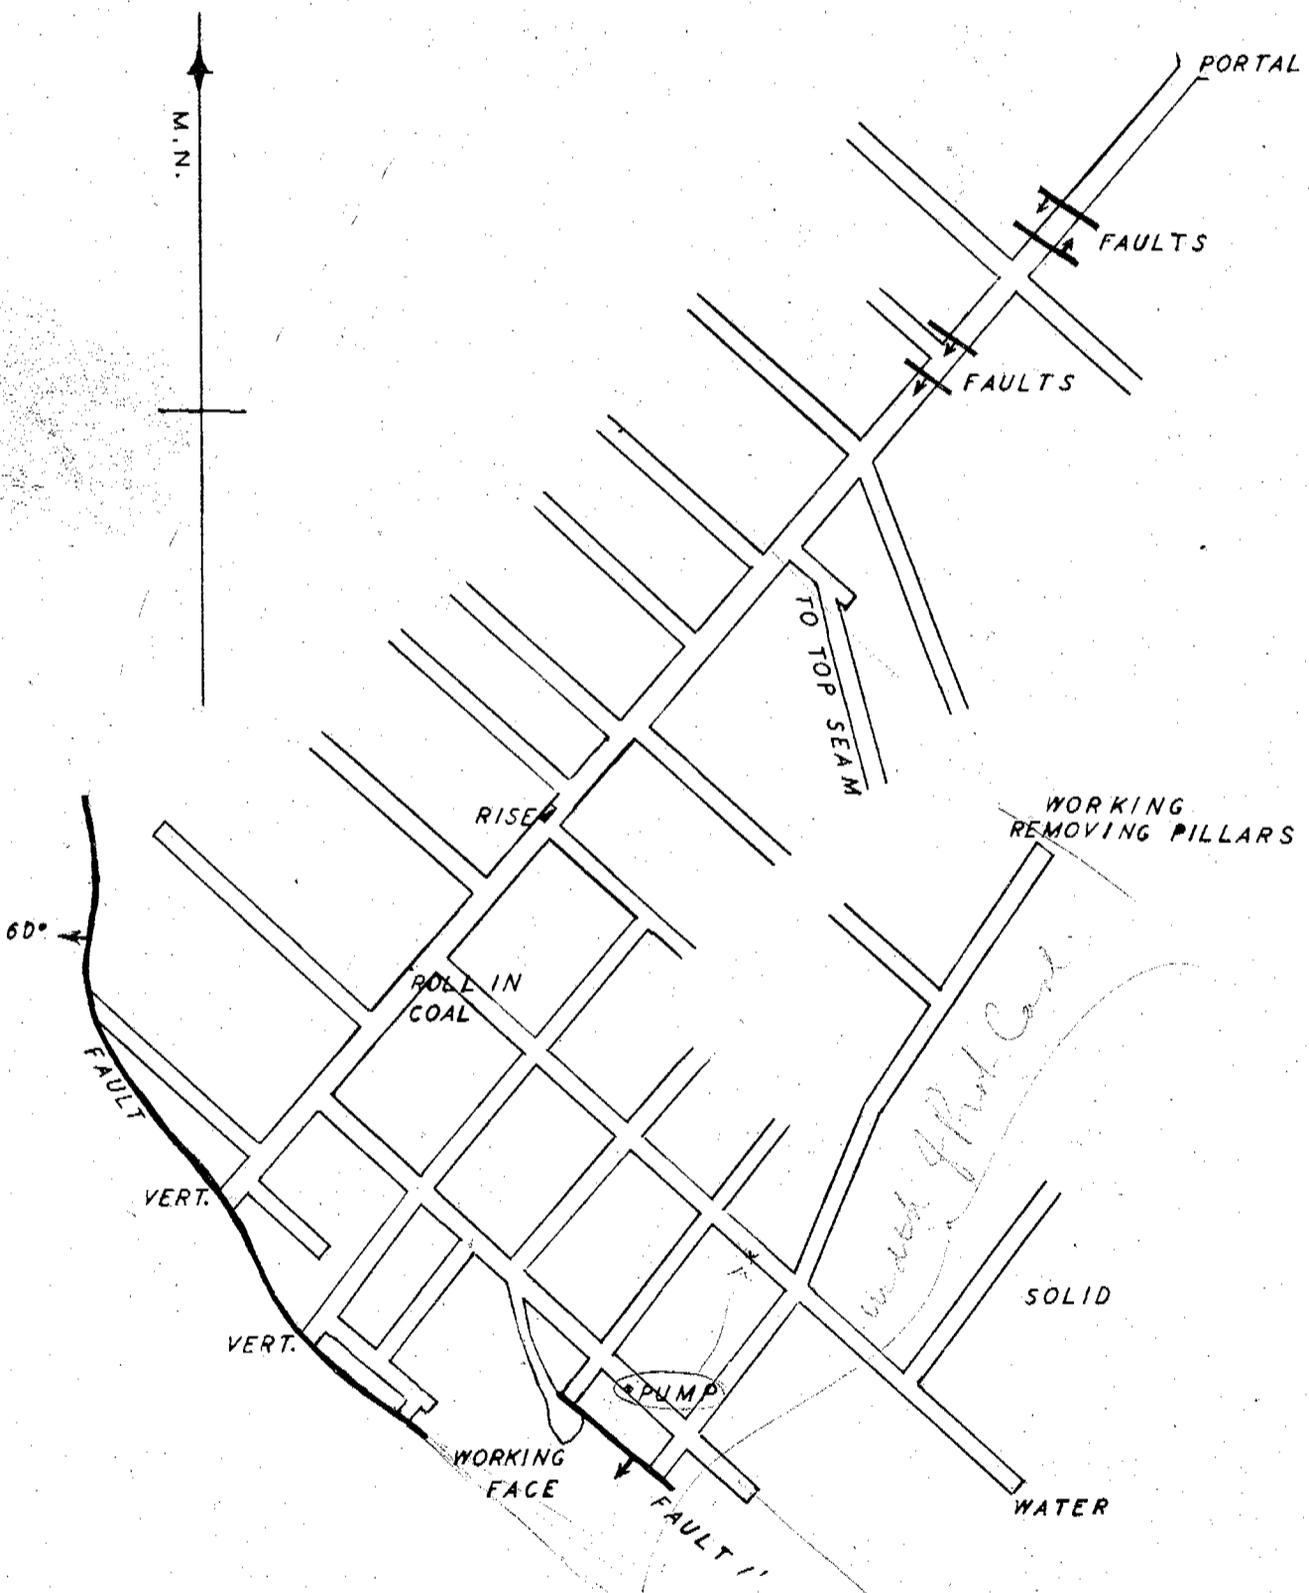

H. G. Heid M. SC.
 CHIEF GEOLOGIST
 11-3-48.

1040-30