DALMAYNE COLLIERY

Scale 1 chain to 1 inch.

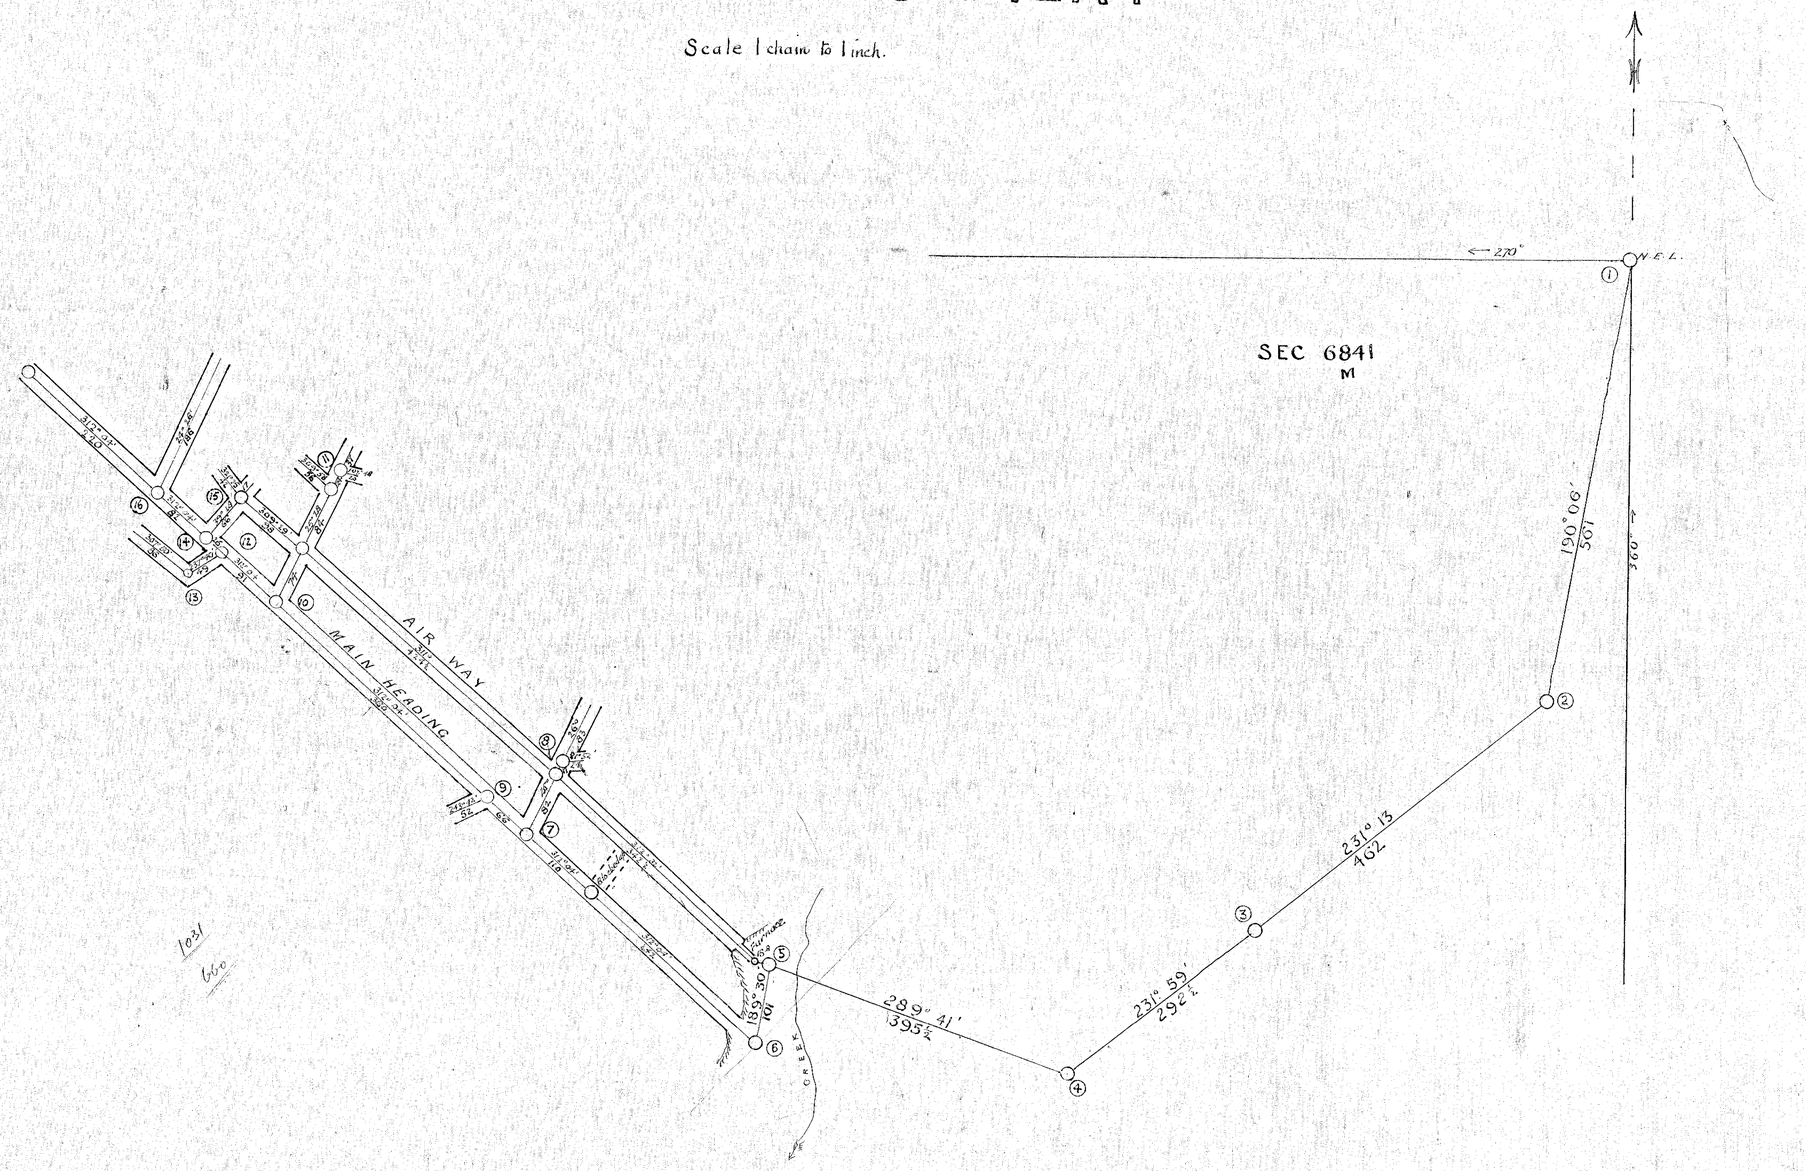
N
N.E.L.
270°
SEC 6841
M
190° 06'
561
360°
231° 13'
462
231° 59'
292½
289° 41'
395½
CREEK
AIR WAY
MAIN HEADING
Furnace
