101-10

101-10

TASMAN AND CROWN LYELL EXTENDED MINES NO LIA.

EXTENSIONS FOR YEAR 1911

SCALE AN INCH = 30 FEET

Charles L. Cook
18th March 1917.

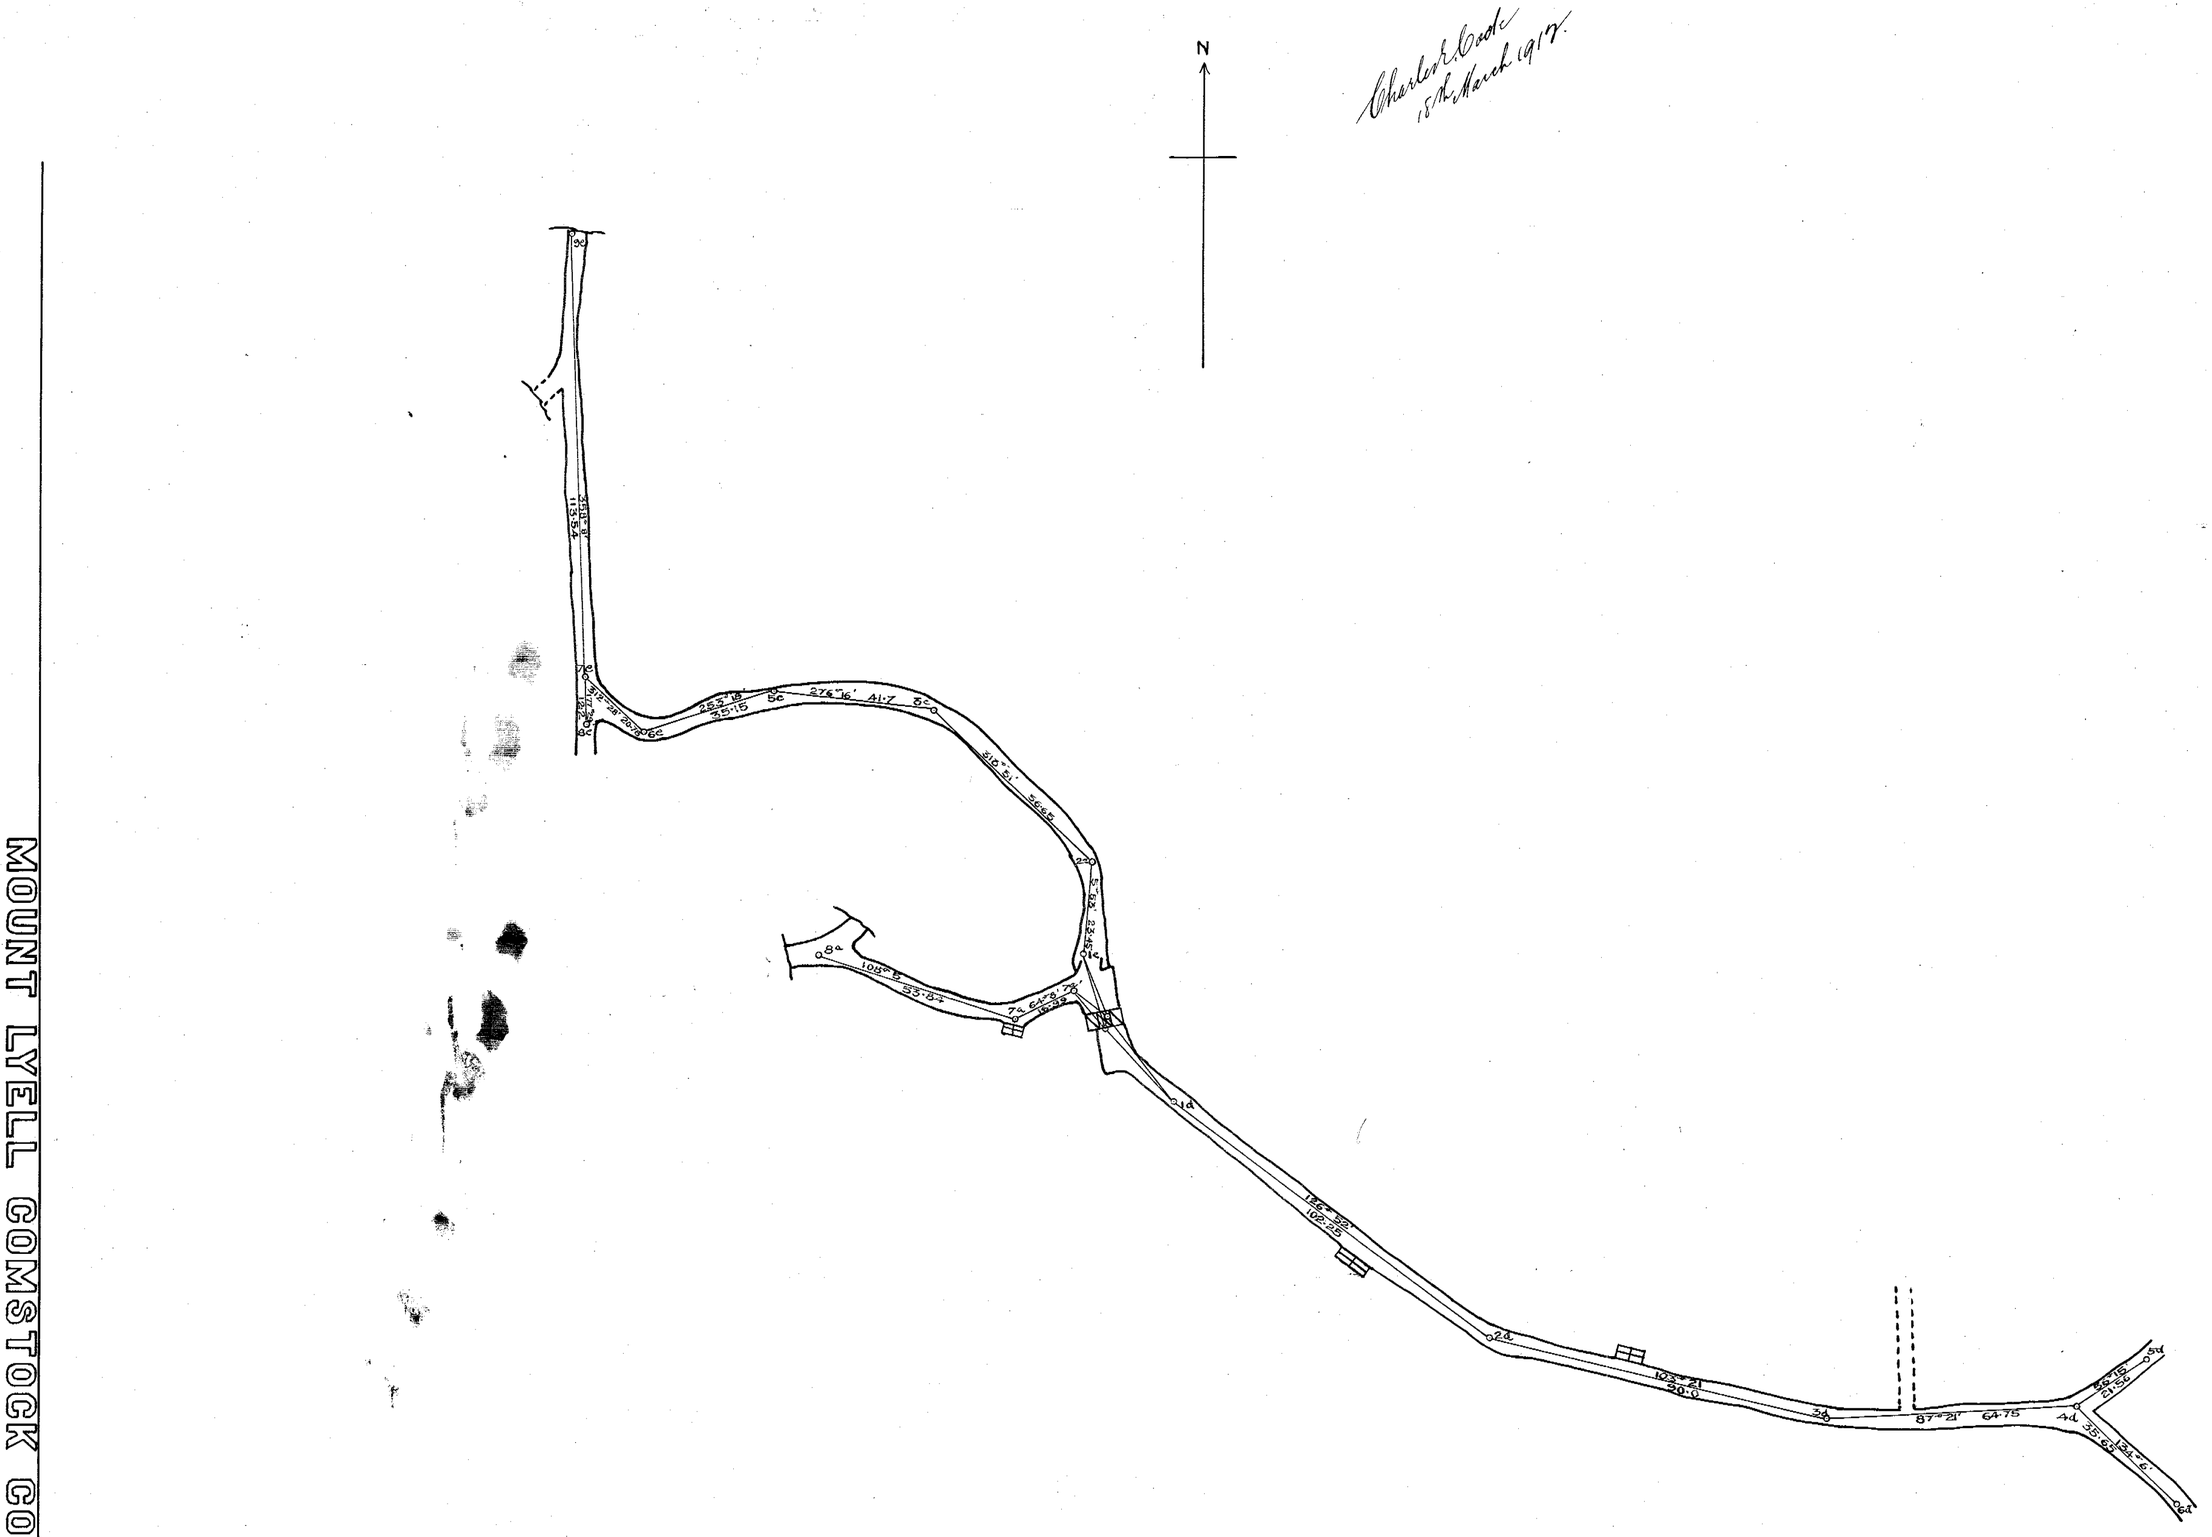

MOUNT LYELL COMSTOCK COPPER CO LTD

2135 91M

2136 91M