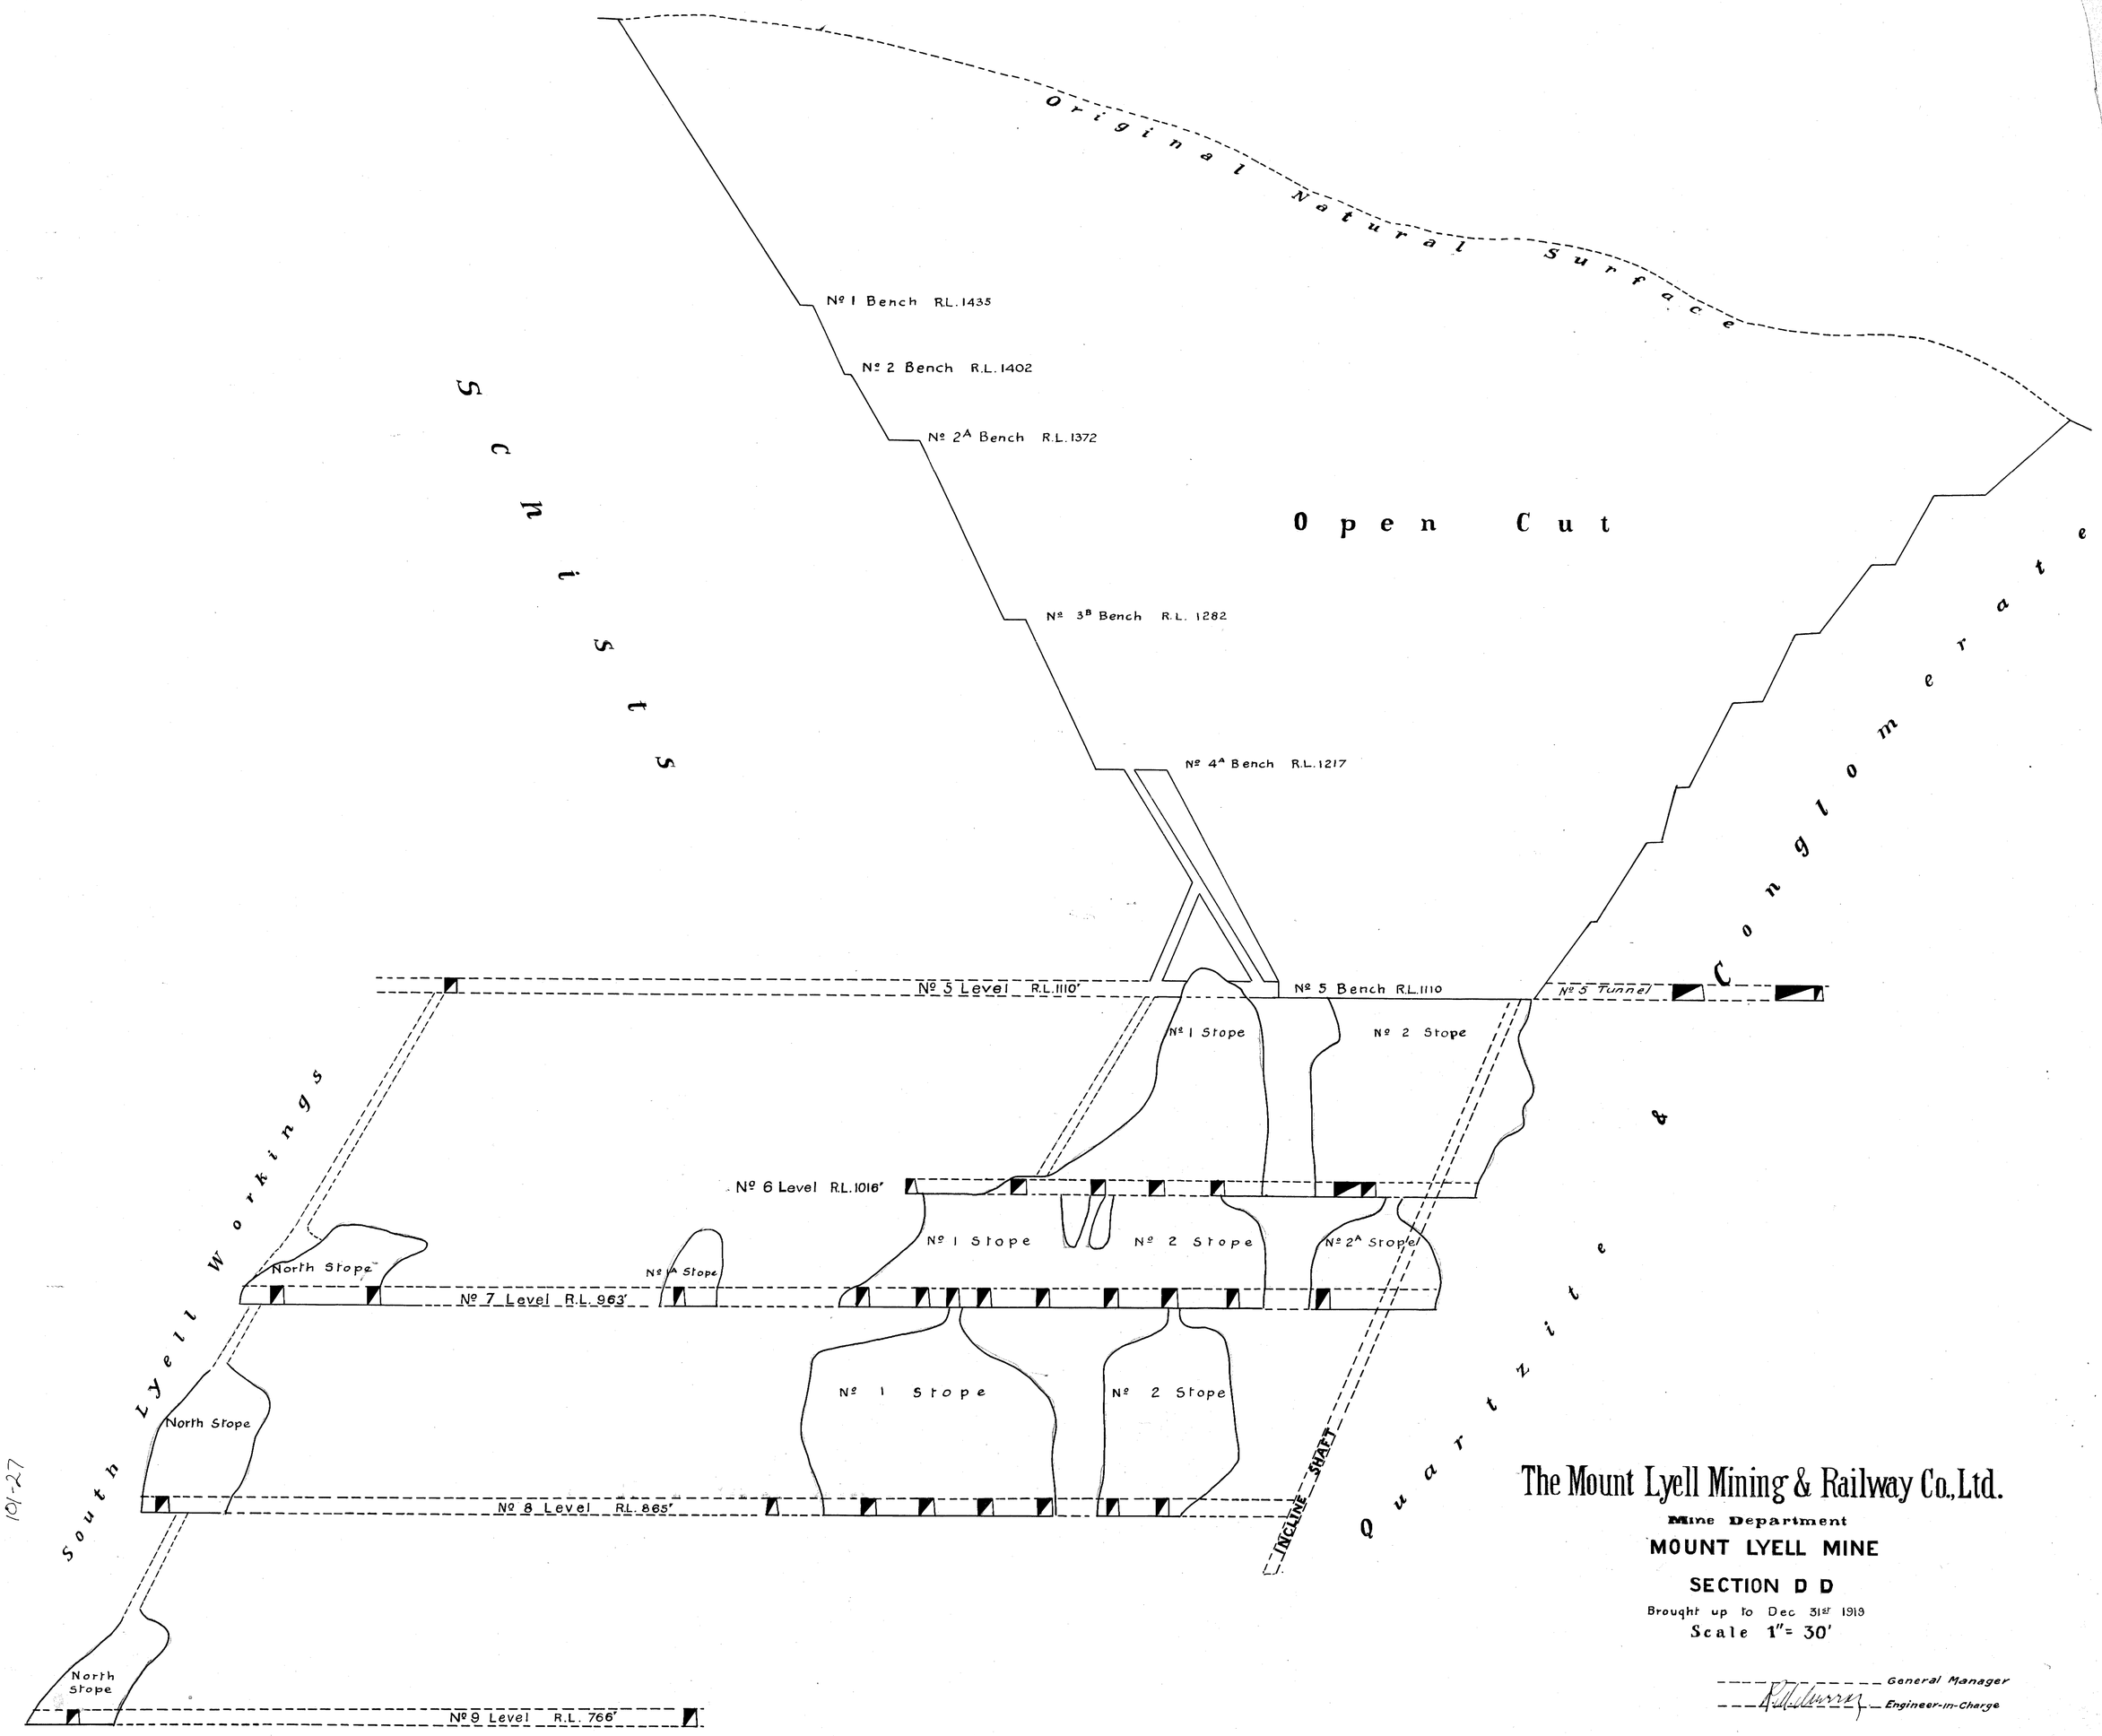

The Mount Lyell Mining & Railway Co., Ltd.

Mine Department

MOUNT LYELL MINE

SECTION D D

Brought up to Dec 31st 1919

Scale 1" = 30'

General Manager

Engineer-in-Charge

101-27

101-27