


101-39

5 cm

LYELL THARSIS

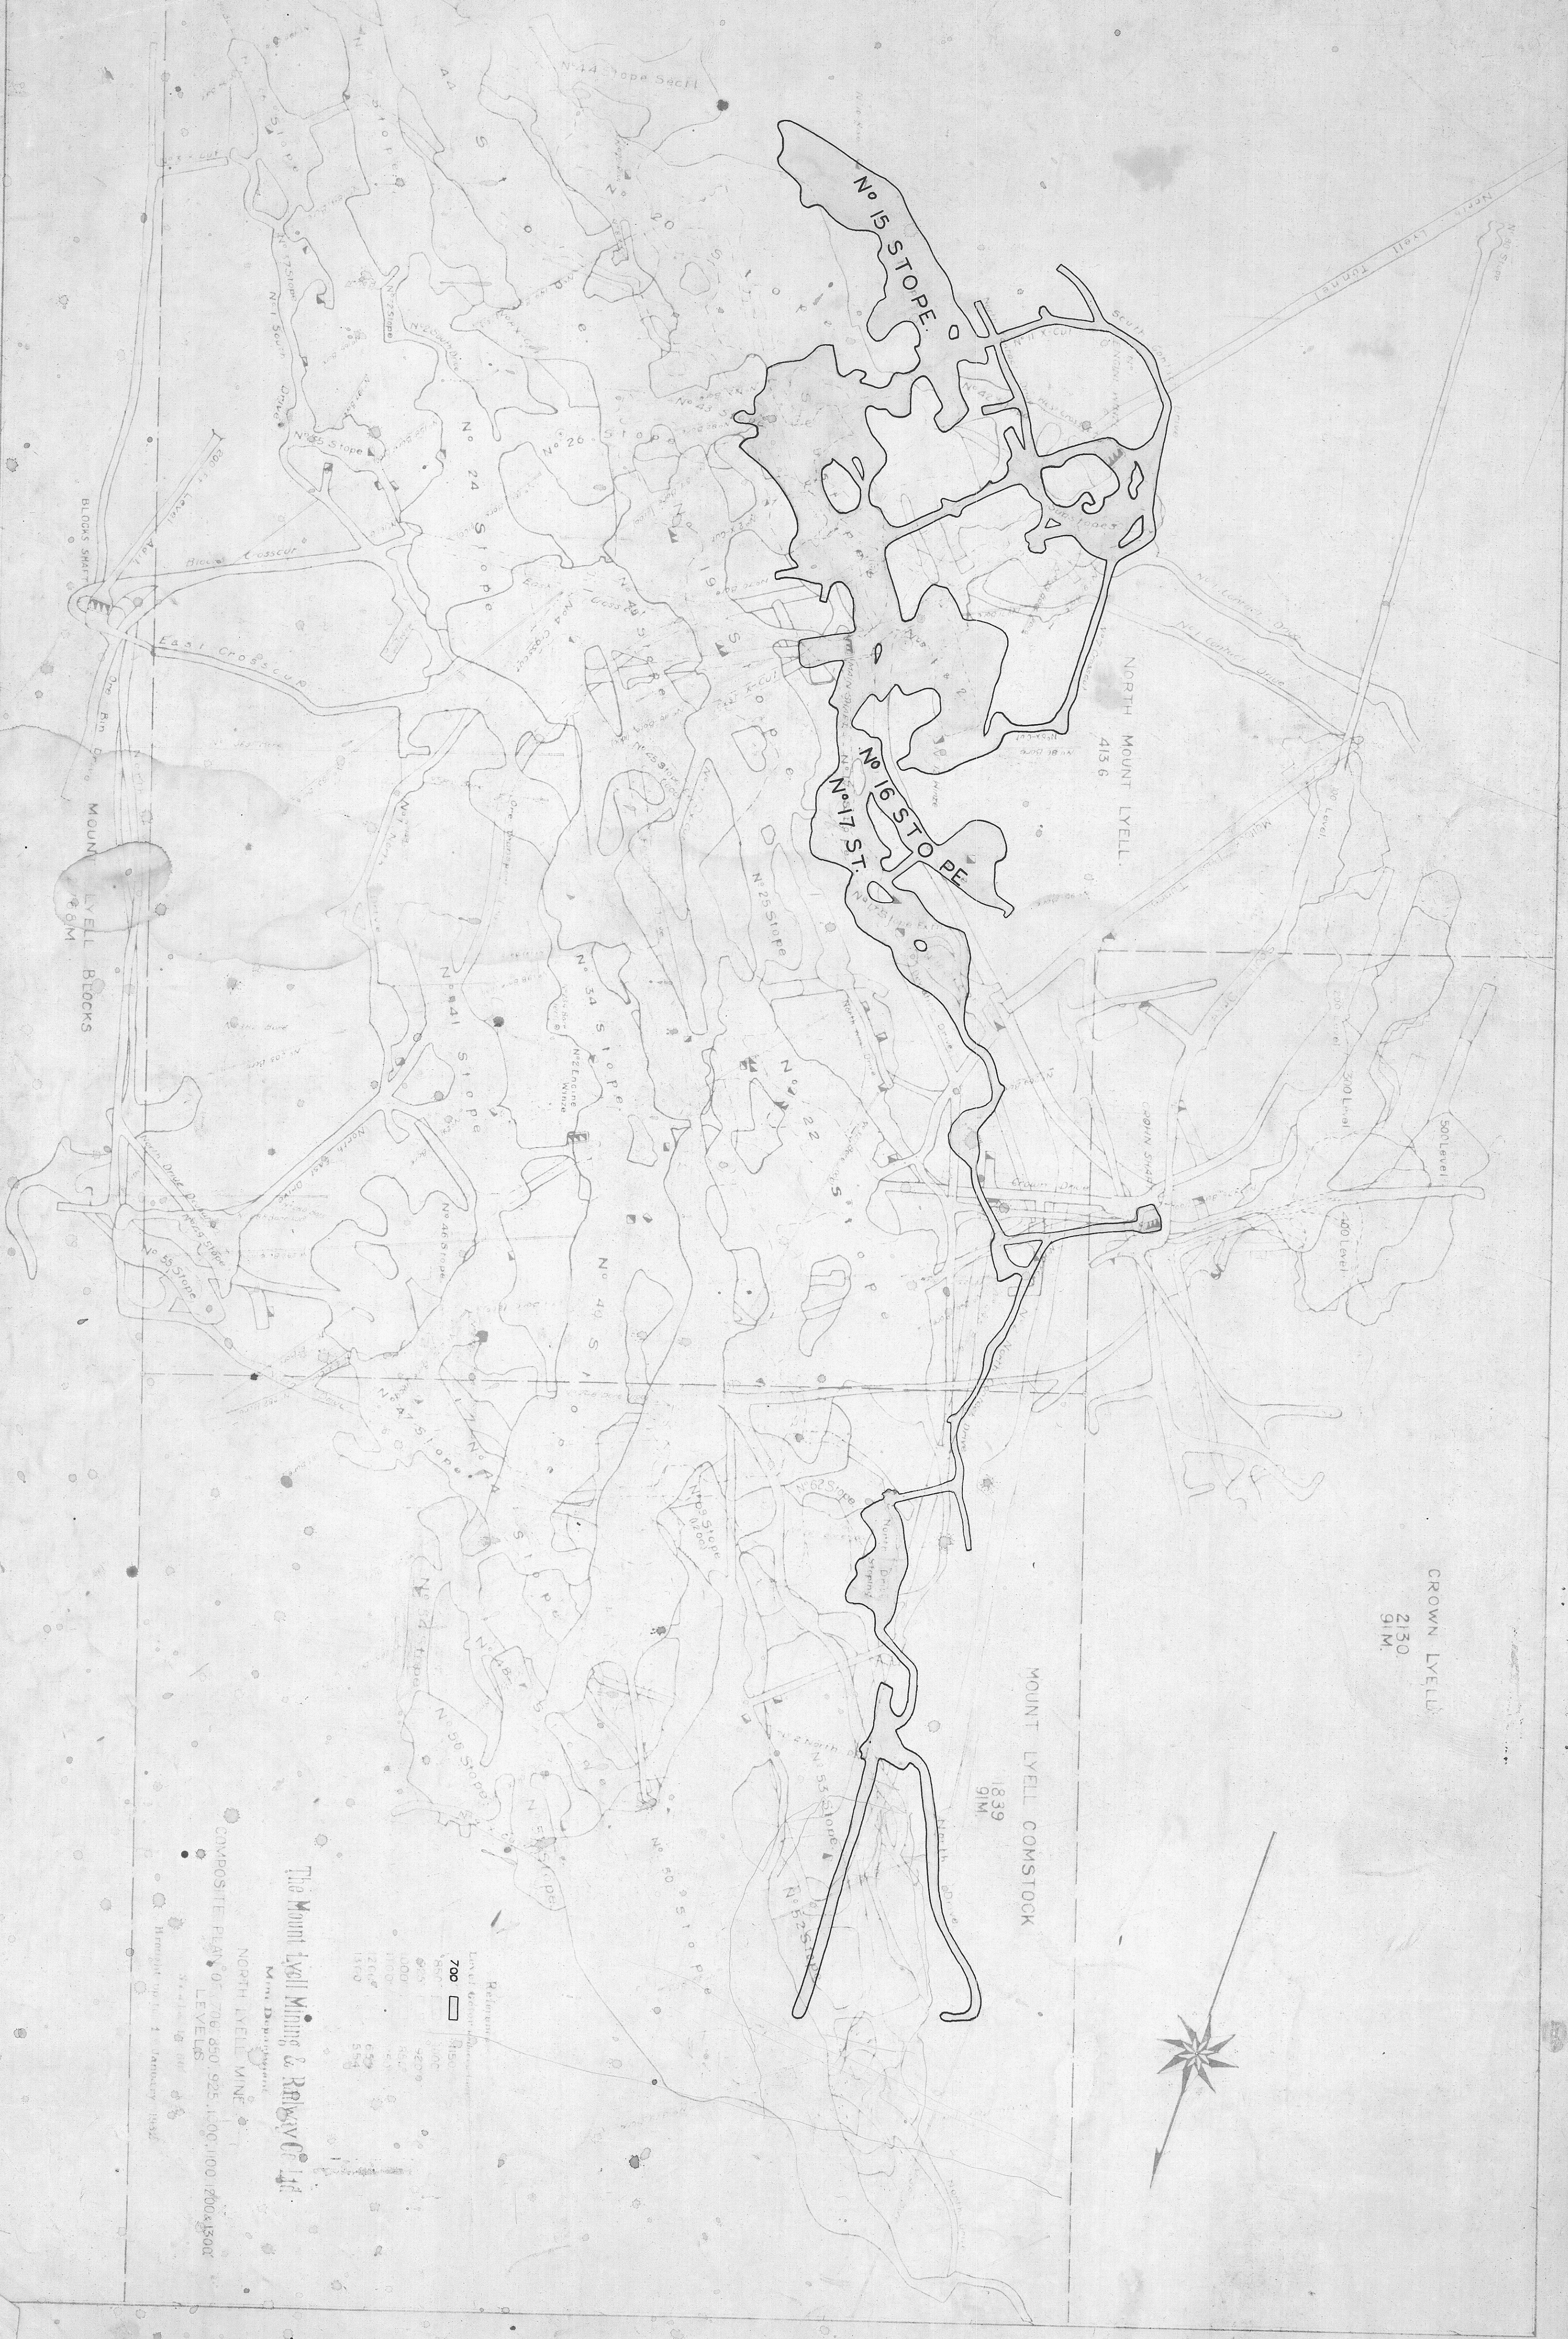

NORTH MOUNT LYELL.
415.6

CROWN LYELL.
2130
91M.

MOUNT LYELL COMSTOCK
1839
91M.

The Mount Lyell Mining & Railway Co. Ltd.
NORTH LYELL MINE
COMPOSITE PLAN OF 700, 850, 925, 1000, 1100, 1200,10000.