

103-05


5 cm

103-05

Copper
CROWN LYELL MINING CO NL.
Underground Survey for 1900

Survey made with Theodolite & steelband chain
Scale 25 feet = 1 inch

John Hume
Chief Surveyor
14th May 1901

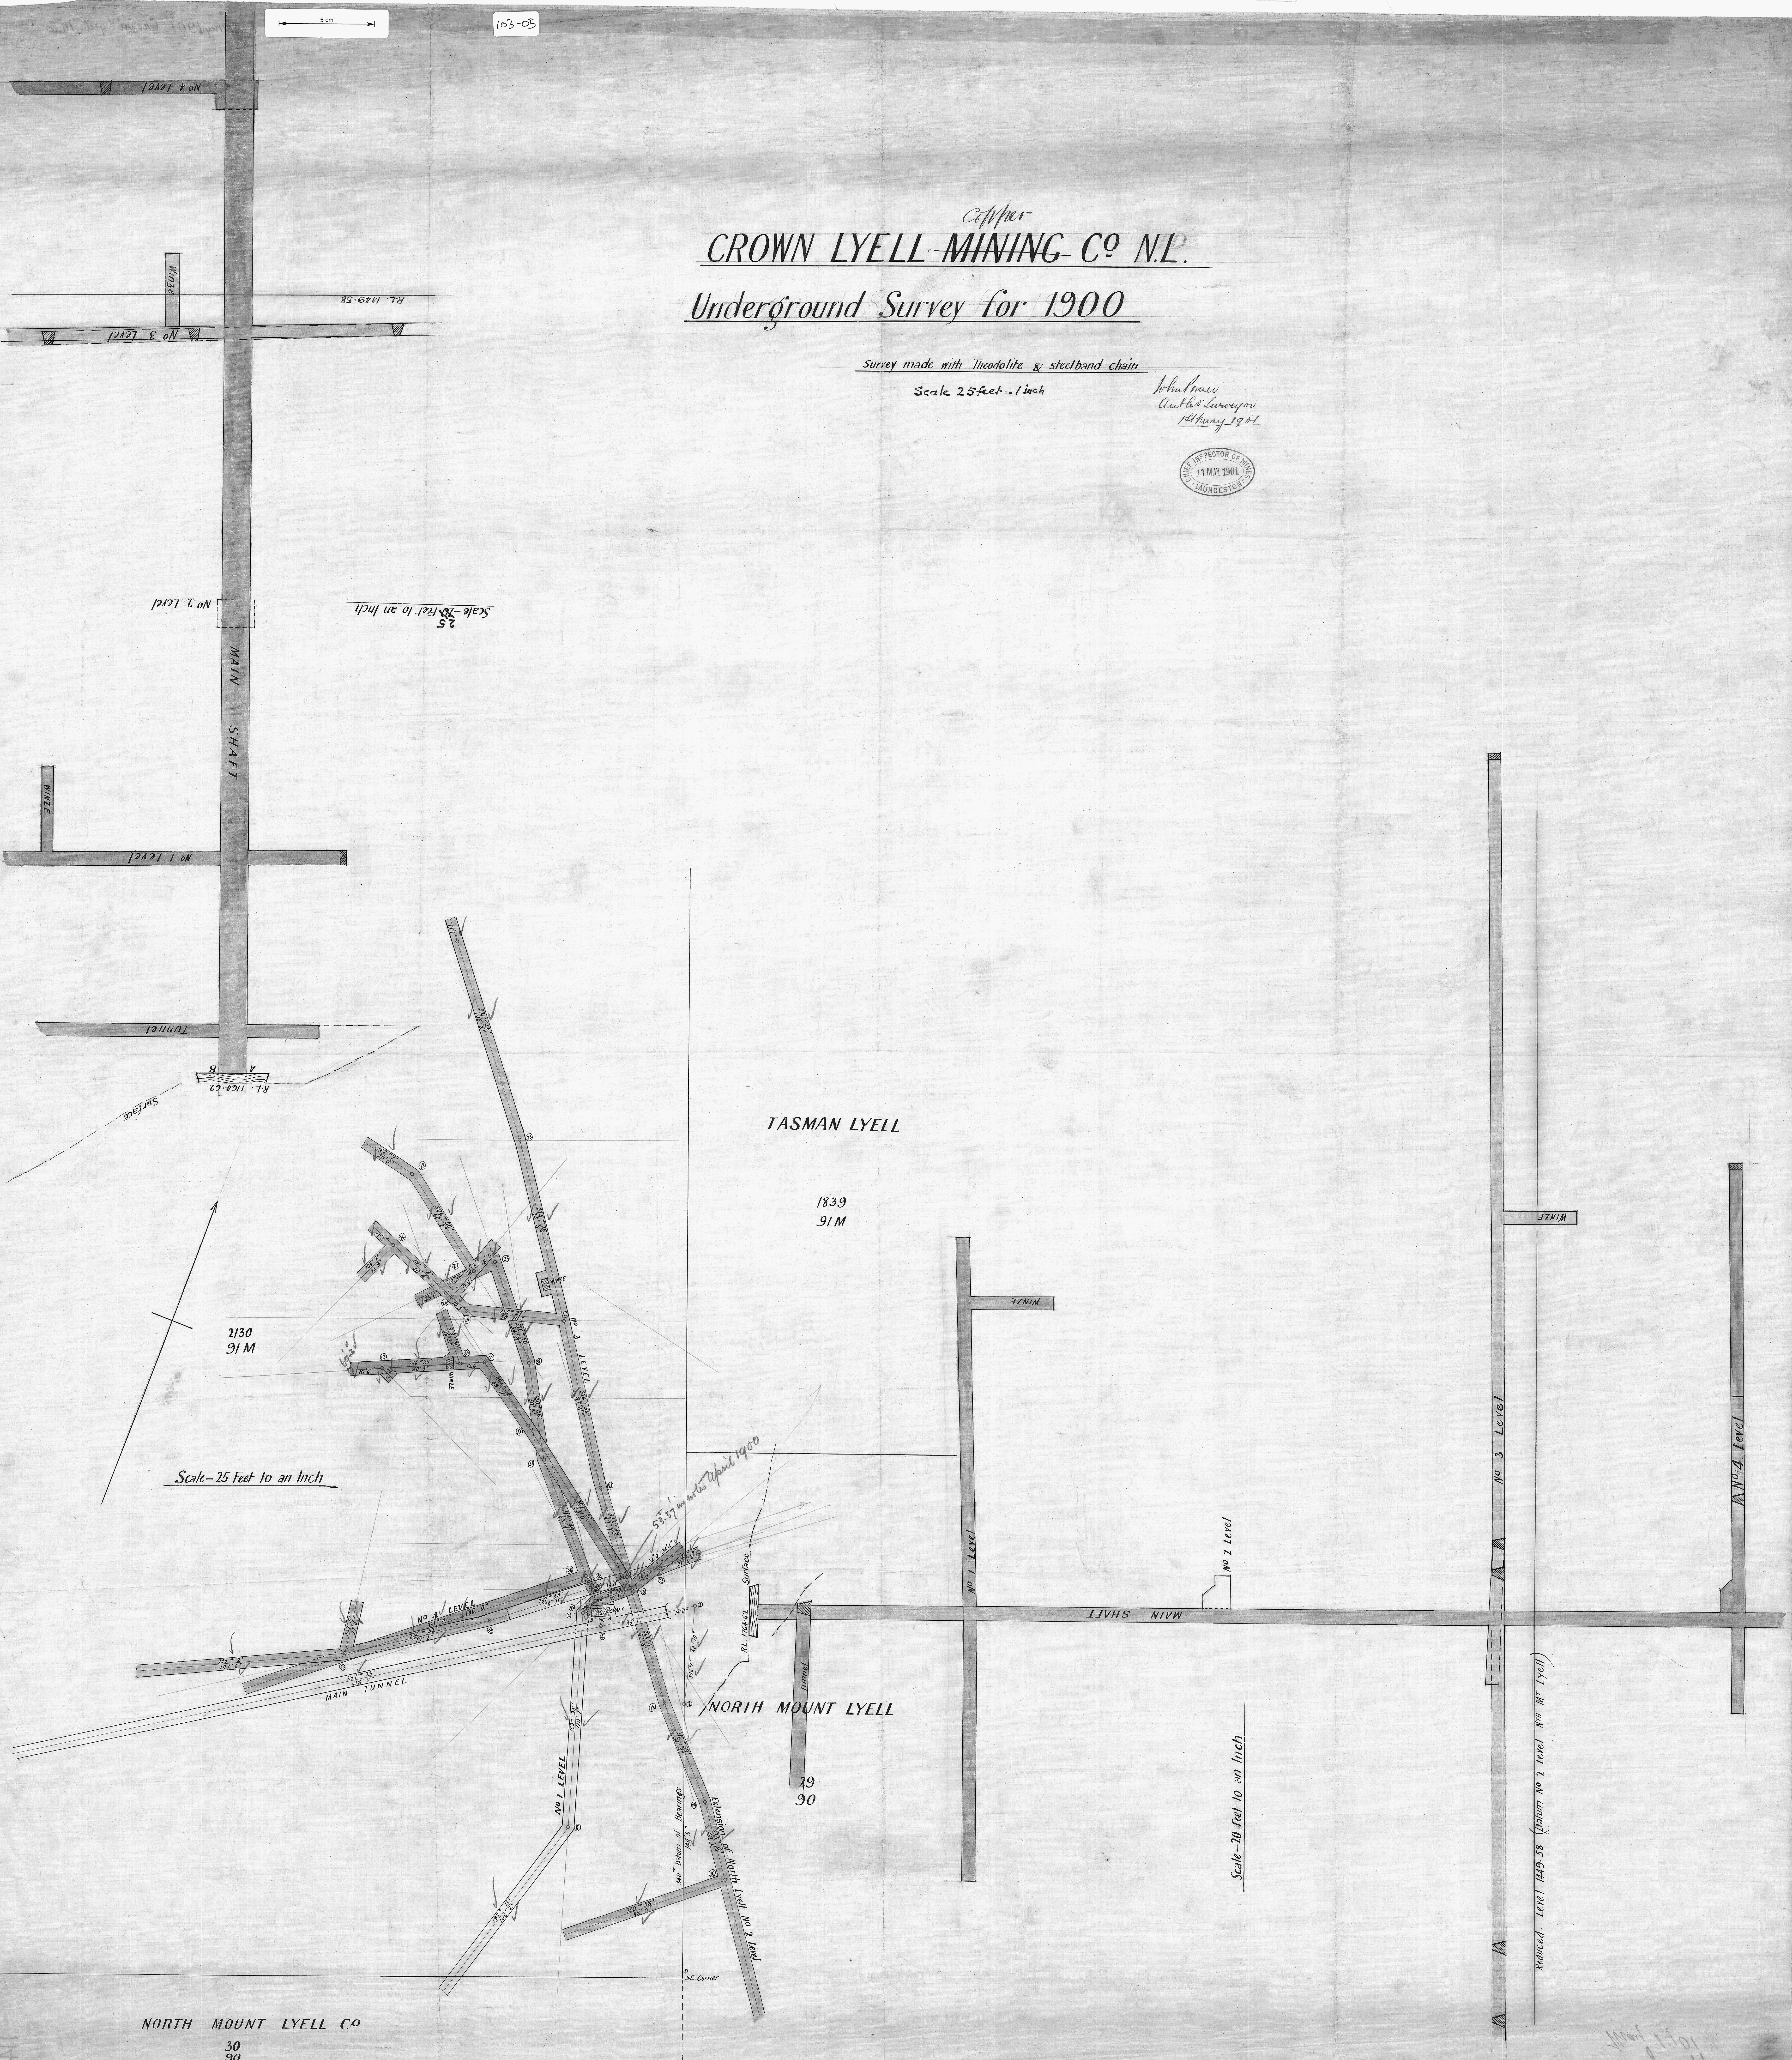

Scale - 25 Feet to an Inch


Reduced Level 1449.58 (Datum No 2 Level, No 4 Level)

NORTH MOUNT LYELL CO
30
90

