Crown Lyell Mining Company

Extension No 2 Tunnel (North Co)

Scale – 40 feet to one inch
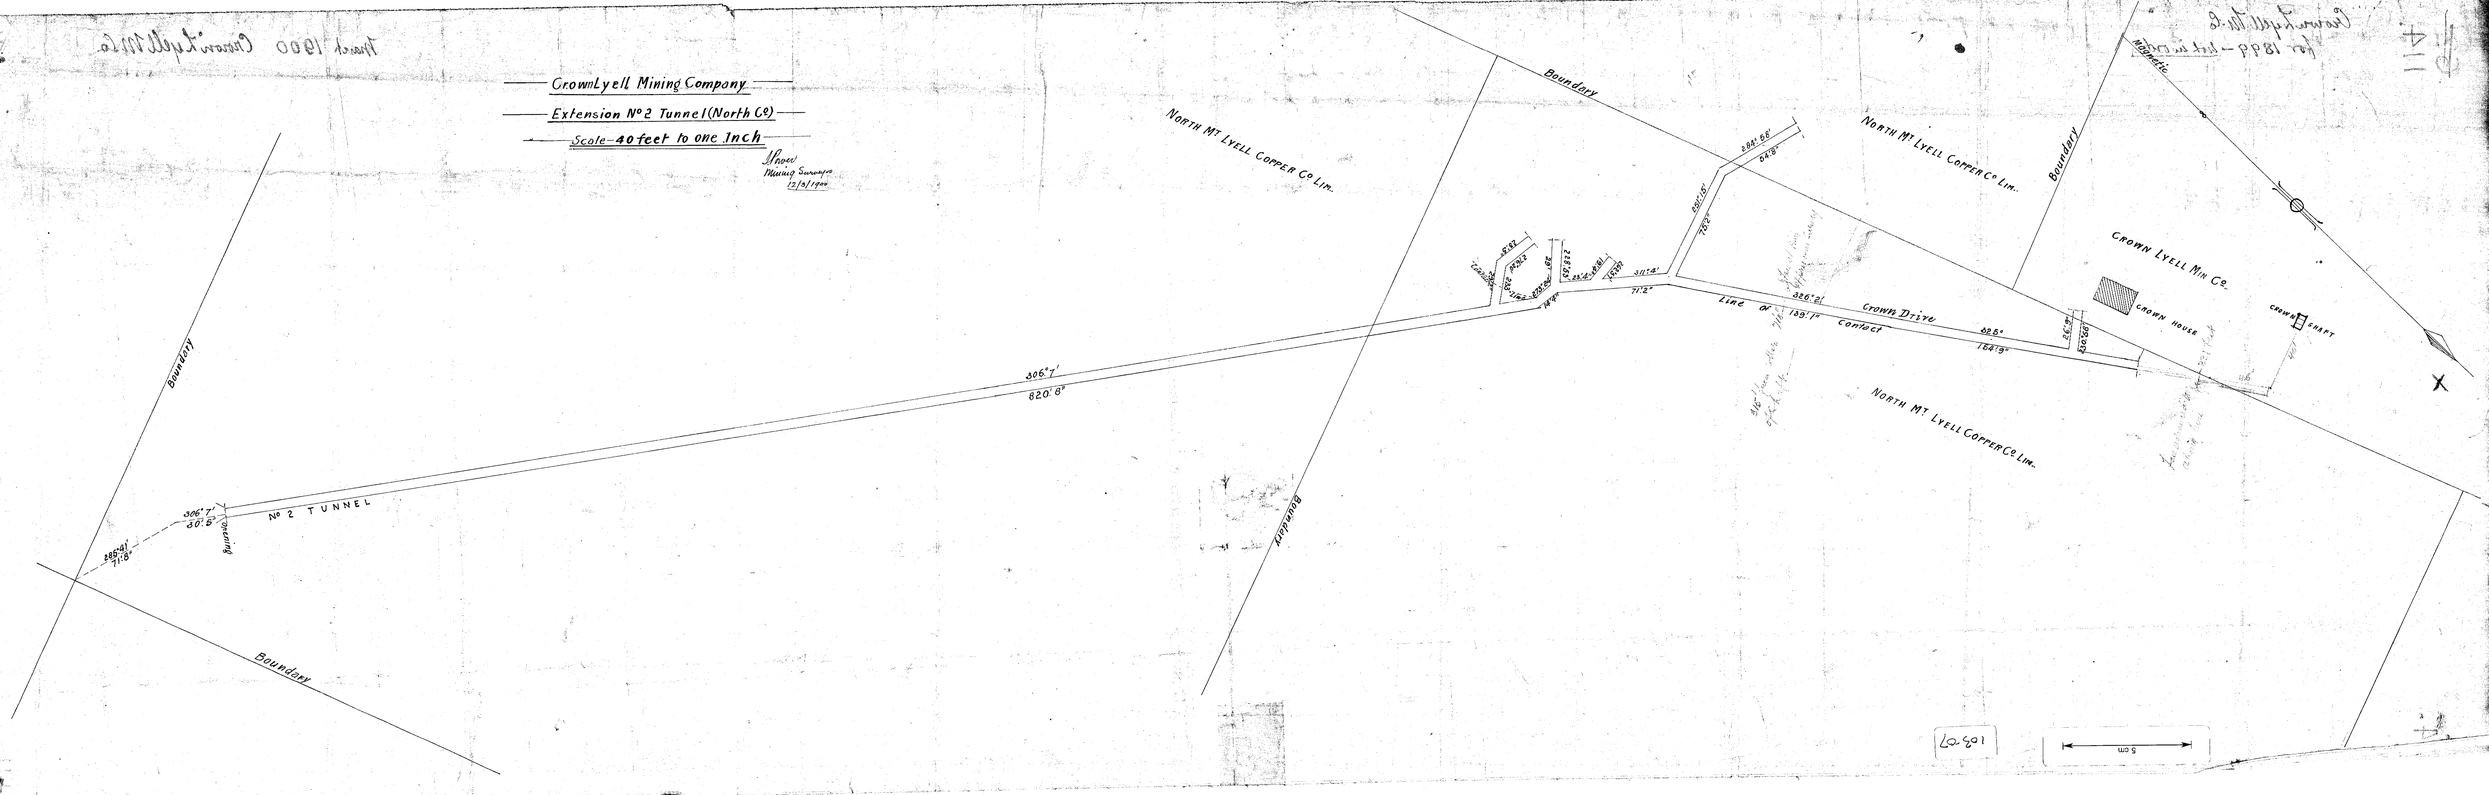
Shown
Mining Surveyor
12/8/1900