


5 cm


Nº1 LEVEL STOPE

105-08


Scale 40' to 1"

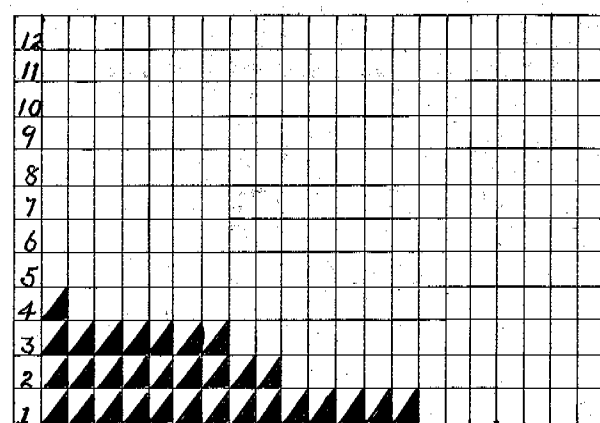


SECTION

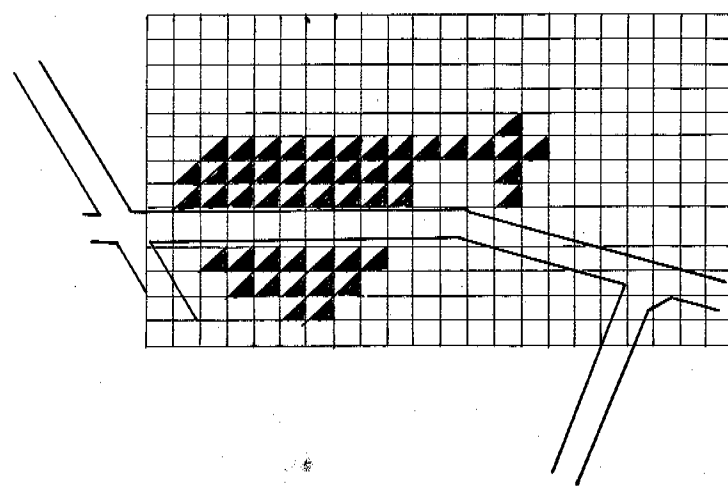


Nº1 FLOOR

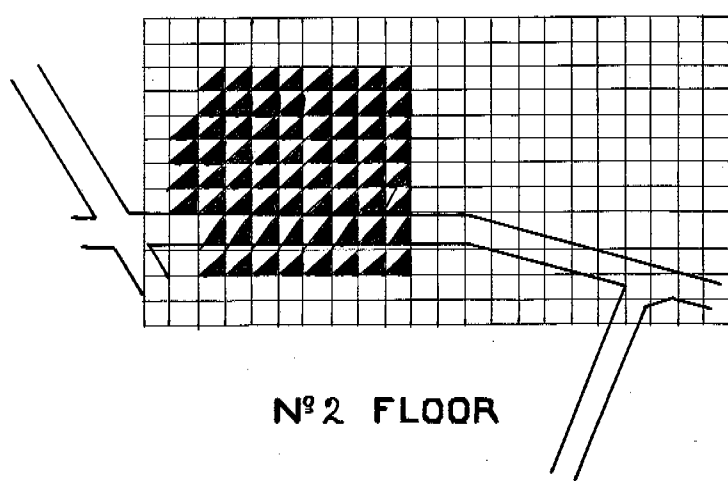

Nº2 FLOOR

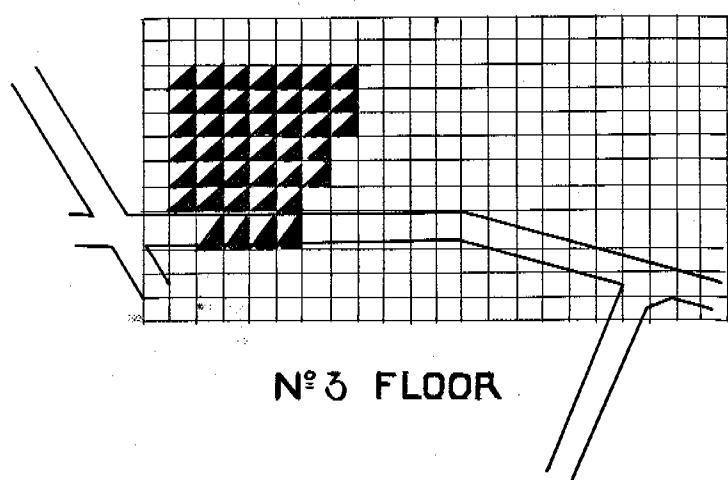

Nº3 FLOOR

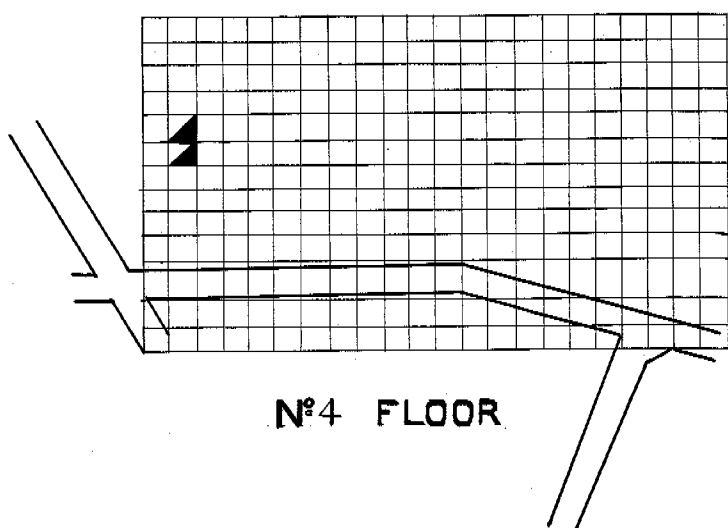

Nº4 FLOOR