

5 cm



105-20

M^T LYELL BLOCKS M. CO. N.L.


PLAN OF BALANCE SHAFT STOPES

Scale 40 ft. to lin.


Jno. McPeak
19/2/96

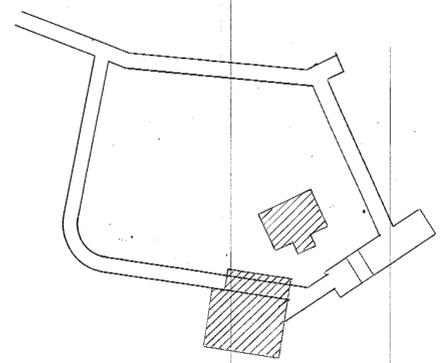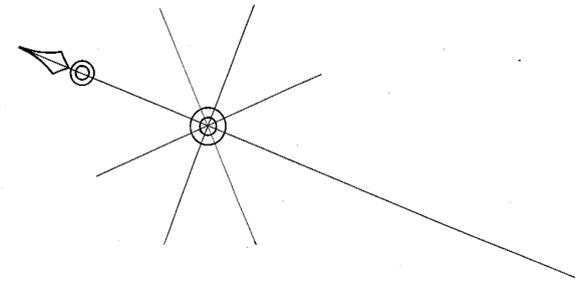


No. 9 FLOOR

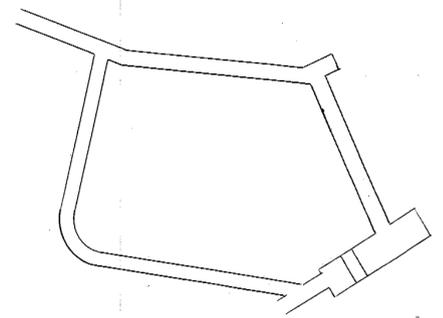


No. 10 FLOOR

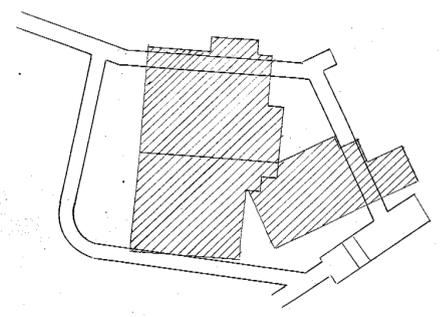


No. 5 FLOOR

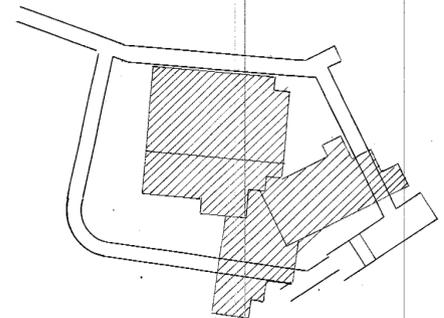


No. 6 FLOOR

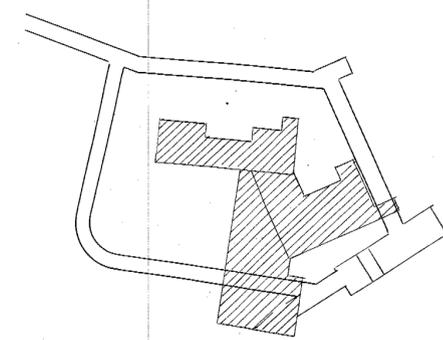


No. 7 FLOOR

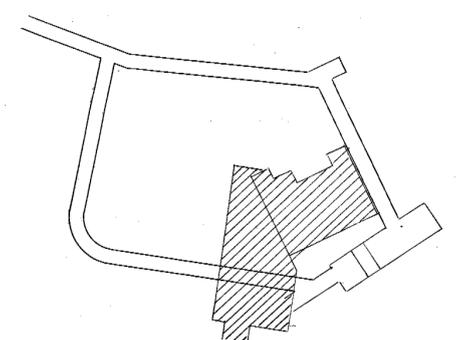


No. 8 FLOOR

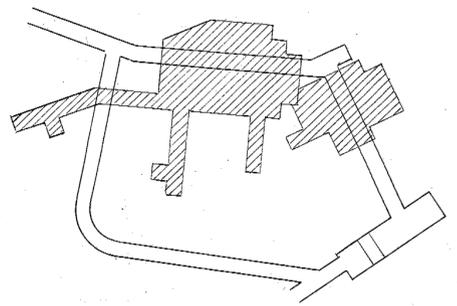


No. 1 FLOOR

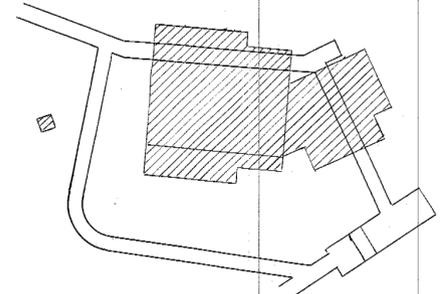

No. 2 FLOOR

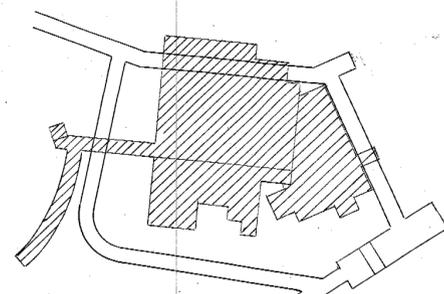

No. 3 FLOOR

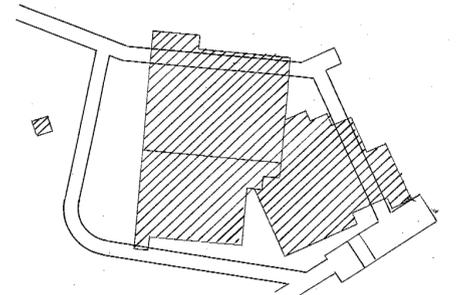

No. 4 FLOOR