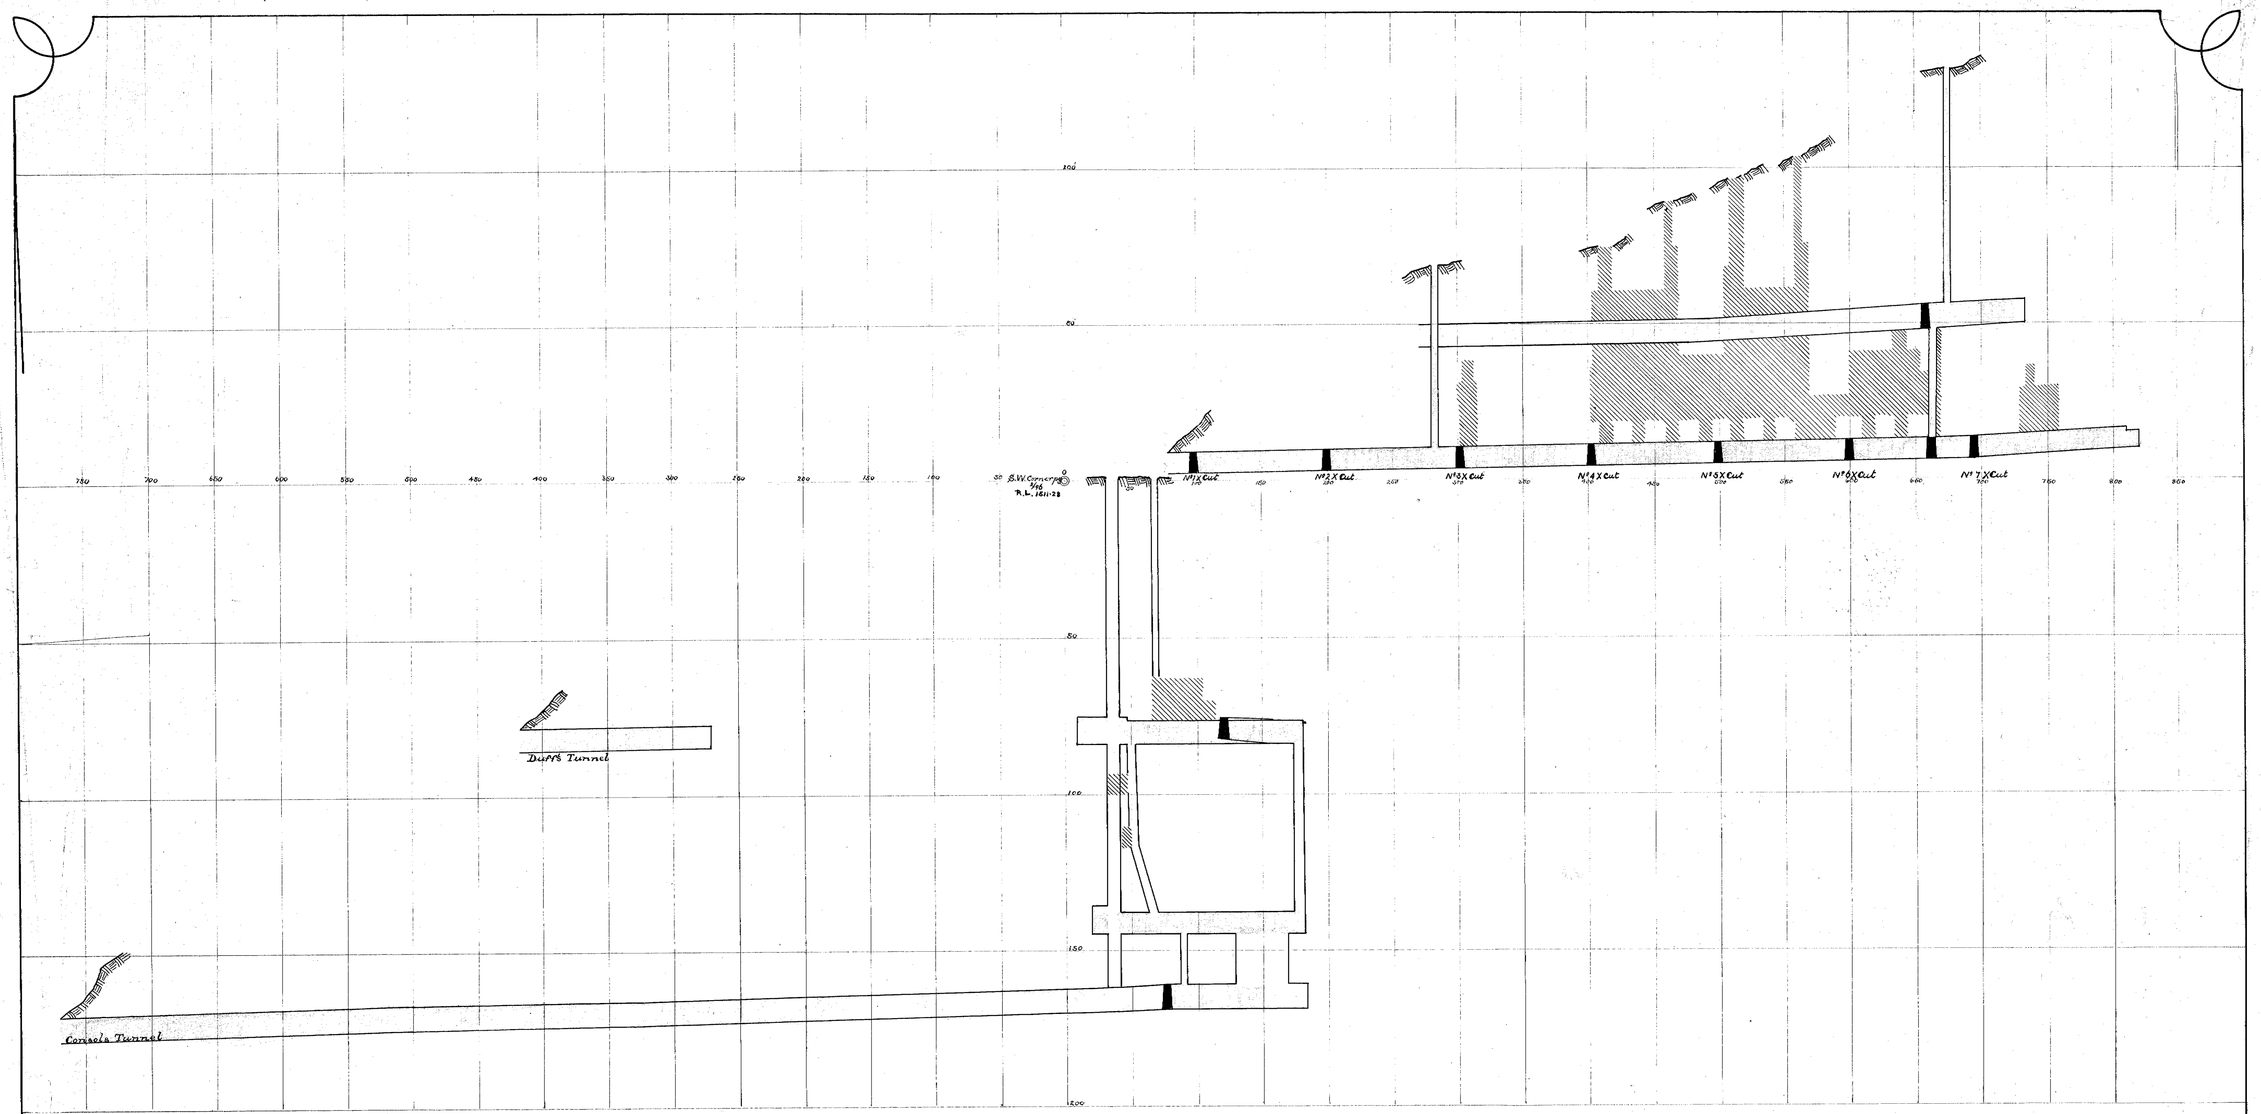

LONGITUDINAL SECTION

// to Western Boundary

Vertical Scale 25' to 1"
Horizontal " " 60 " "

F.W. Chandler
Surveyor
31/12/04

5cm

105-26