108-02

108-02

11/2/92 ACC.

Compass worked to field notes 12/1/92 ACC.

5 cm

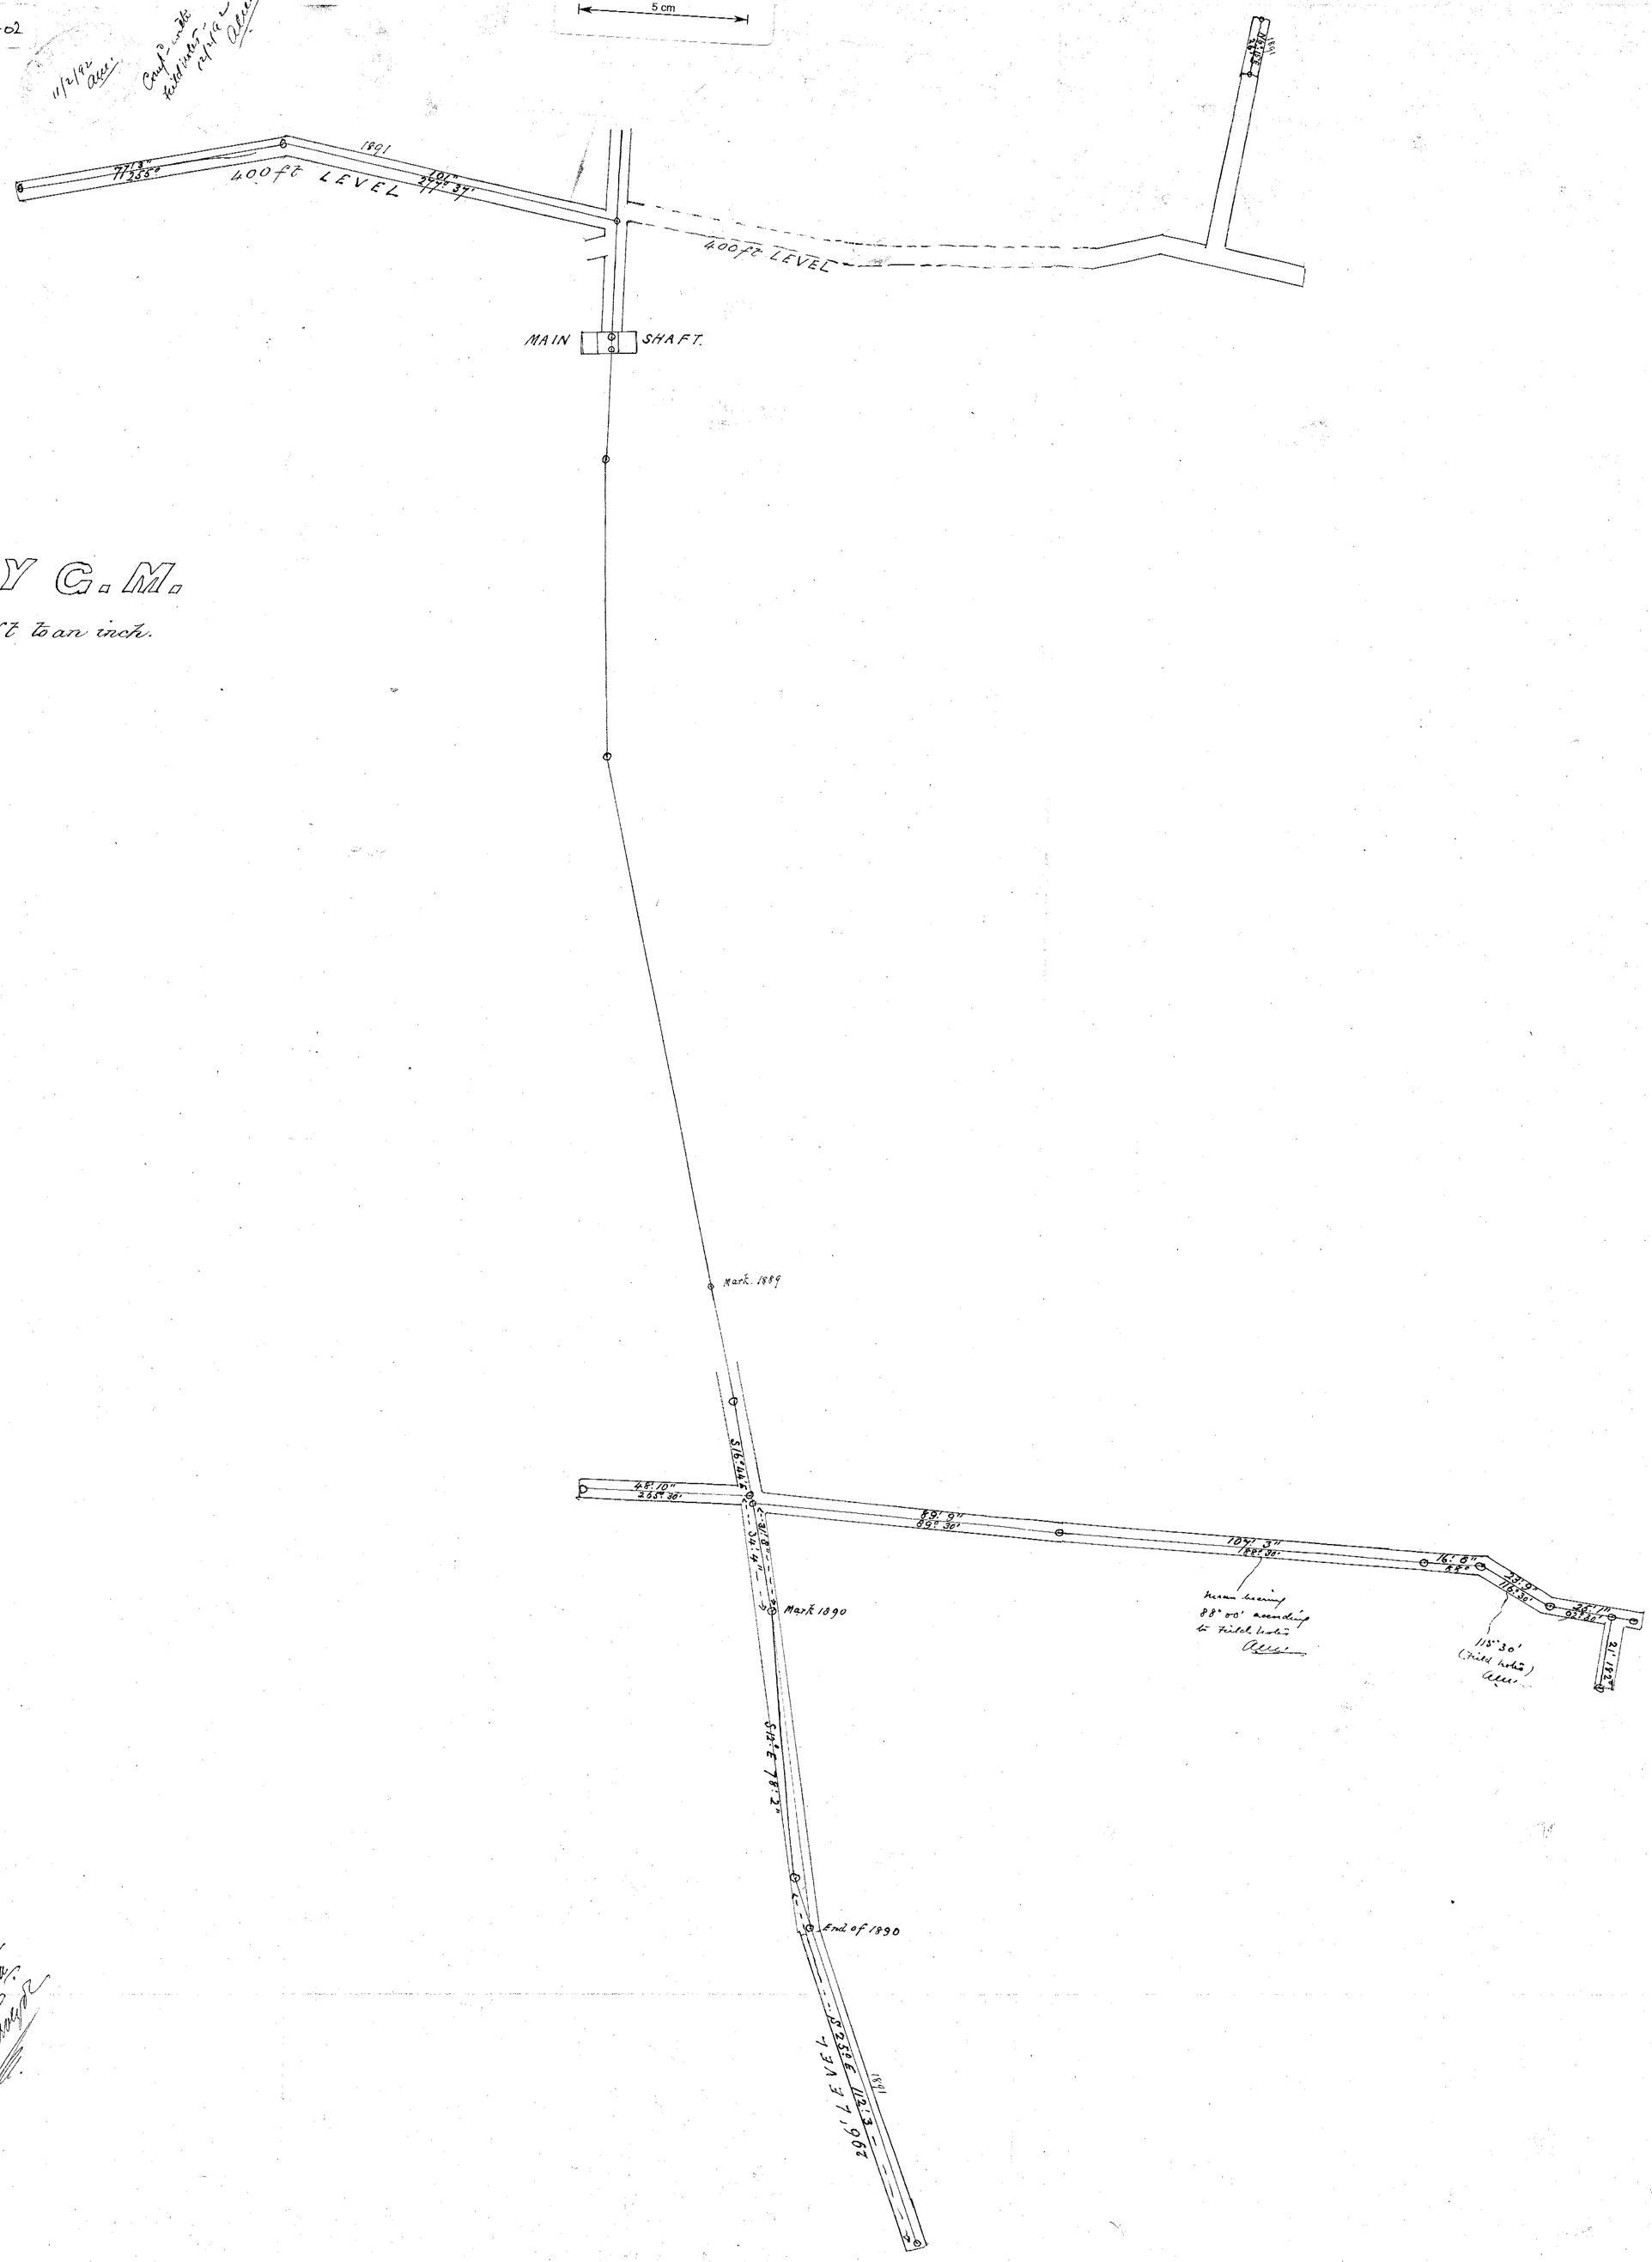

I certified correct copy of plan in Mining Office for year 1891. [illegible] Inspector