109-03

New Monarch G. M.

Scale 25 ft. to 1 inch.

Certified correct copy of plan of work done during the year 1900
C. Bright Watchorn.
Certif. Surveyor
Theodolite survey. 16/2/1901
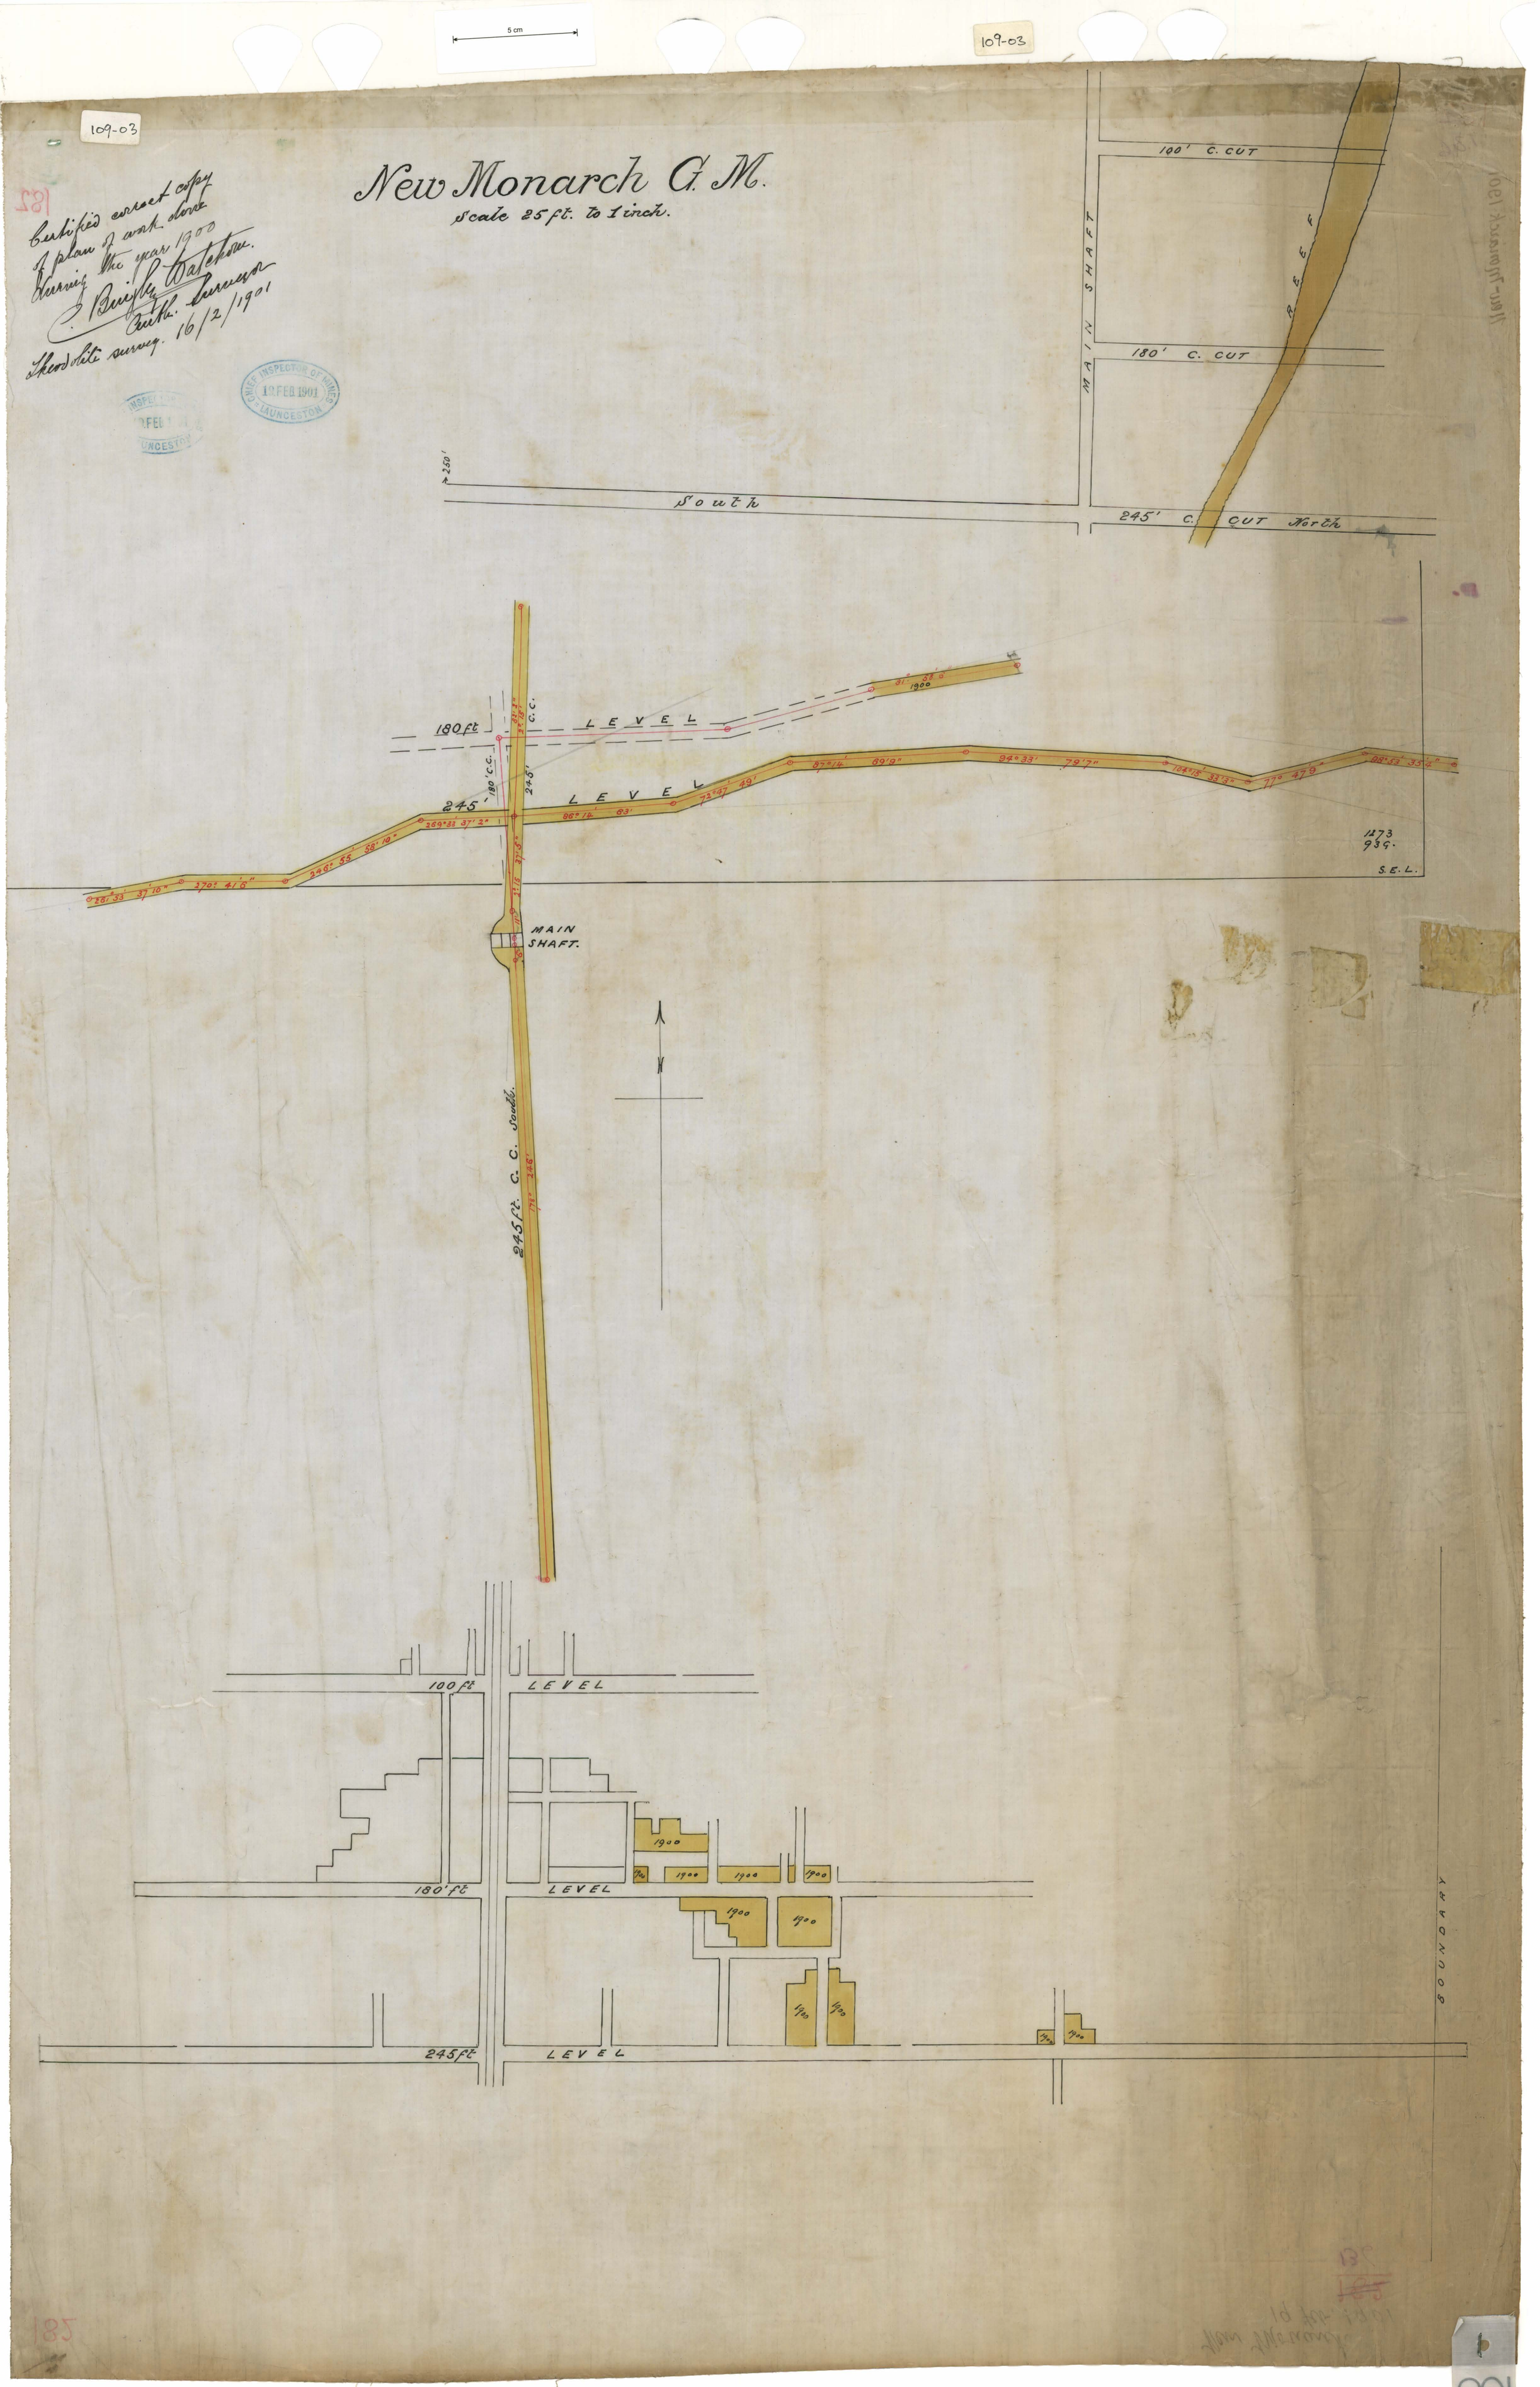
CHIEF INSPECTOR OF MINES 18 FEB 1901 LAUNCESTON