


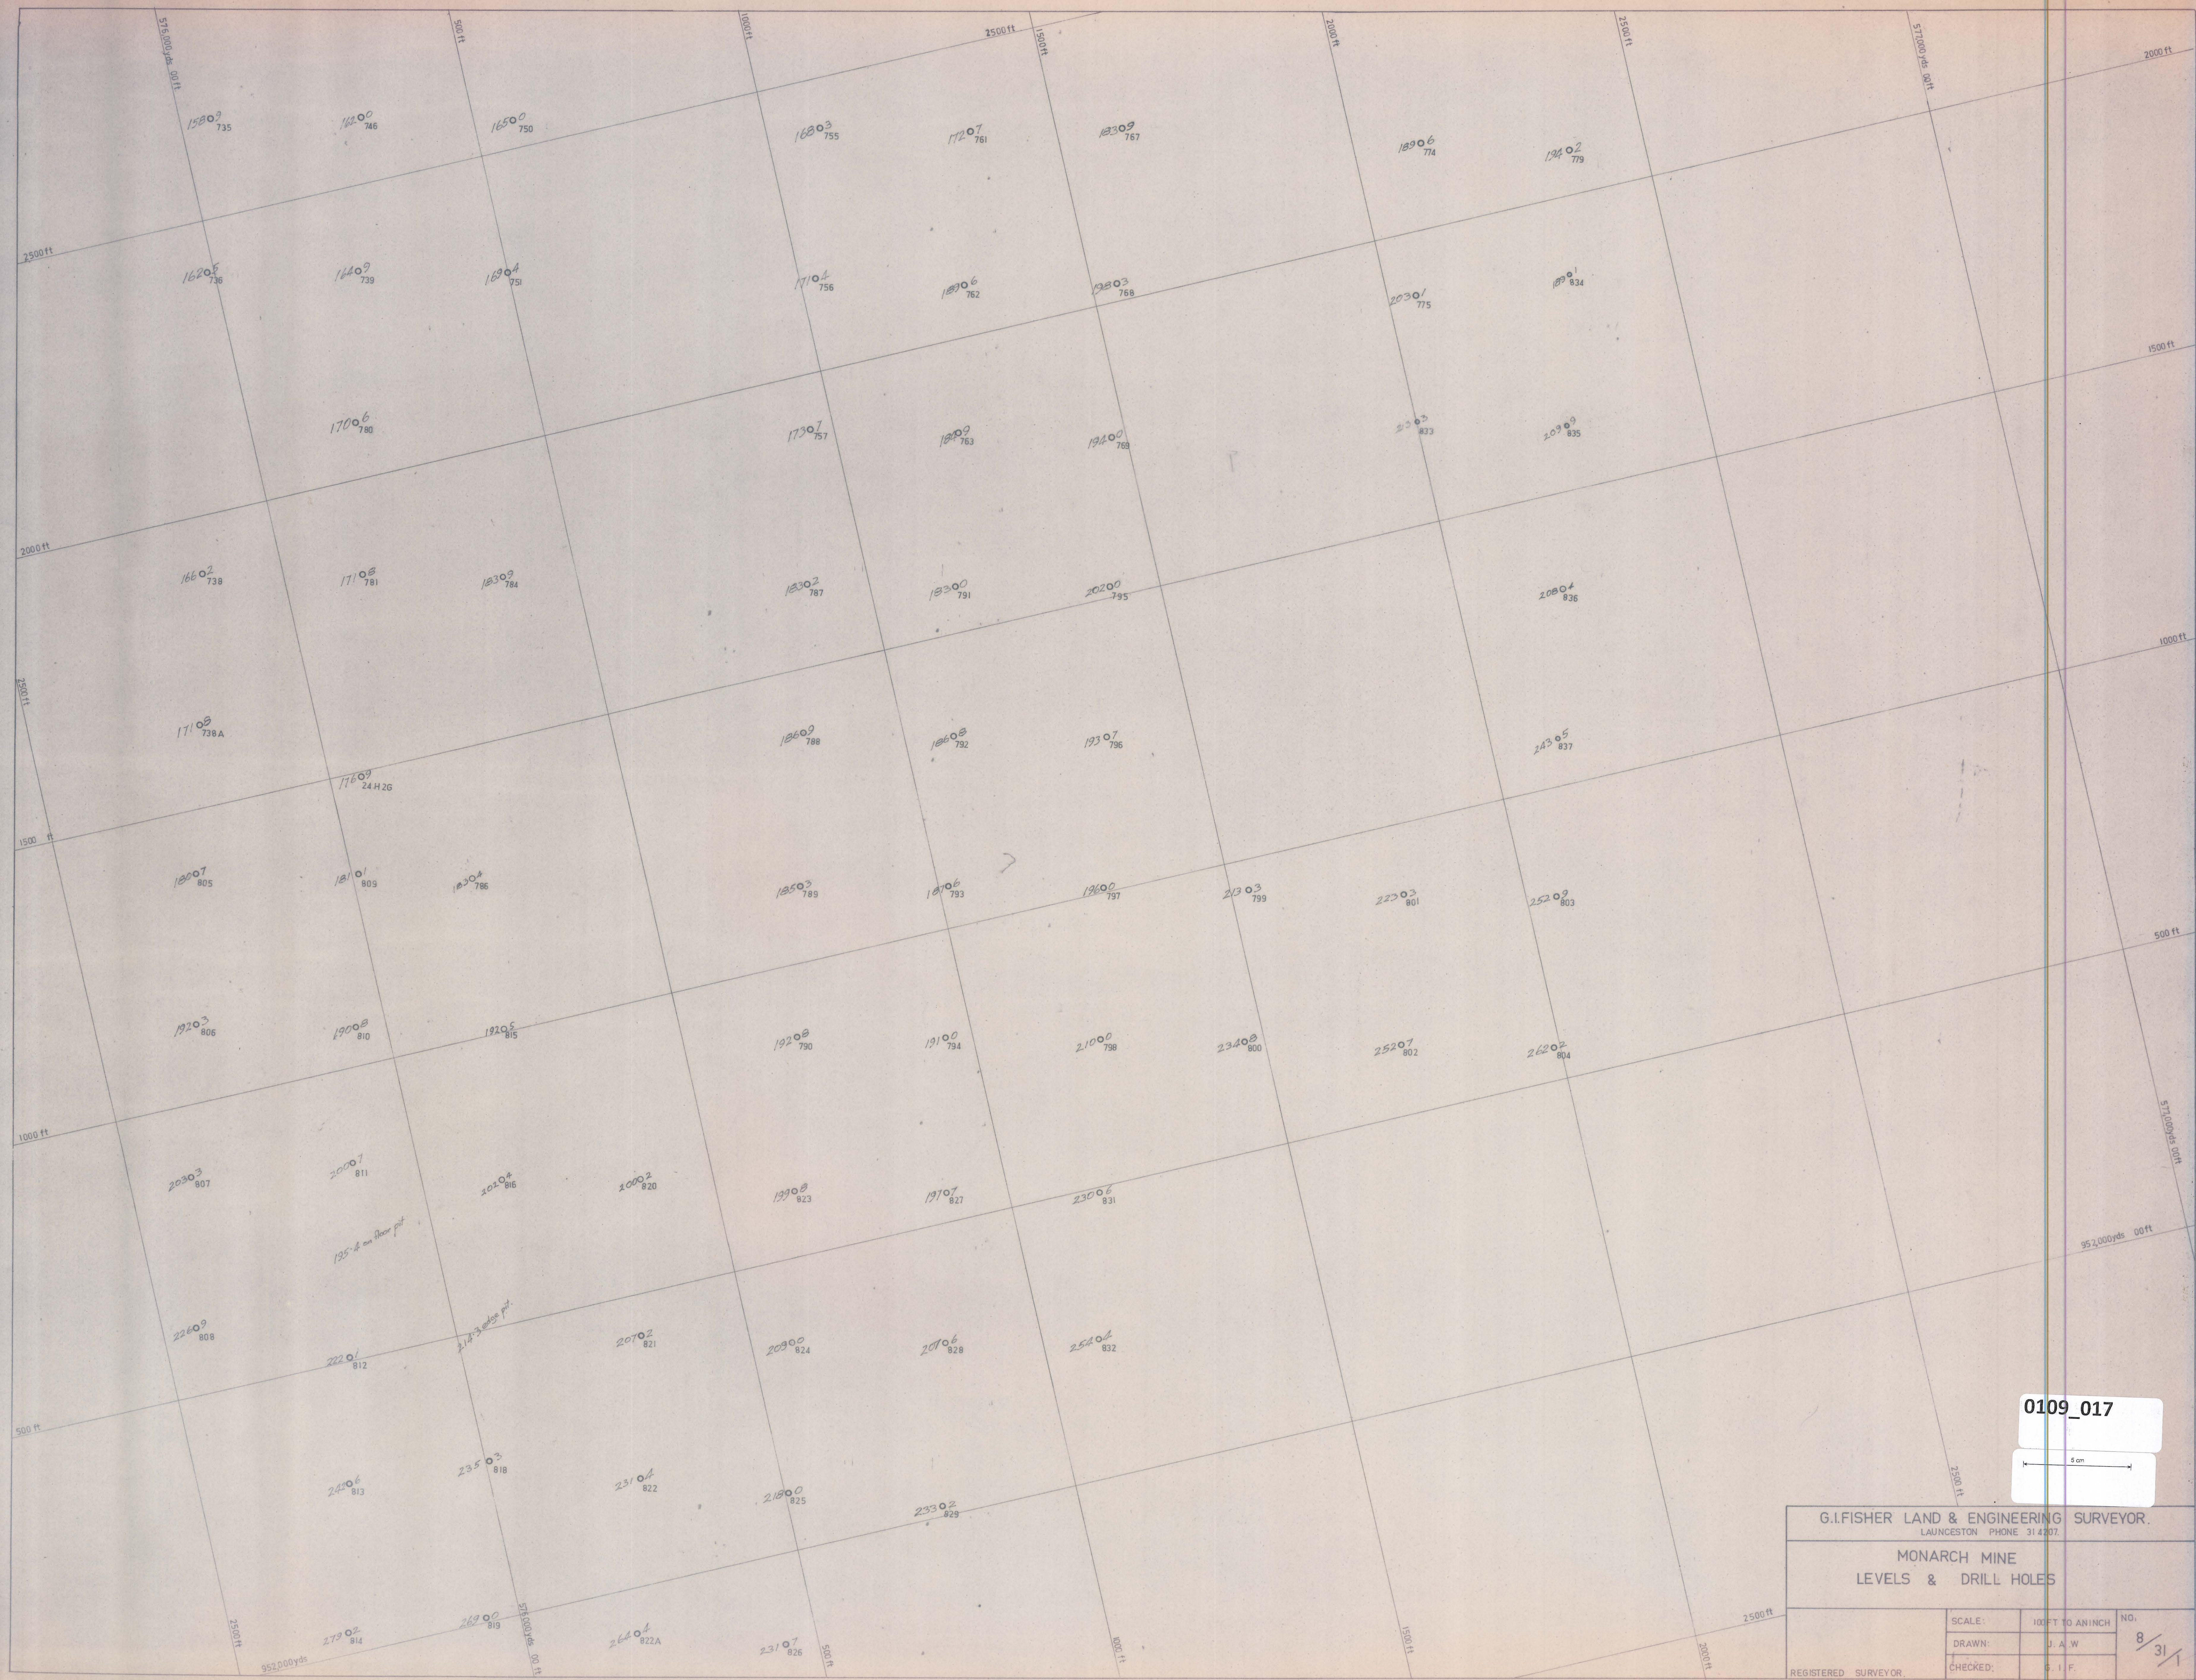

0109_017

0109_017

G.I. FISHER LAND & ENGINEERING SURVEYOR. LAUNCESTON PHONE 314207.			
MONARCH MINE LEVELS & DRILL HOLES			
SCALE:	100 FT TO AN INCH	NO.	8/31
DRAWN:	J. A. W.	CHECKED:	G. I. F.
REGISTERED SURVEYOR.			