110-04

110-04

5 cm

NEW LONDON & TASN G.M.Co. N.L.

SPECIMEN REEF

Scale 25 feet to an inch.

30th Jan. 1901

District Surveyor,
Waratah.
Tas.
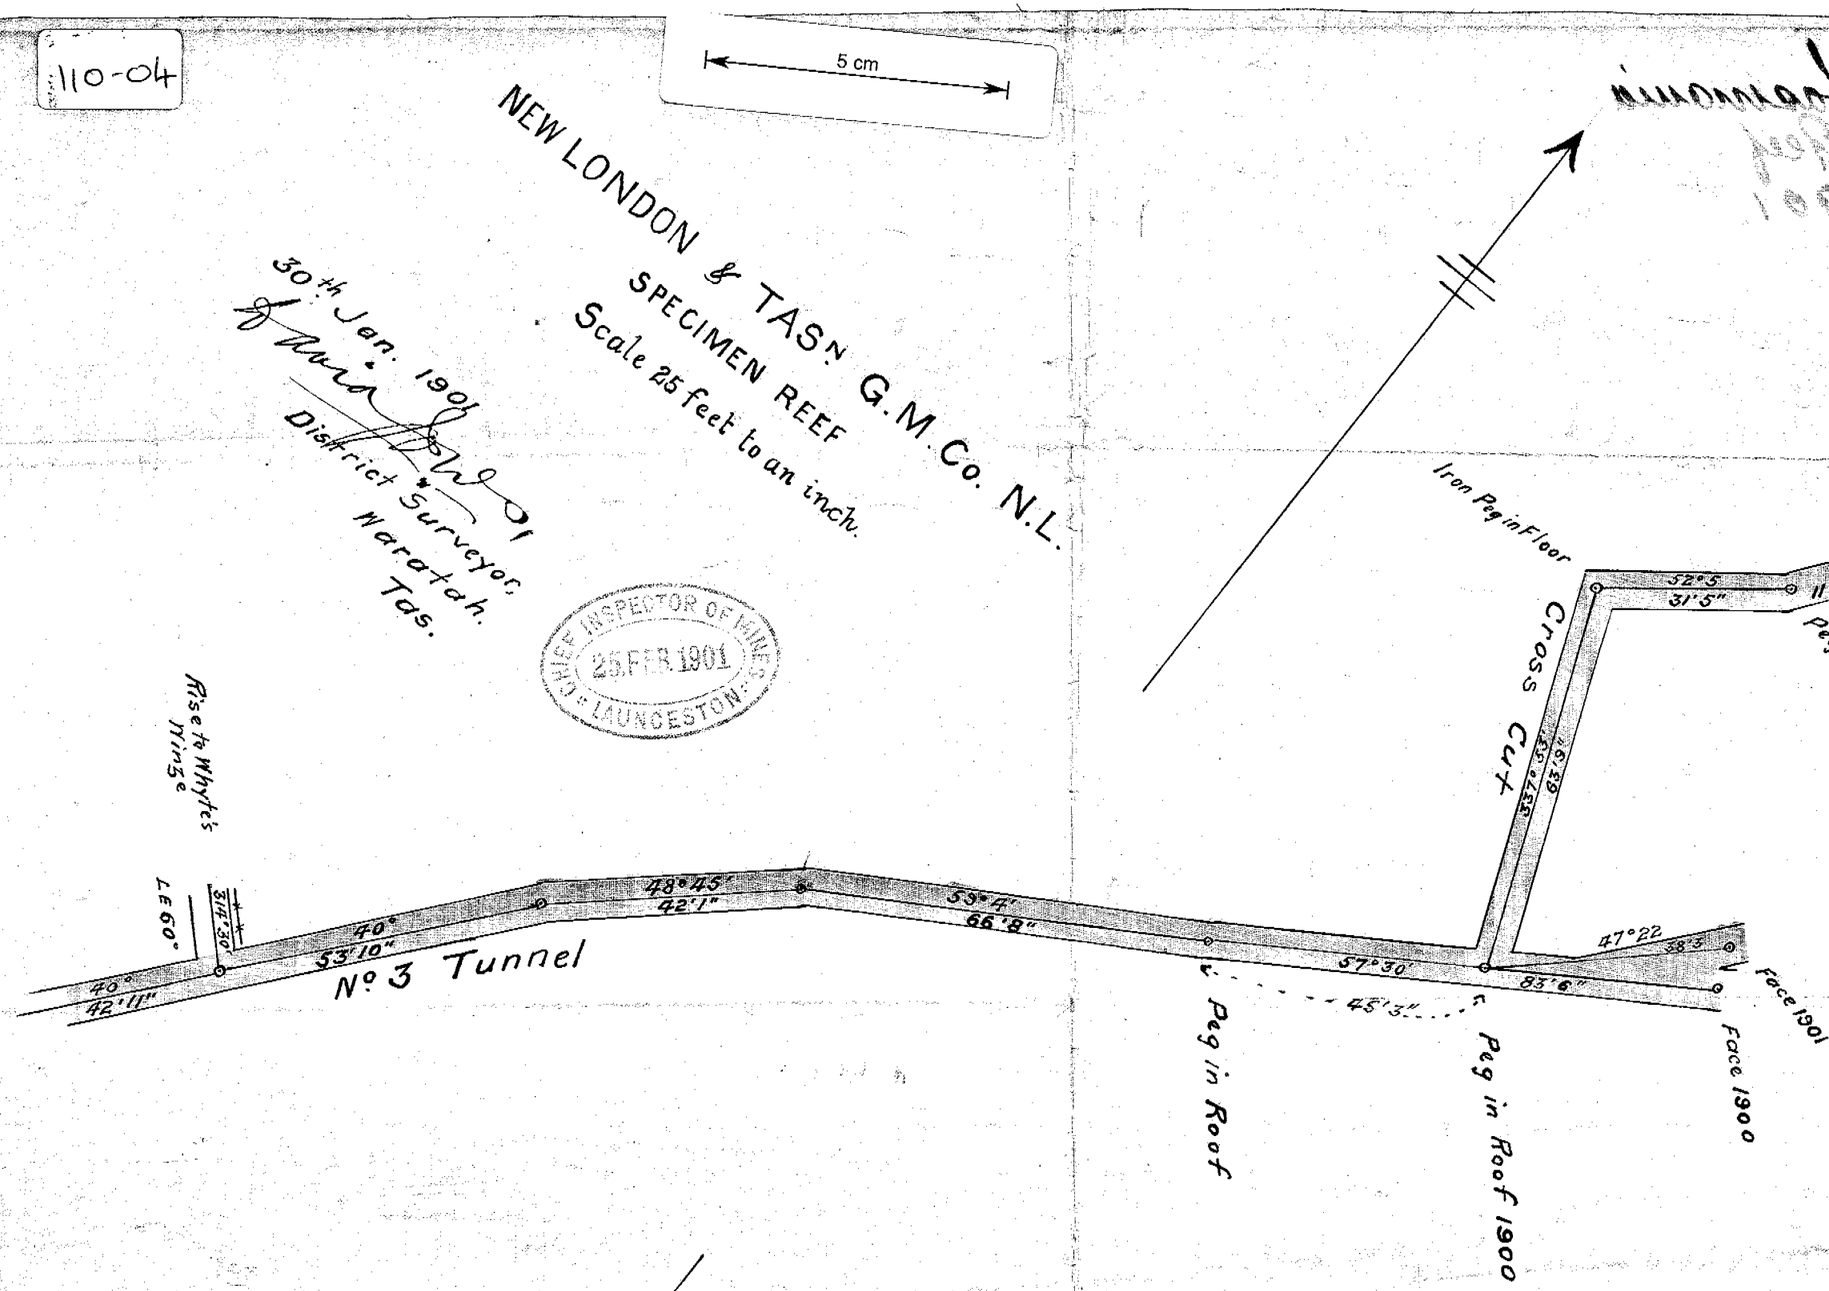
CHIEF INSPECTOR OF MINES
25 FEB 1901
LAUNCESTON