


MOONLIGHT GOLD MINING COMPANY

NO LIABILITY BEAconsfield

PLAN OF UNDERGROUND WORKINGS

Scale of 25 feet to one inch.

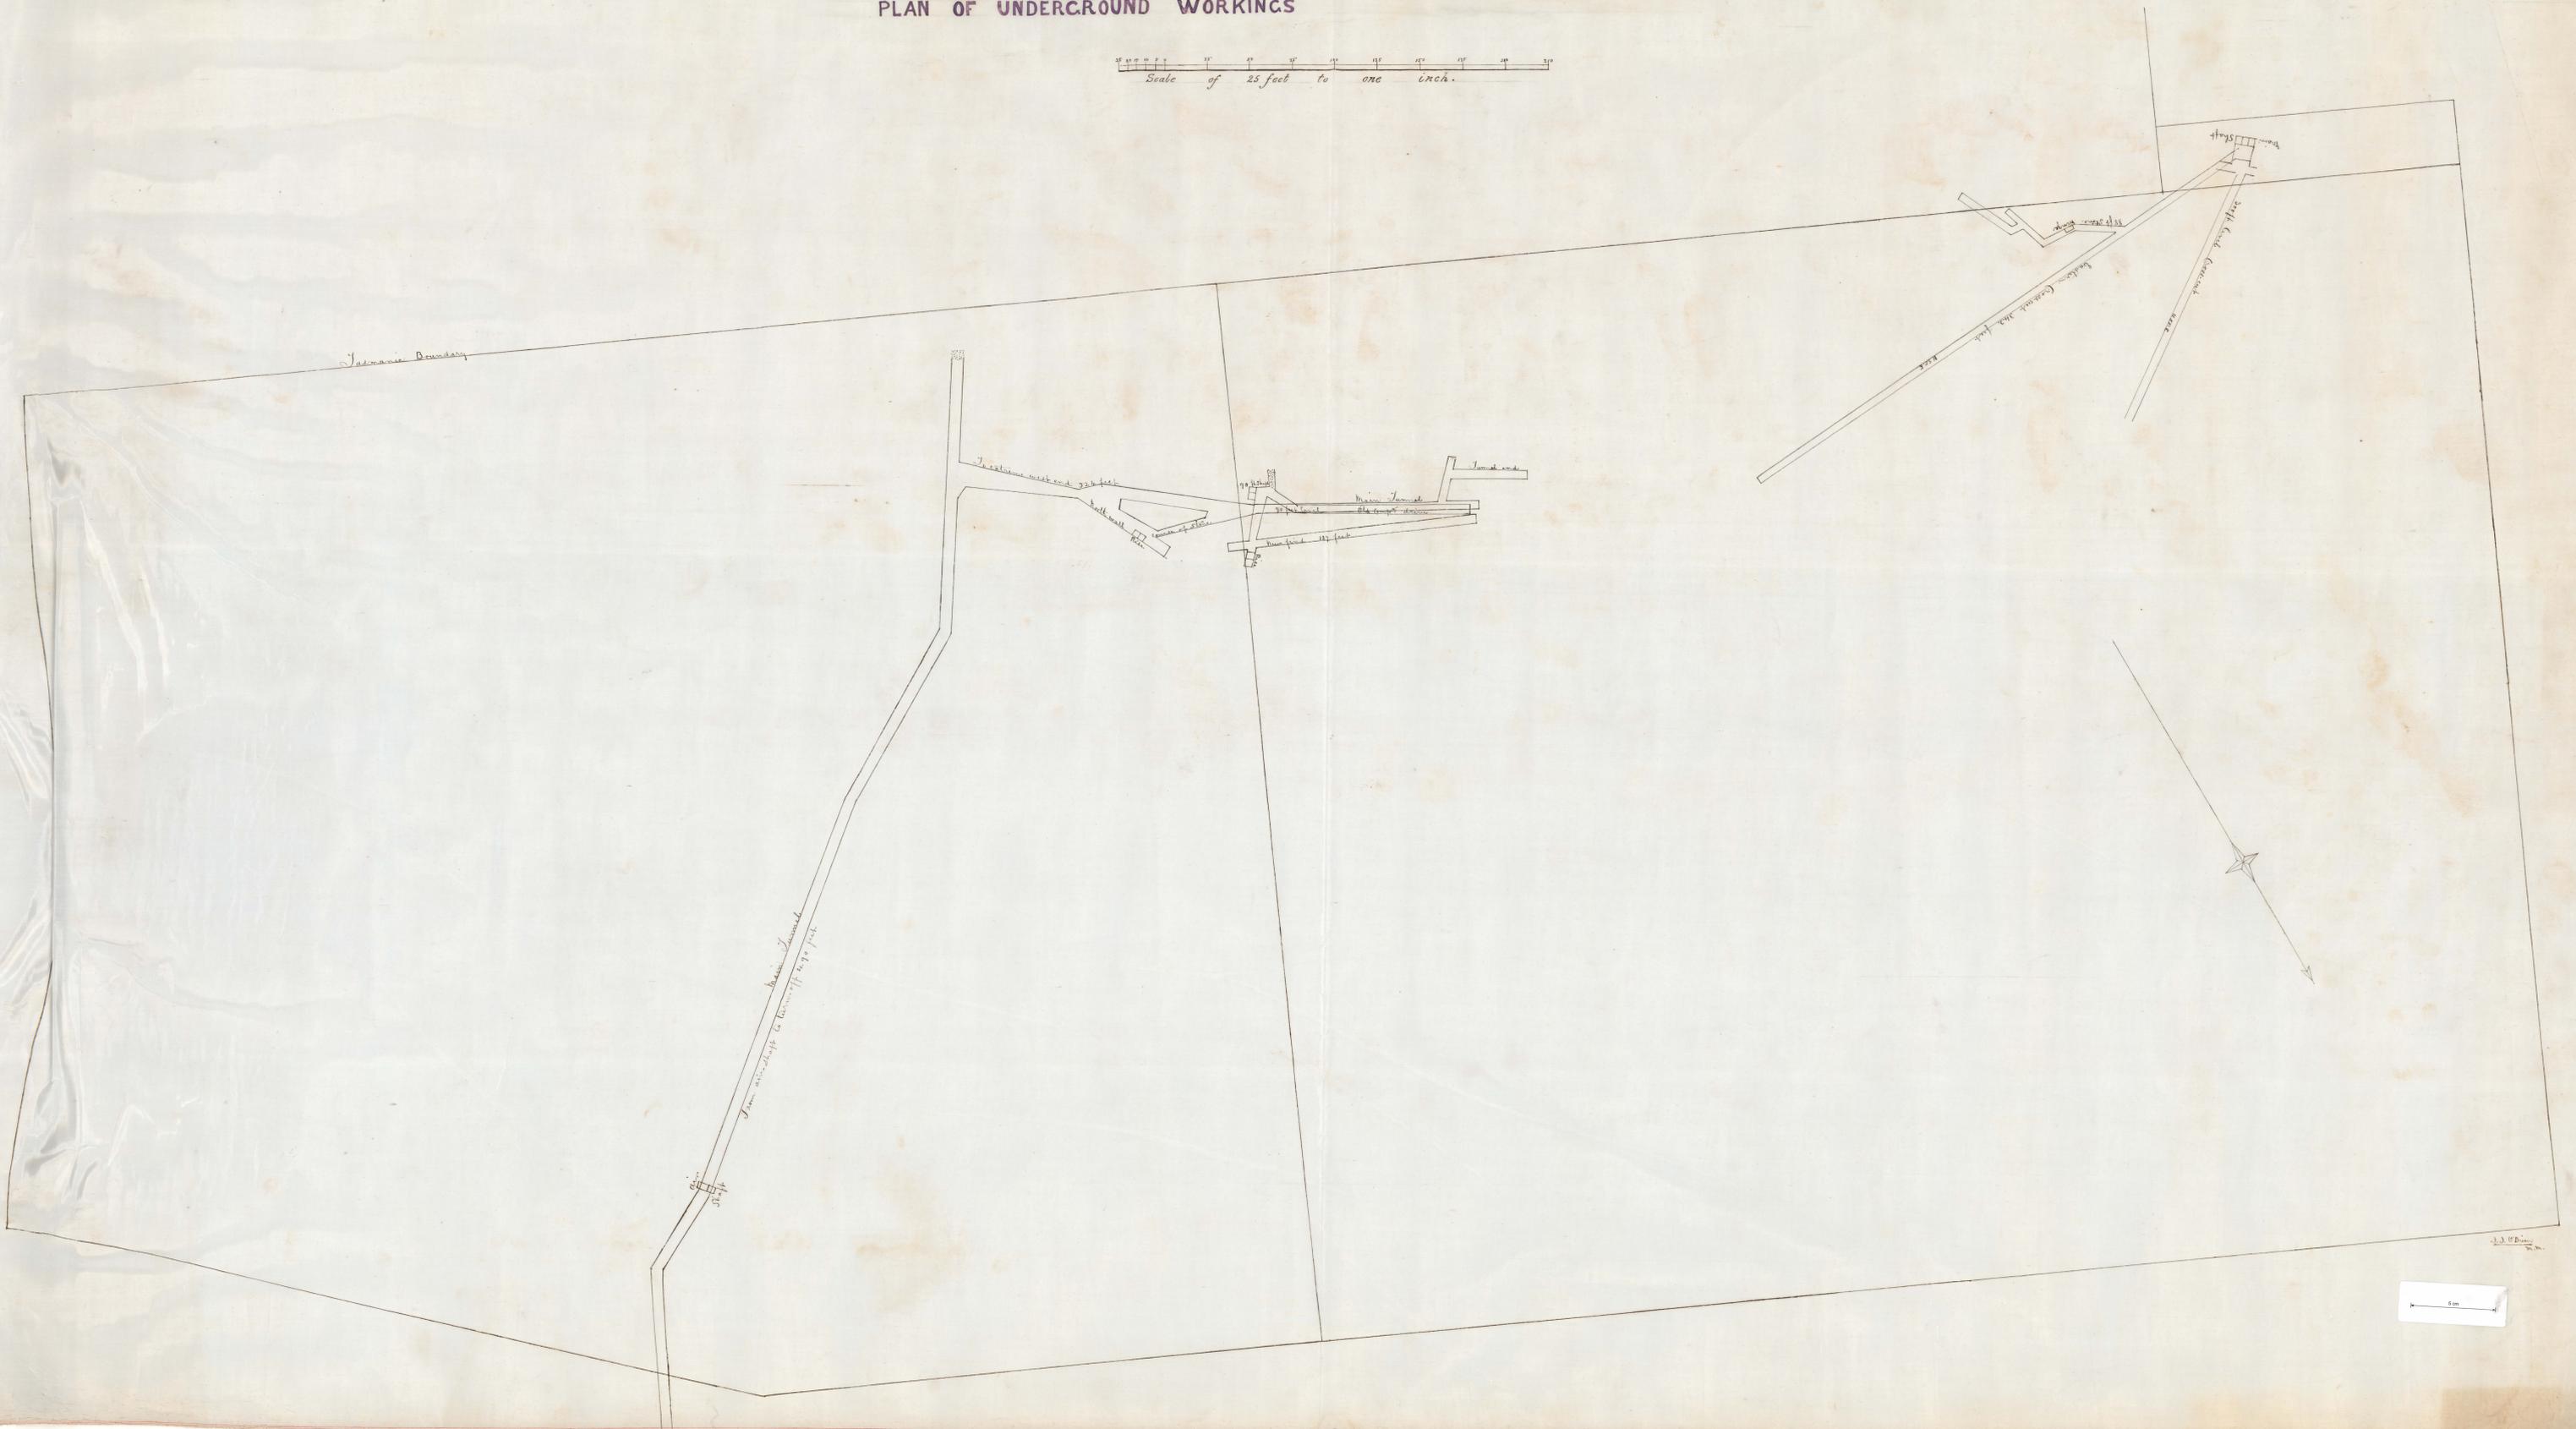

50m