LITTLE WONDER G.M.

Scale 4 inches to 100 feet.

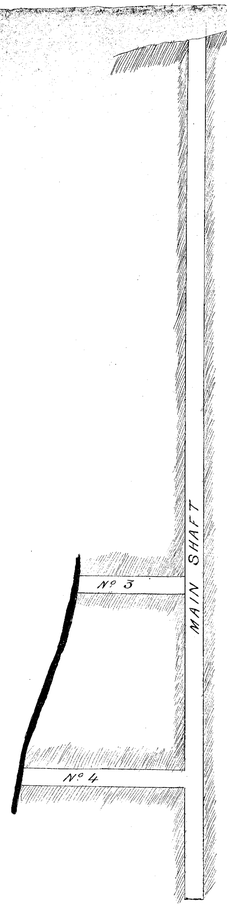

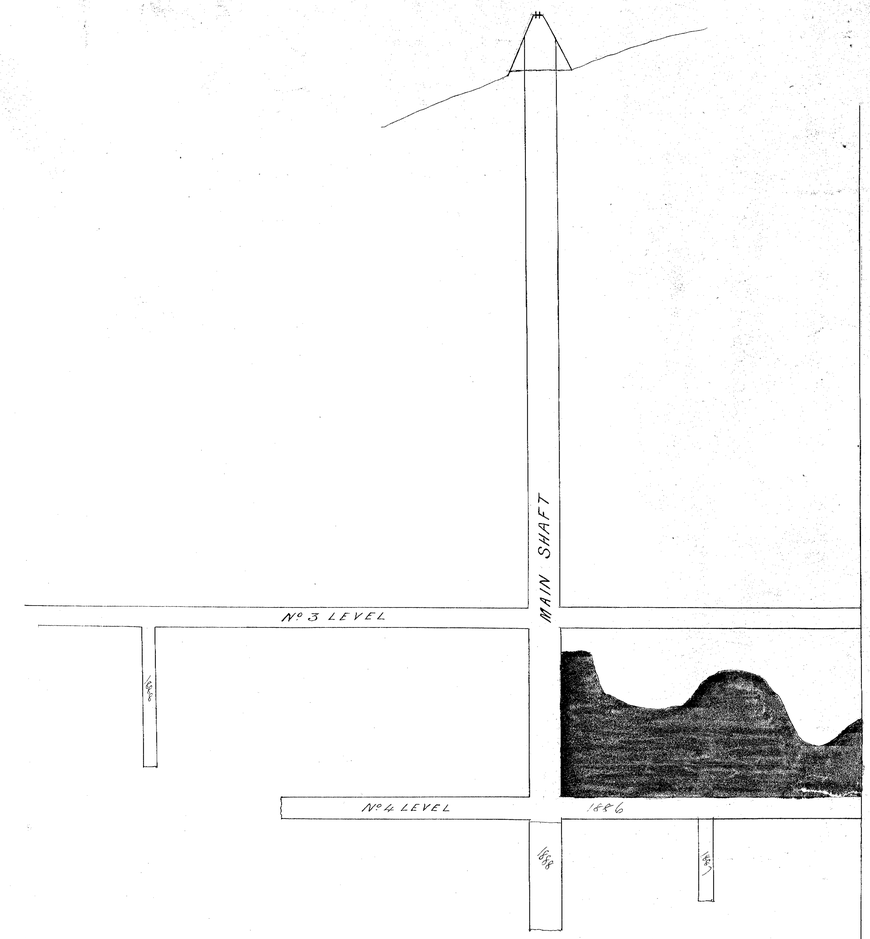

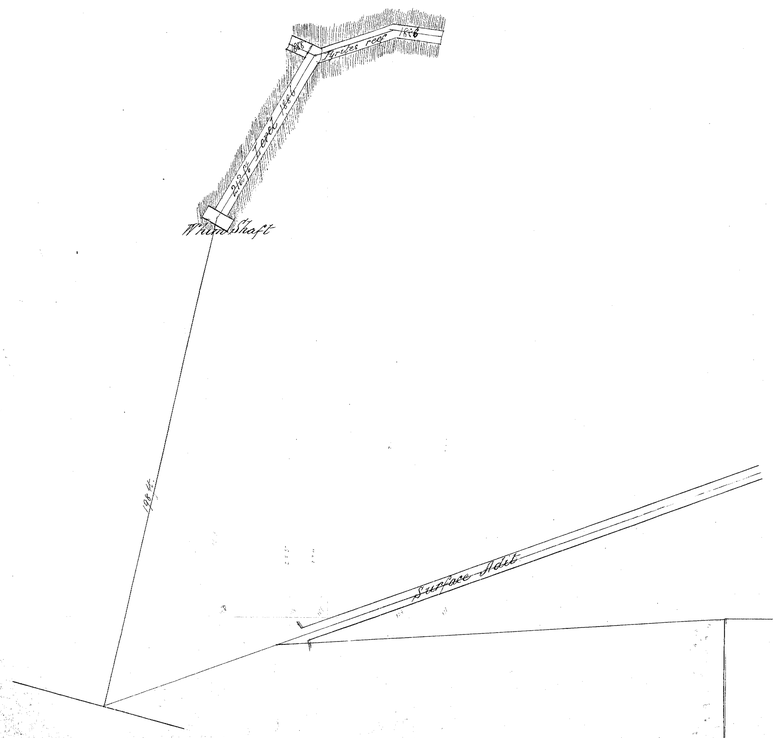
1886
Winze 100'
