


CROSS SECTION LOOKING NORTH

Scale:- 25 FEET TO AN INCH

121-03

5 cm

121-03

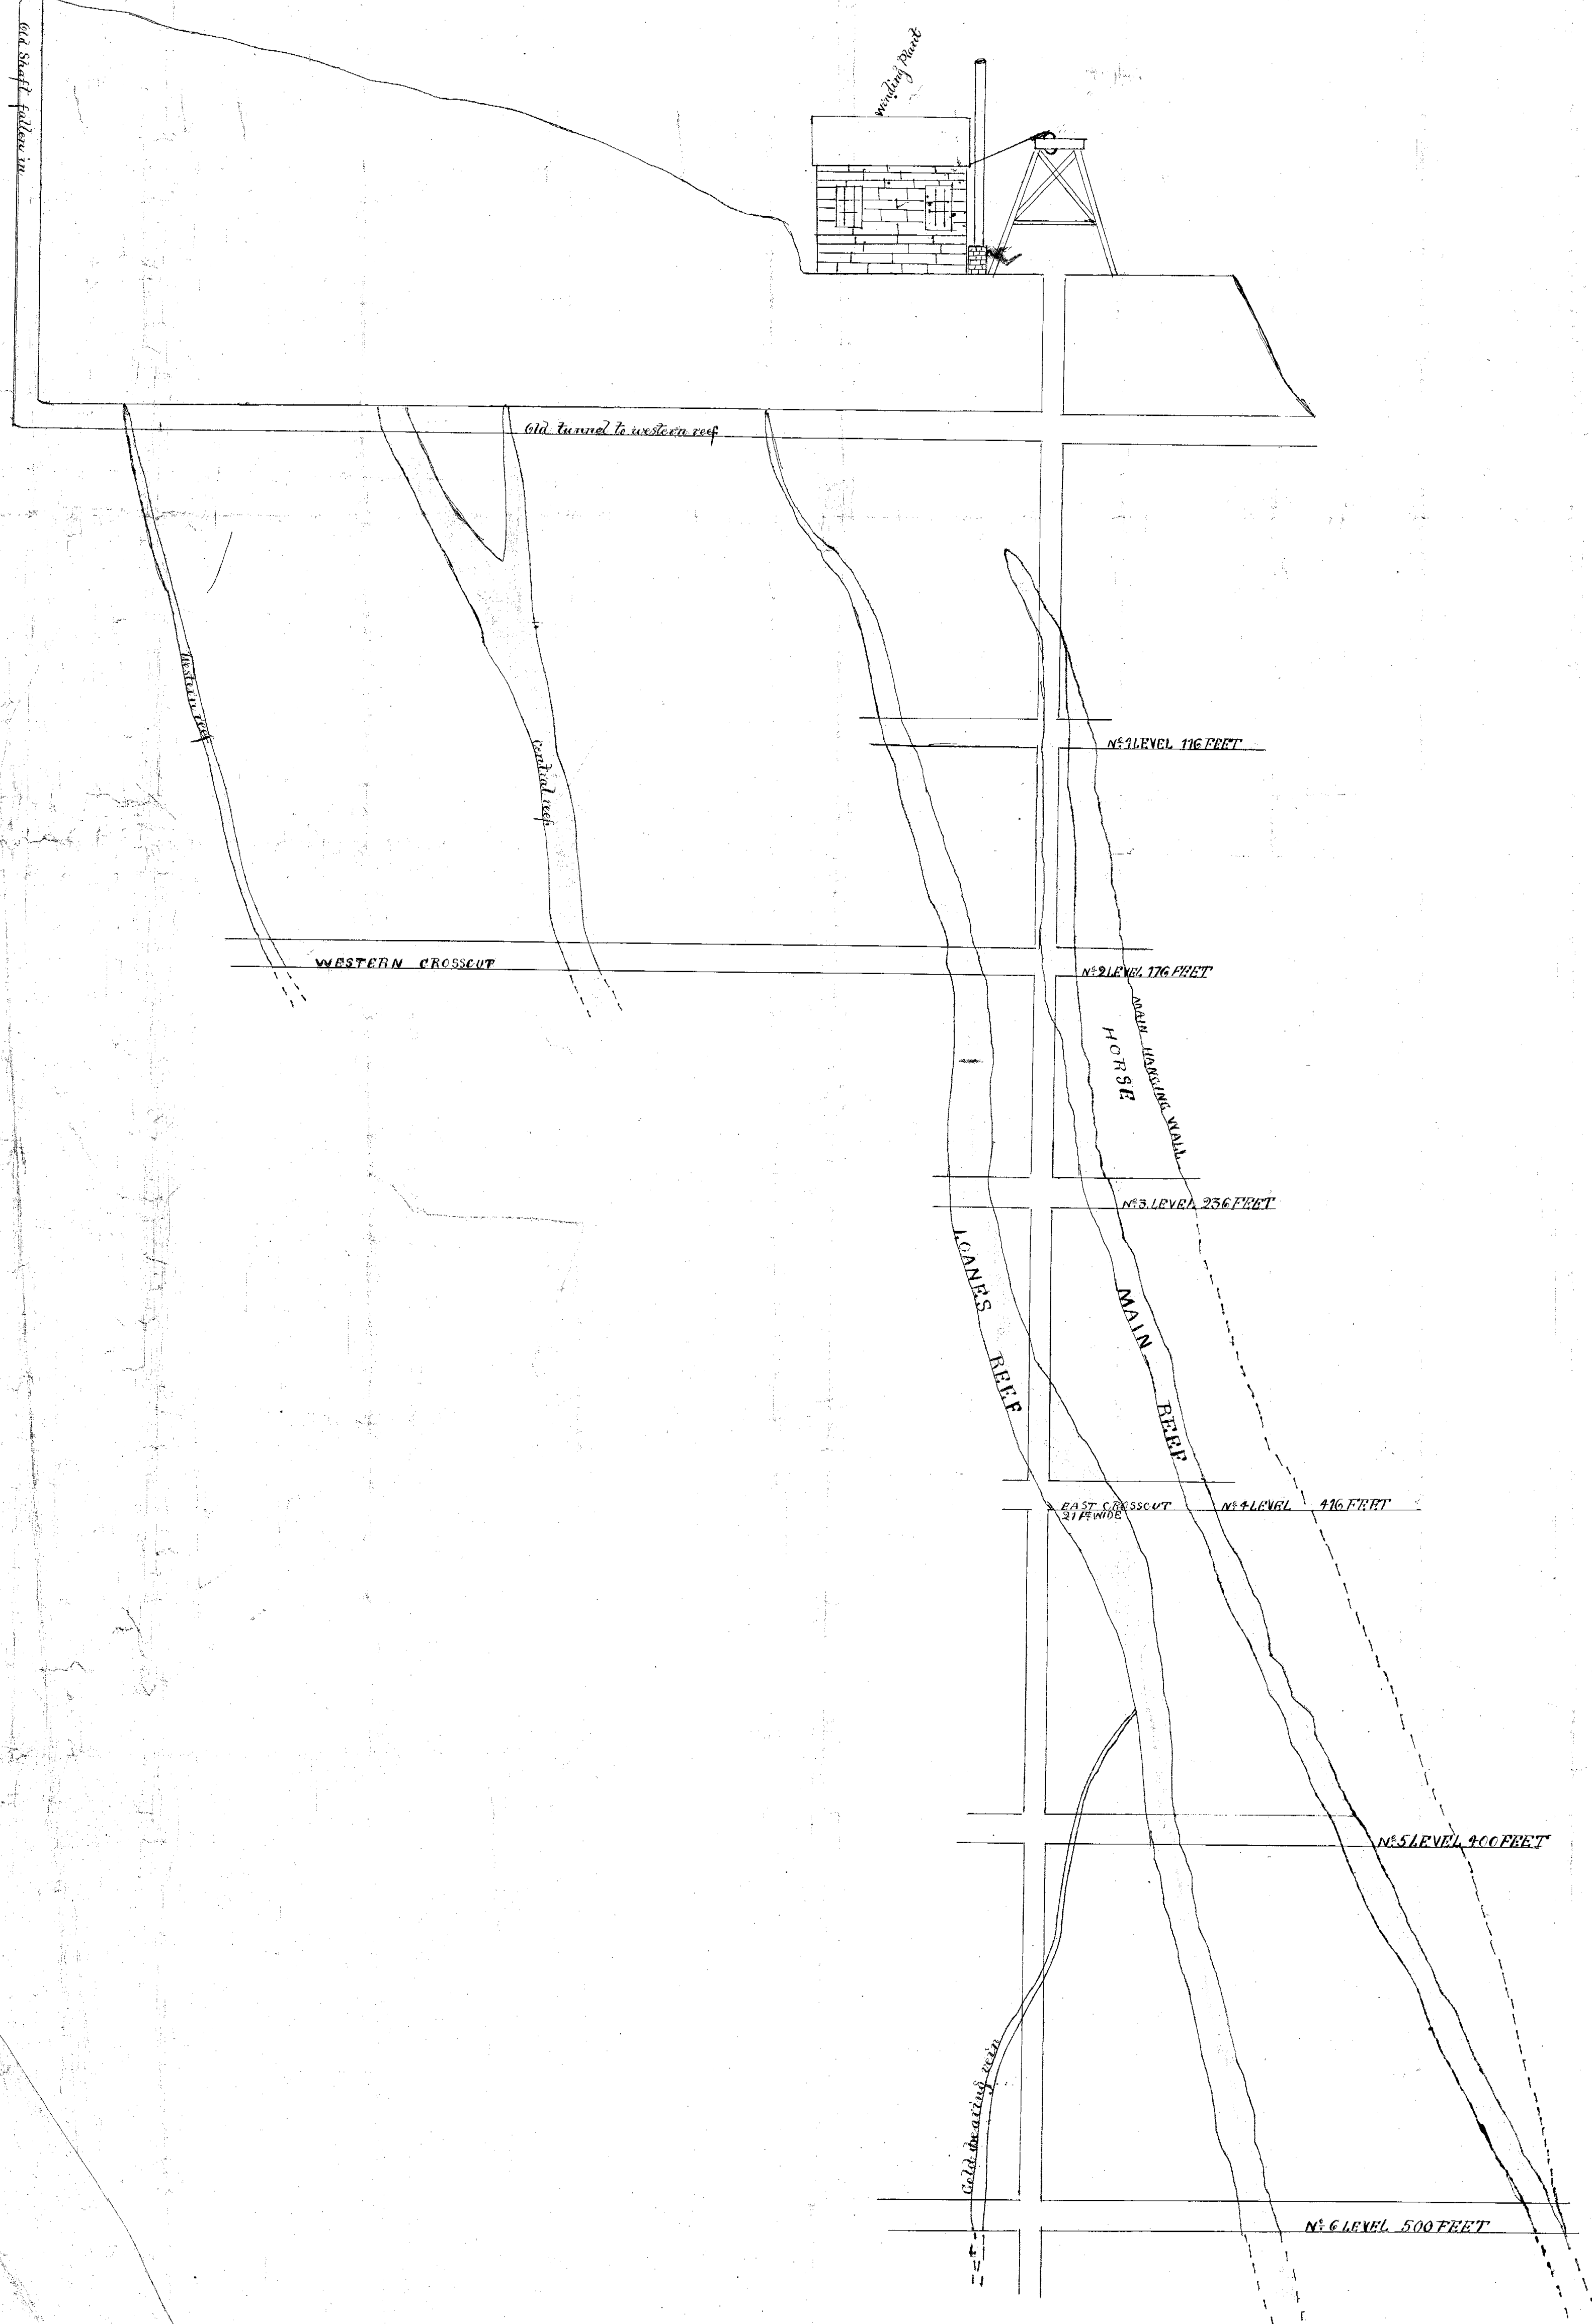

24