121-04

121-04

5 cm

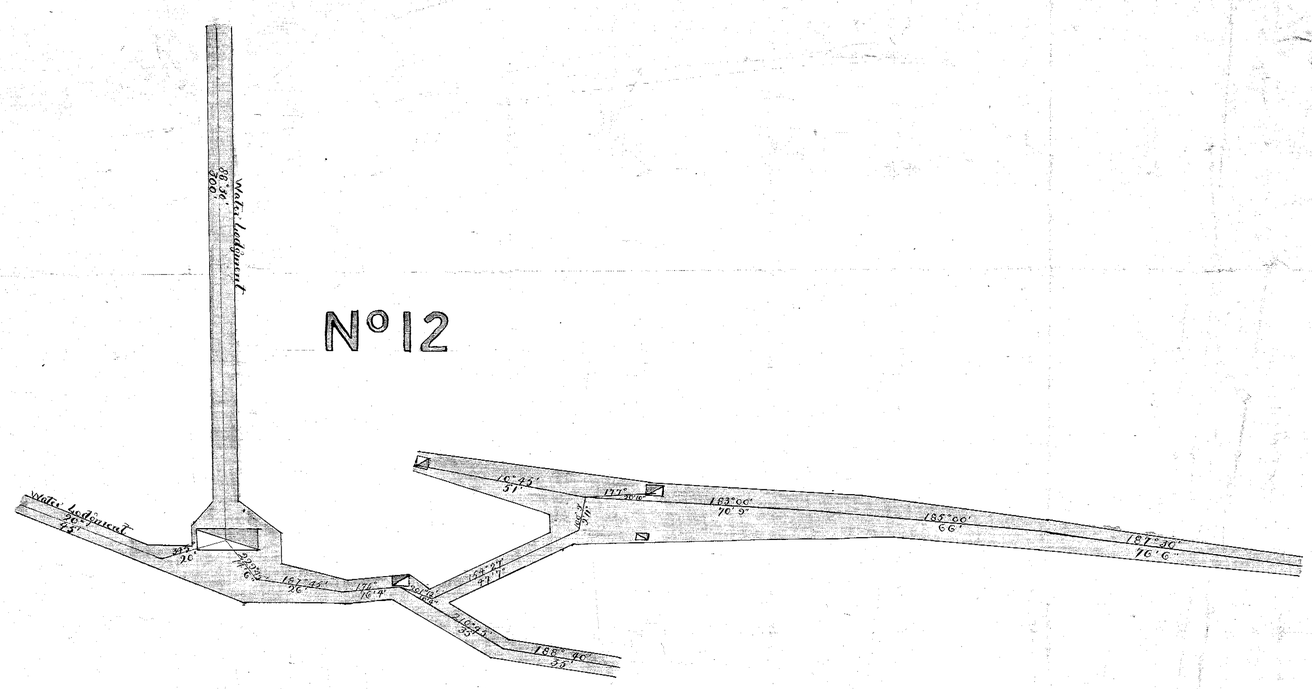

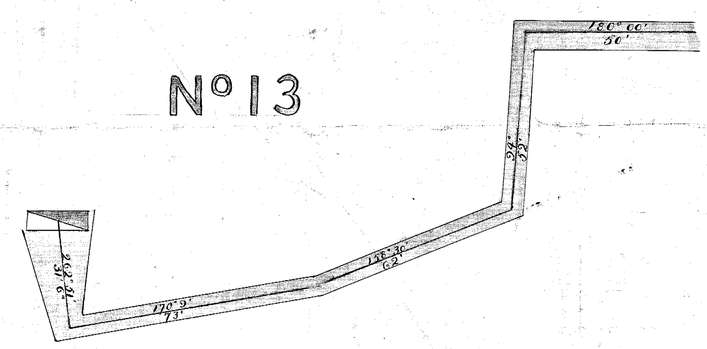

NEW GOLDEN GATE G M

Scale:- 25 Feet to one inch.

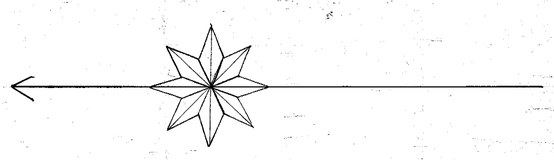

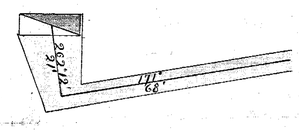

Thos Andrews.
Mine Manager
April 17th 1899

1233