PLAN
NEW GOLDEN GATE

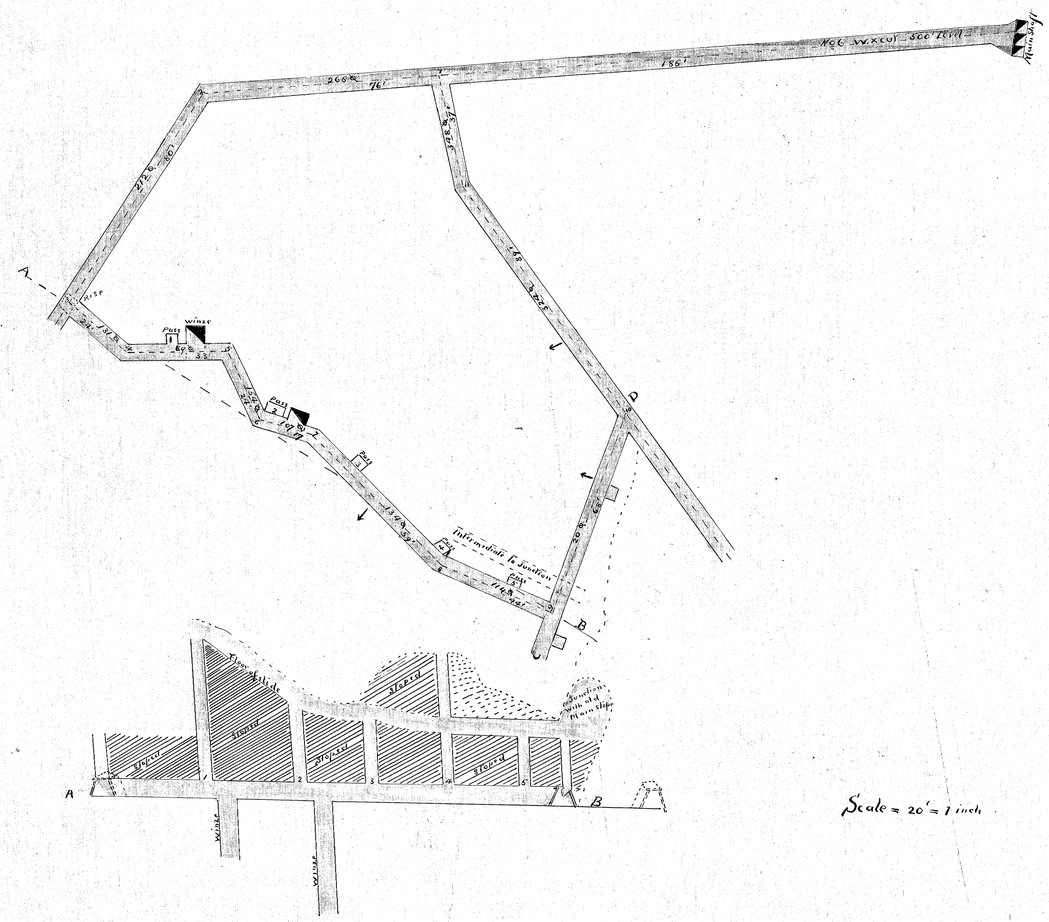

Longitudinal Section between A.B.

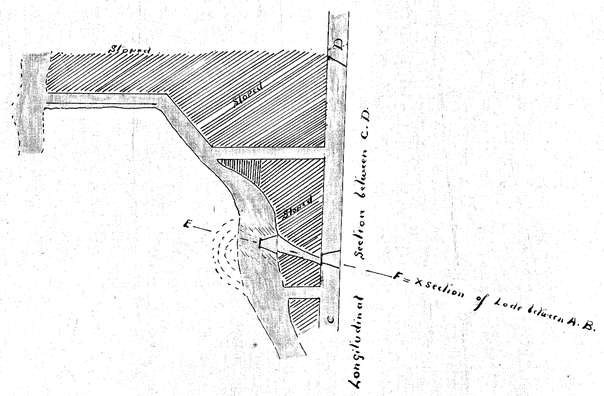

Scale = 20' = 1 inch

F.W. Brannan
March 7th 1919

121-05

121