121-08
121-08

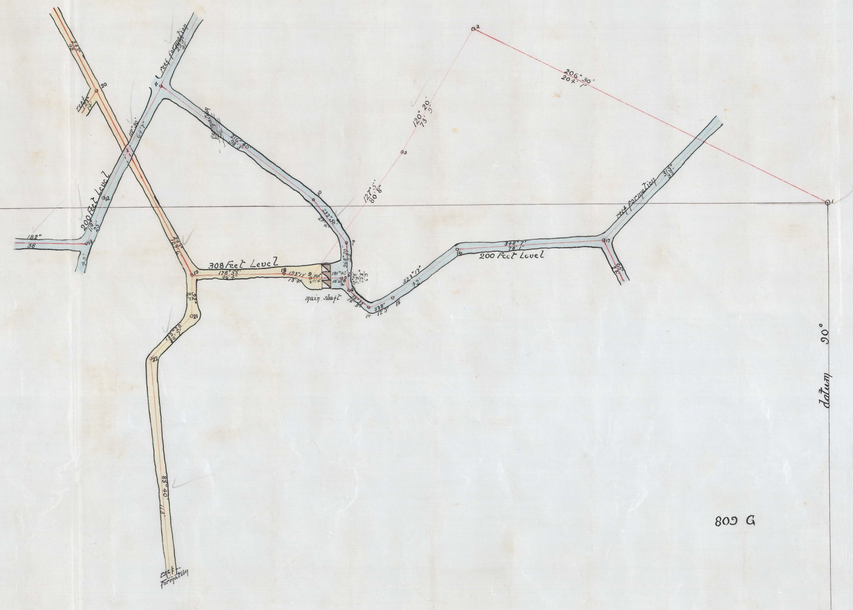

809 G

816 G

NEW GOLDEN GATE

EAST SECTION

Scale 25 Feet to one inch

Surveyed with Transit Theodolite
F. J. Anderson
Mine Manager
February 18th 1910

810 G

5 cm