


121-12

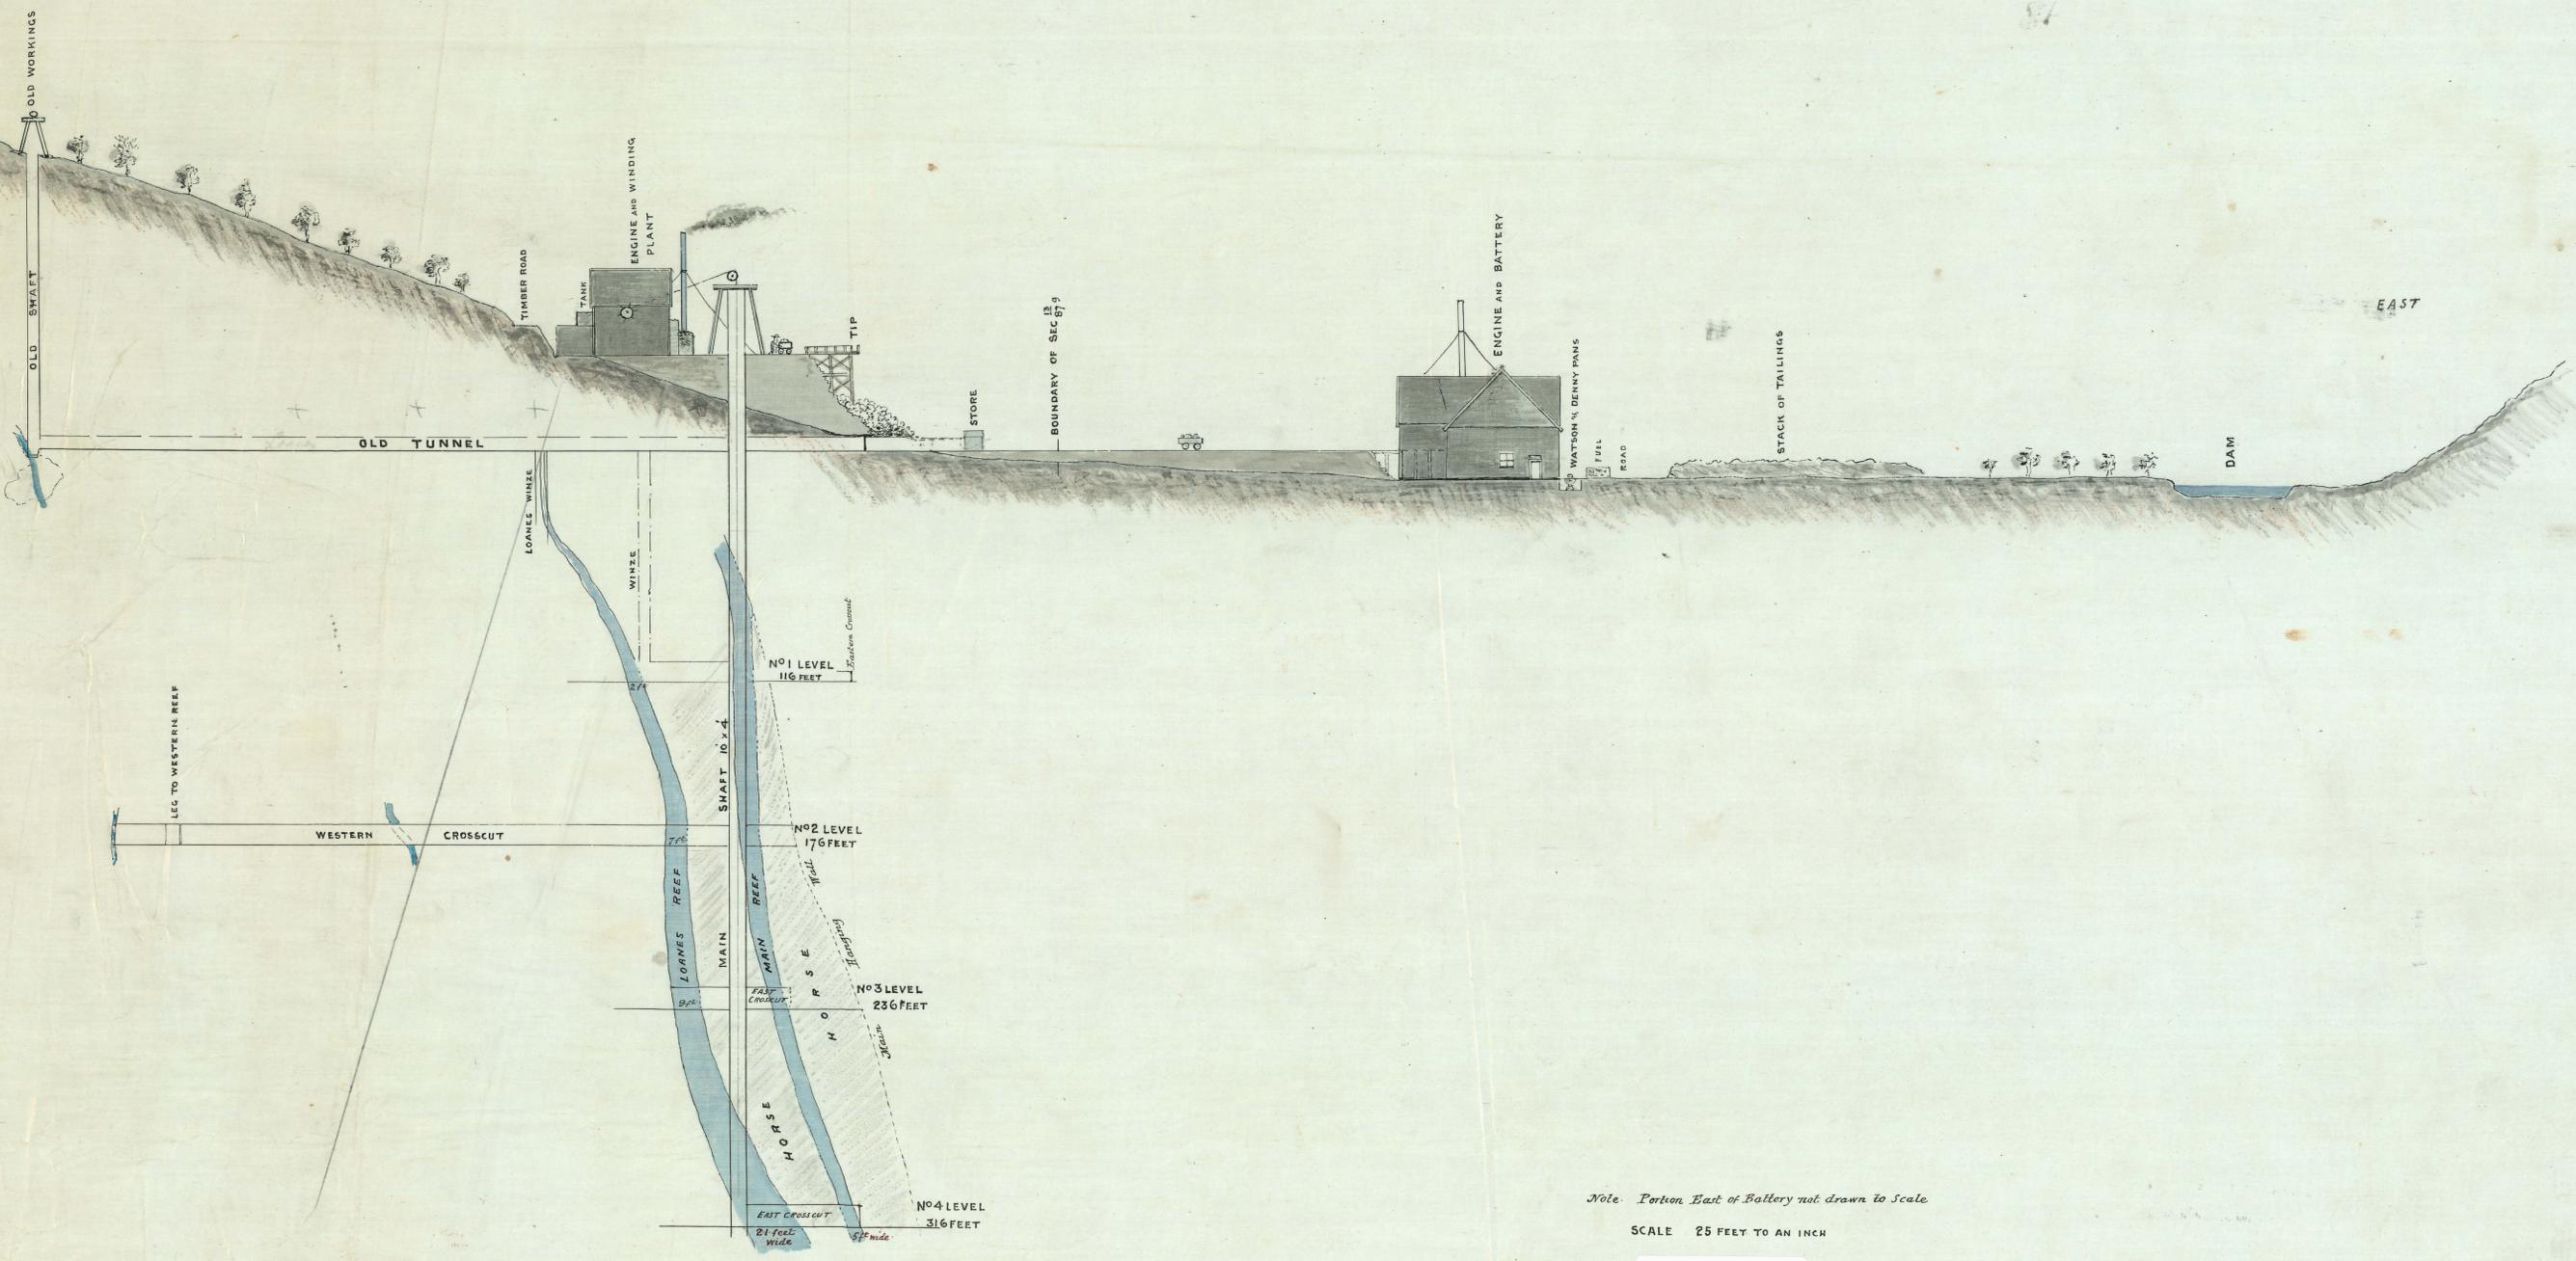

Note. Portion East of Battery not drawn to Scale

SCALE 25 FEET TO AN INCH

