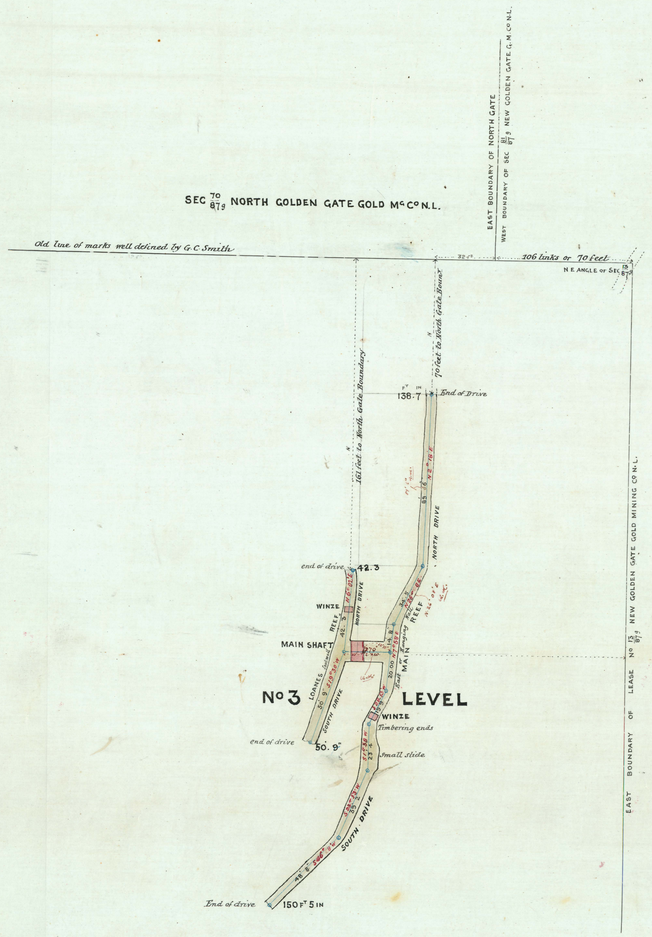
SEC 70/87.9 NORTH GOLDEN GATE GOLD McCo N.L.
EAST BOUNDARY OF NORTH GATE
WEST BOUNDARY OF SEC 87.9 NEW GOLDEN GATE G.M.CO N.L.
Old line of marks well defined by G.C. Smith
206 links or 70 feet
N.E. ANGLE OF SEC 87.9
End of Drive
138.7
151 feet to North Gate Boundary
70 feet to North Gate Reserve
NORTH DRIVE
end of drive
42.3
WINZE
MAIN SHAFT
MAIN
No 3 LEVEL
WINZE
Timbering ends
end of drive
50.9
small slide
SOUTH DRIVE
End of drive
150 FT 5 IN
EAST BOUNDARY OF LEASE No 87.9 NEW GOLDEN GATE GOLD MINING CO N.L.

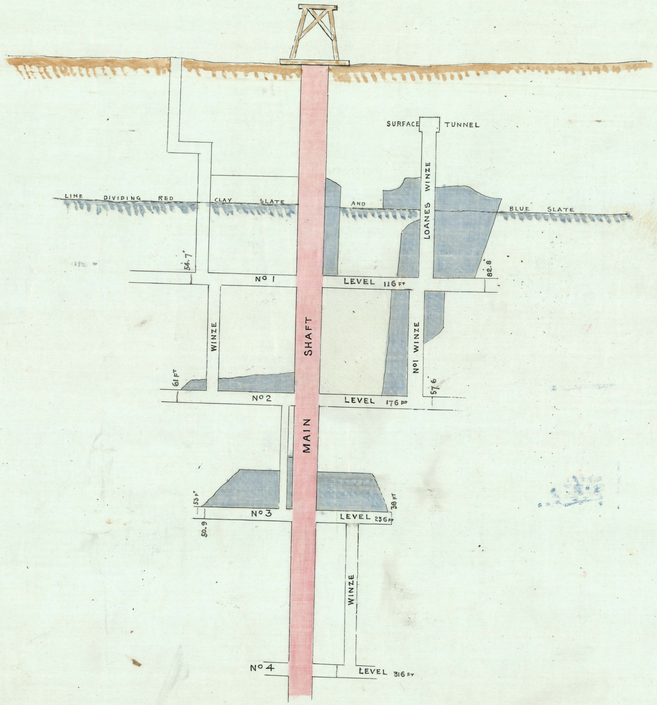
SURFACE TUNNEL
LINE DIVIDING RED CLAY SLATE AND BLUE SLATE
LOANES WINZE
No 1 LEVEL 116 FT
WINZE
No 1 WINZE
MAIN SHAFT
No 2 LEVEL 176 FT
No 3 LEVEL 236 FT
WINZE
No 4 LEVEL 316 FT

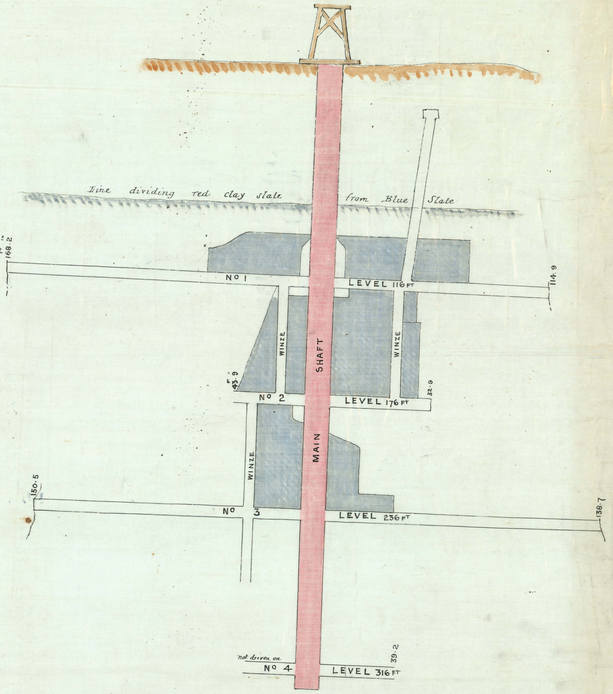
Line dividing red clay slate from Blue Slate
No 1 LEVEL 116 FT
WINZE
WINZE
MAIN SHAFT
No 2 LEVEL 176 FT
WINZE
No 3 LEVEL 236 FT
No 4 LEVEL 316 FT