



LONGITUDINAL SECTIONS

Scale 25 Feet to one inch


MAIN REEF

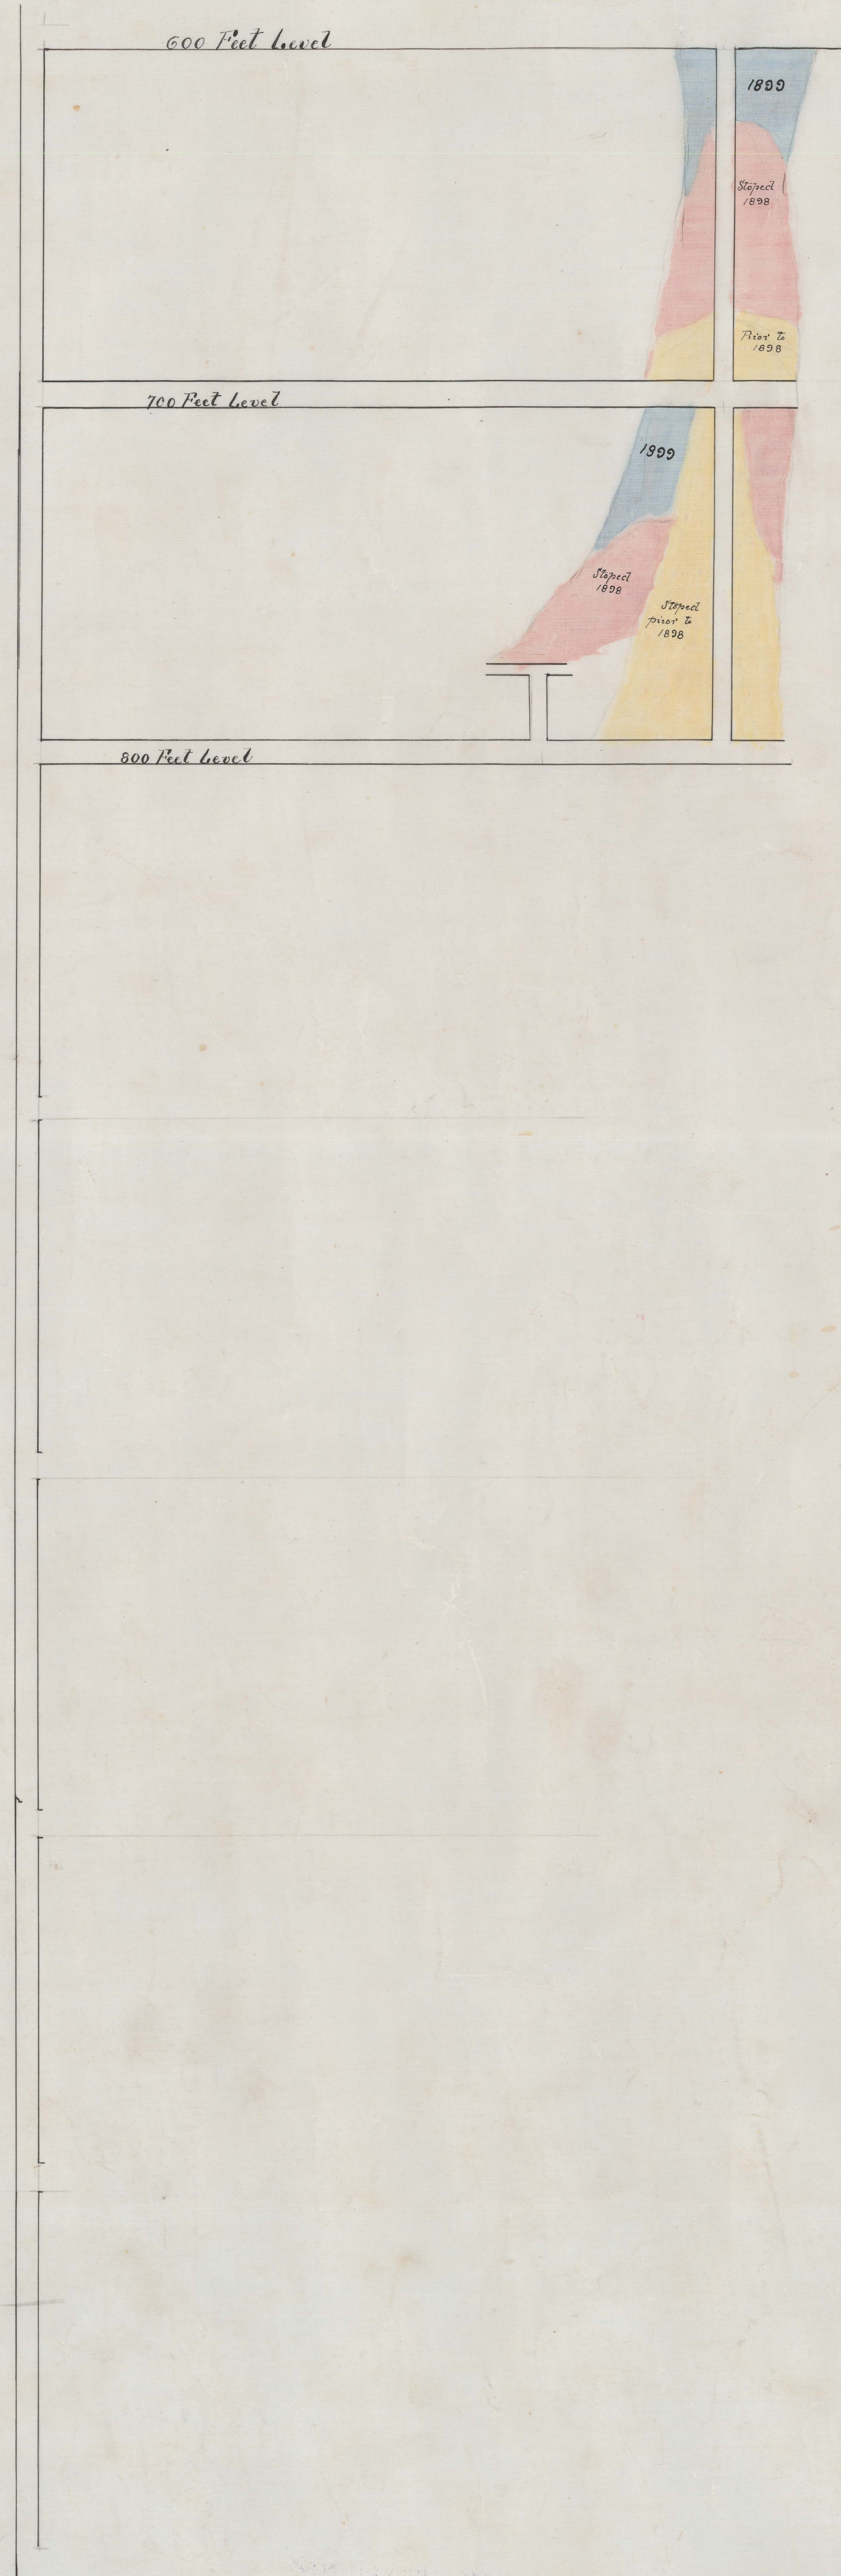

LOANES REEF

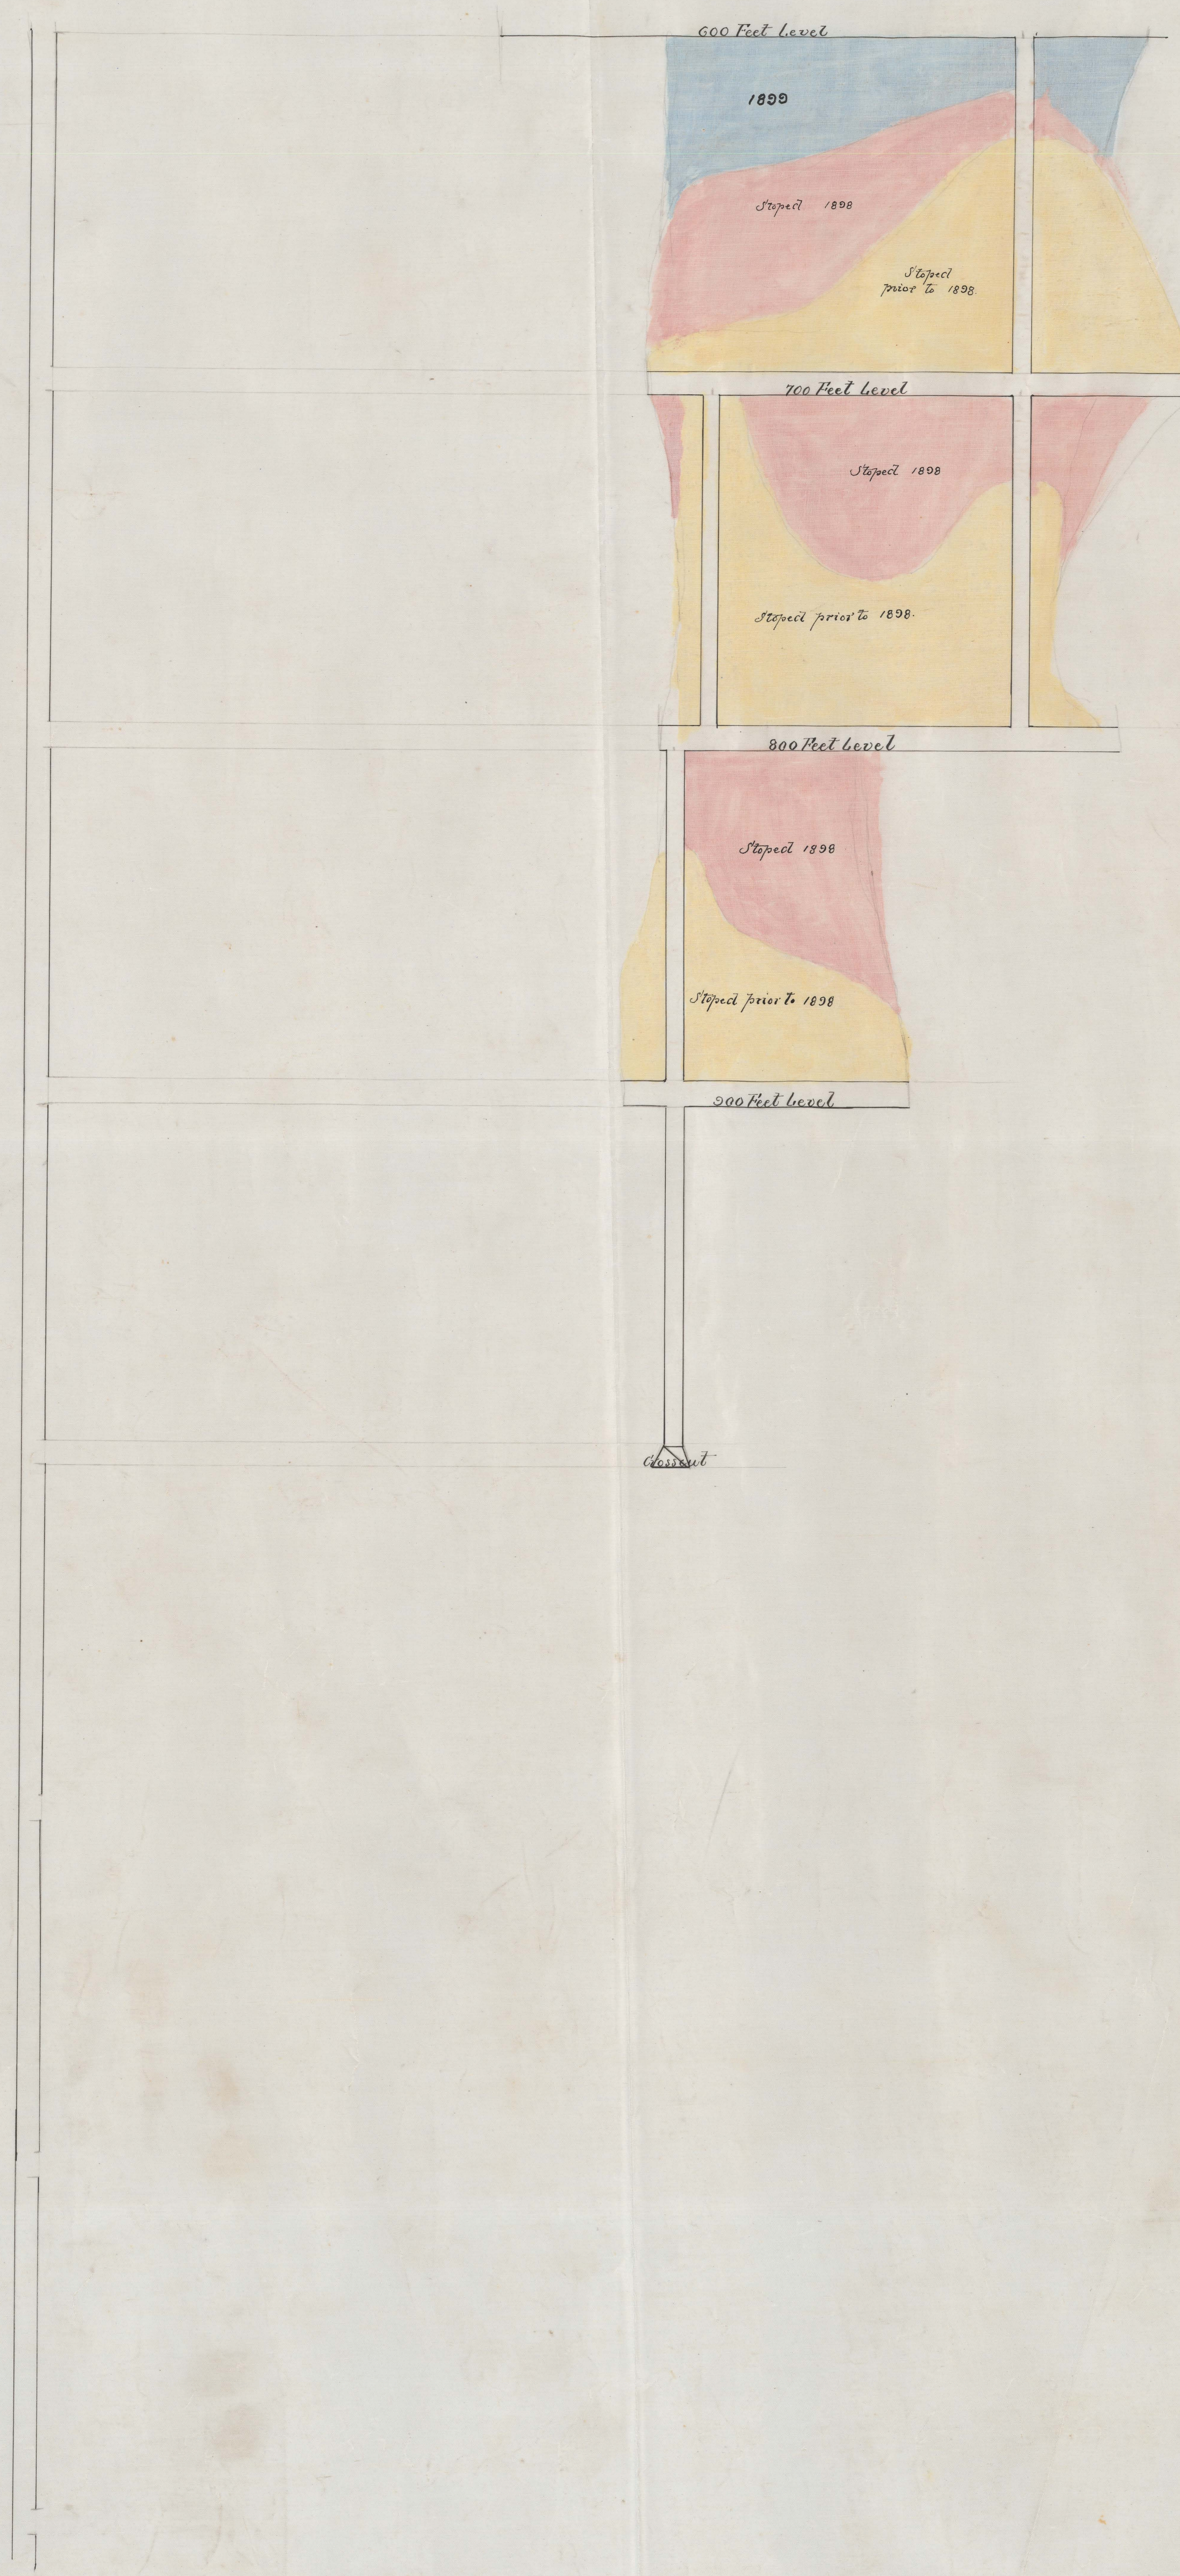

NEW MAKE

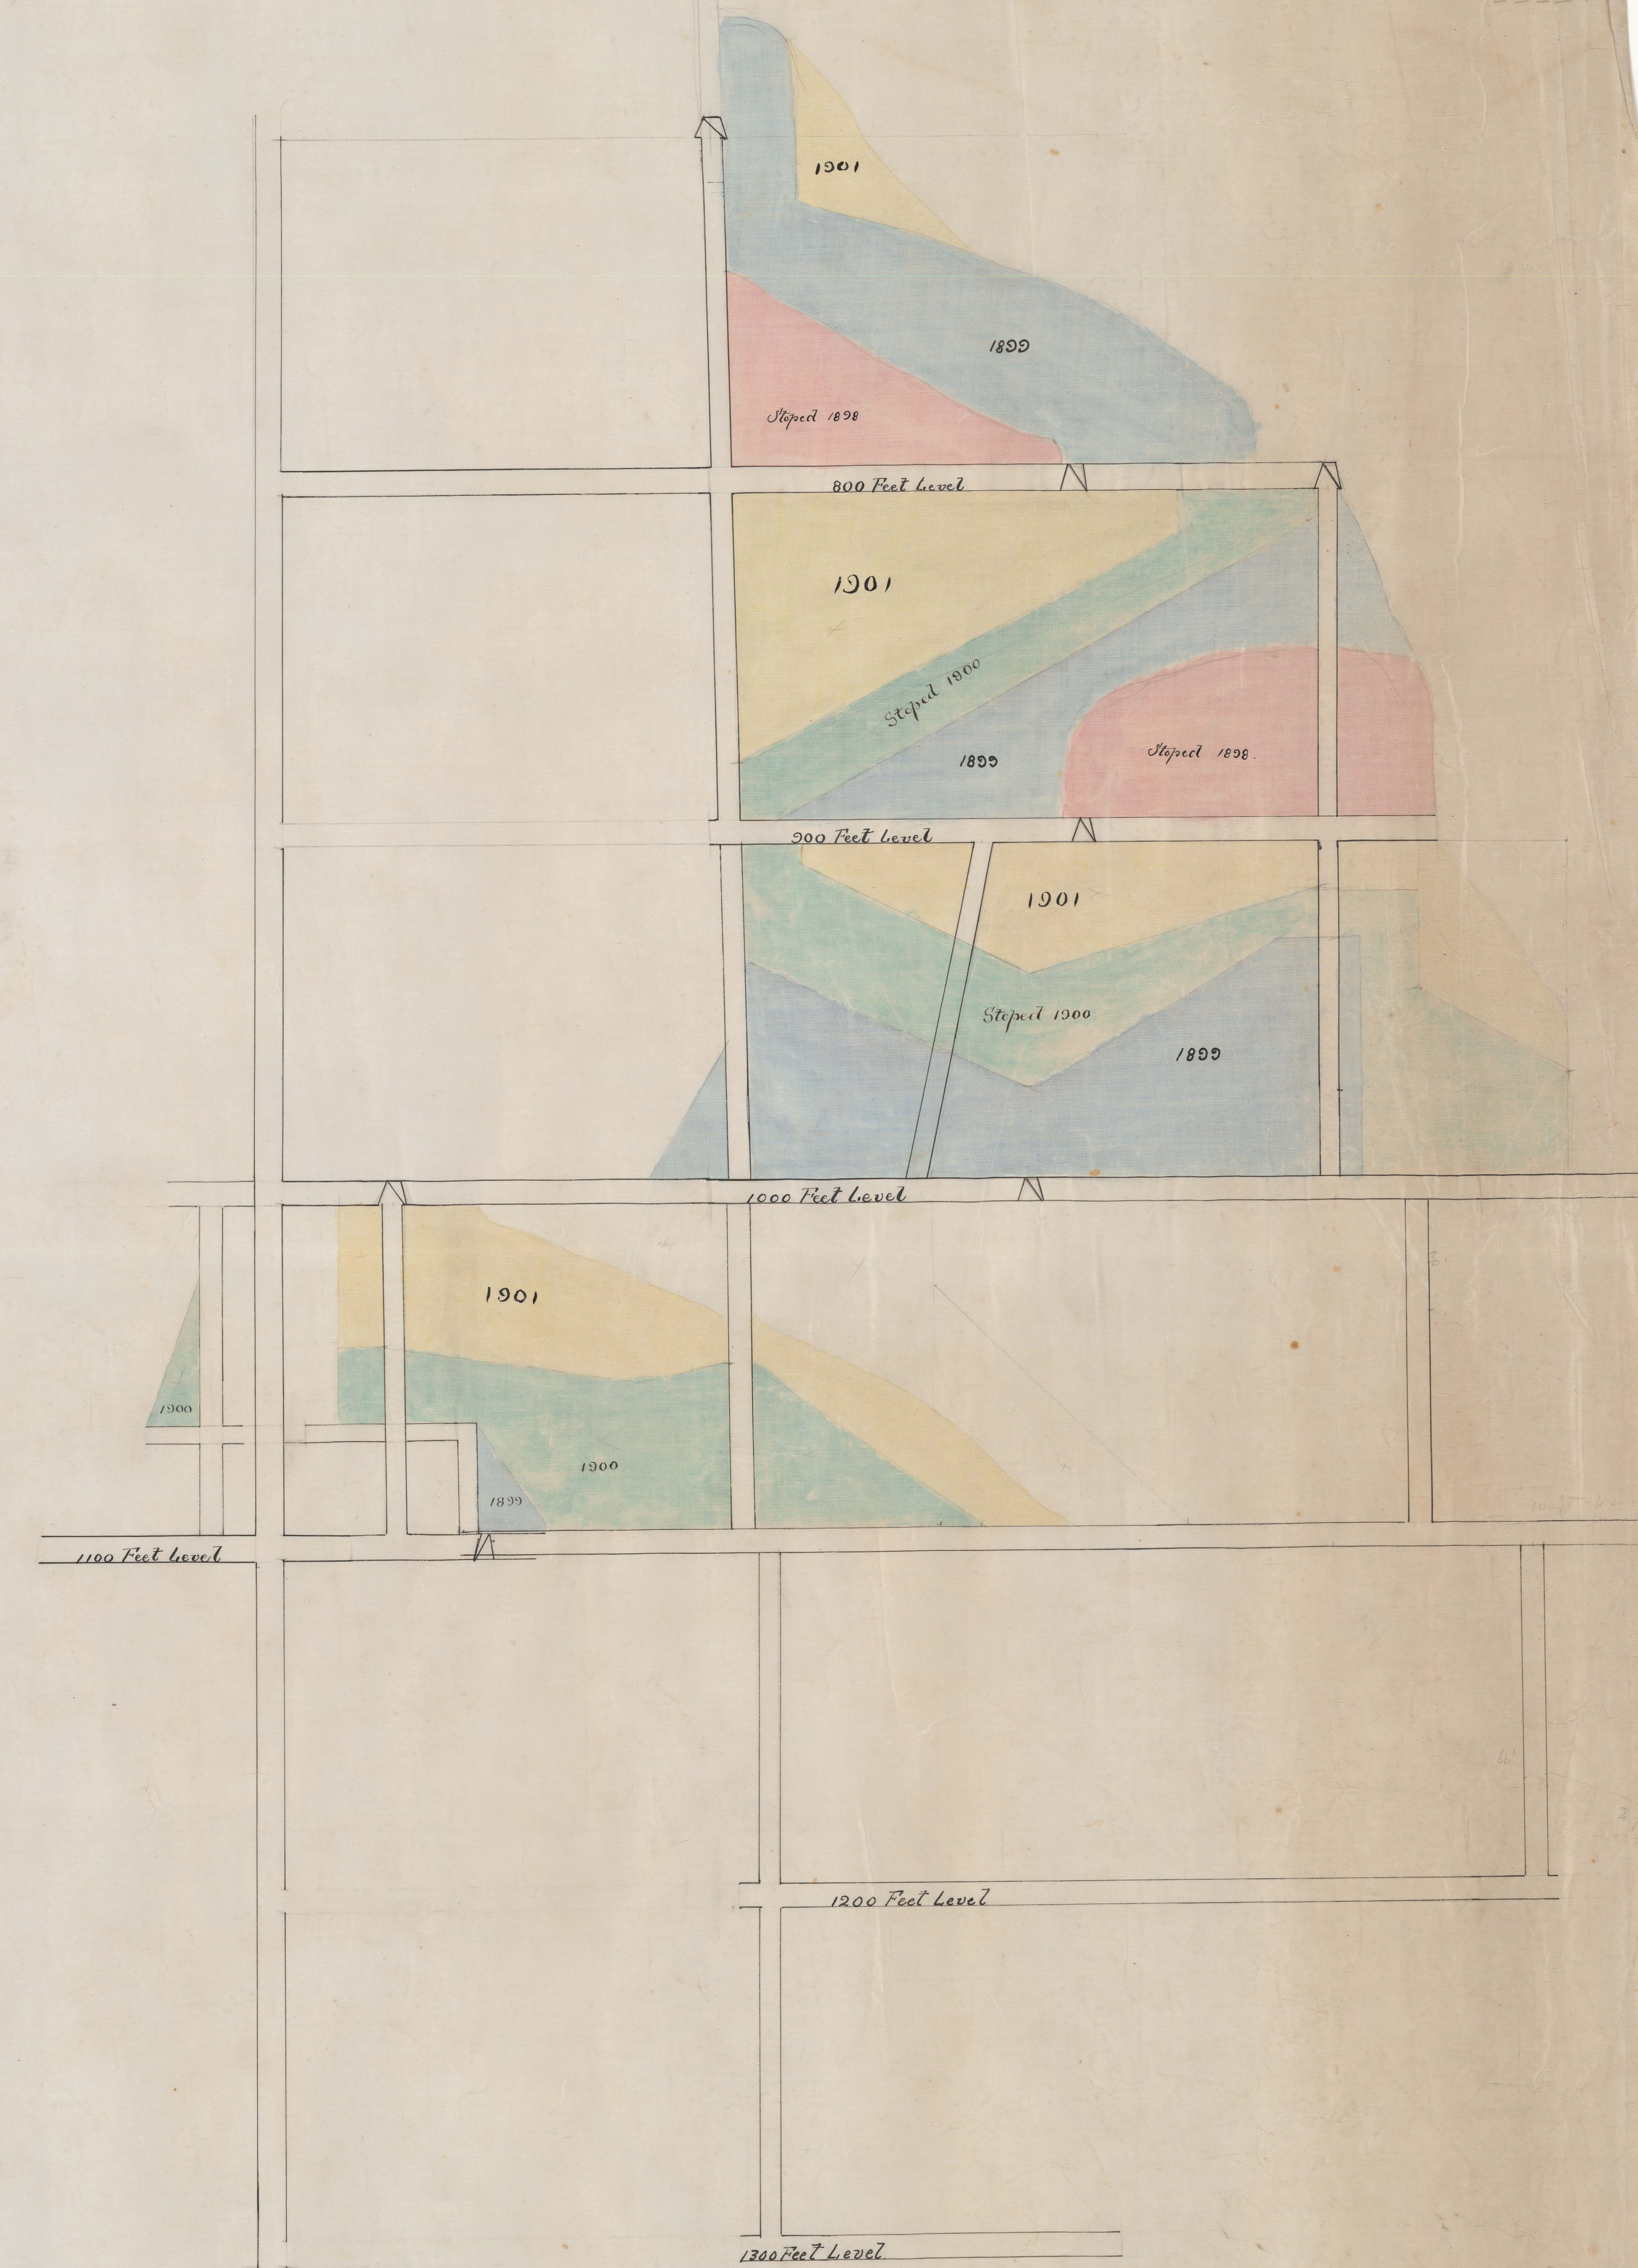

5 cm