North Golden Gate

NEW COLDEN GATE C M Co

MATHINNA

PLAN

Thos Andrews
Mine Manager

January 1st 1894

INSPECTOR OF MINES OFFICE
26/1/94
LAUNCESTON
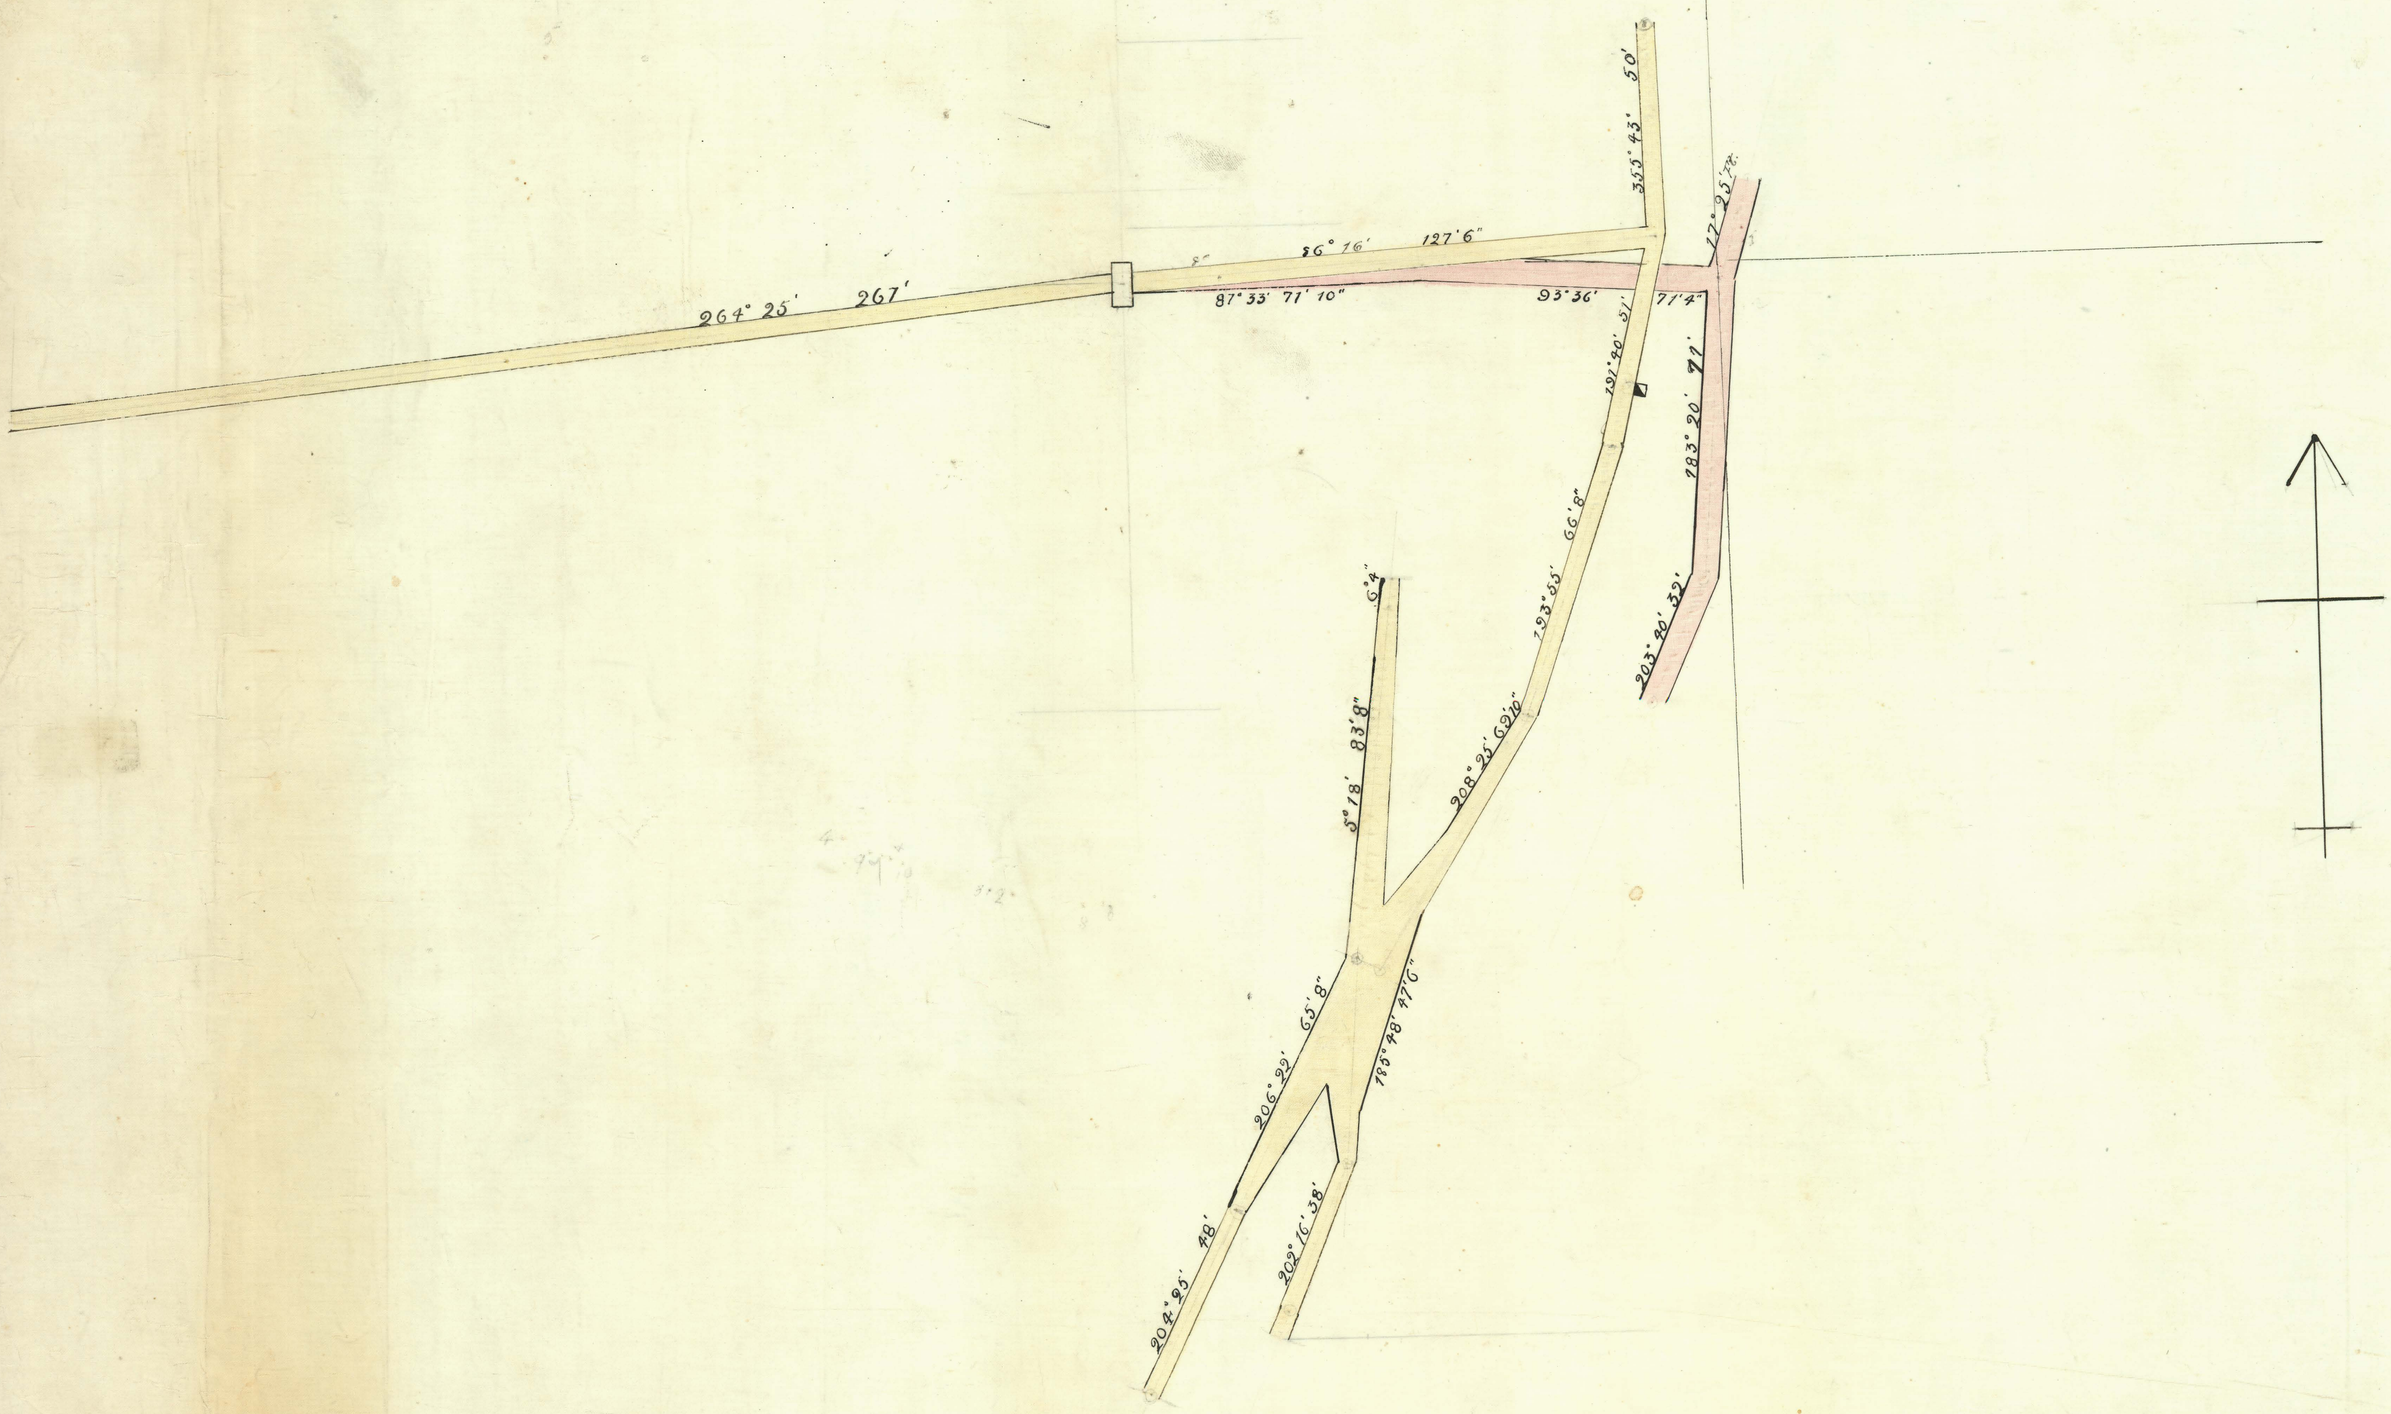
Scale – 25 feet to one inch