


LONGITUDINAL SECTION

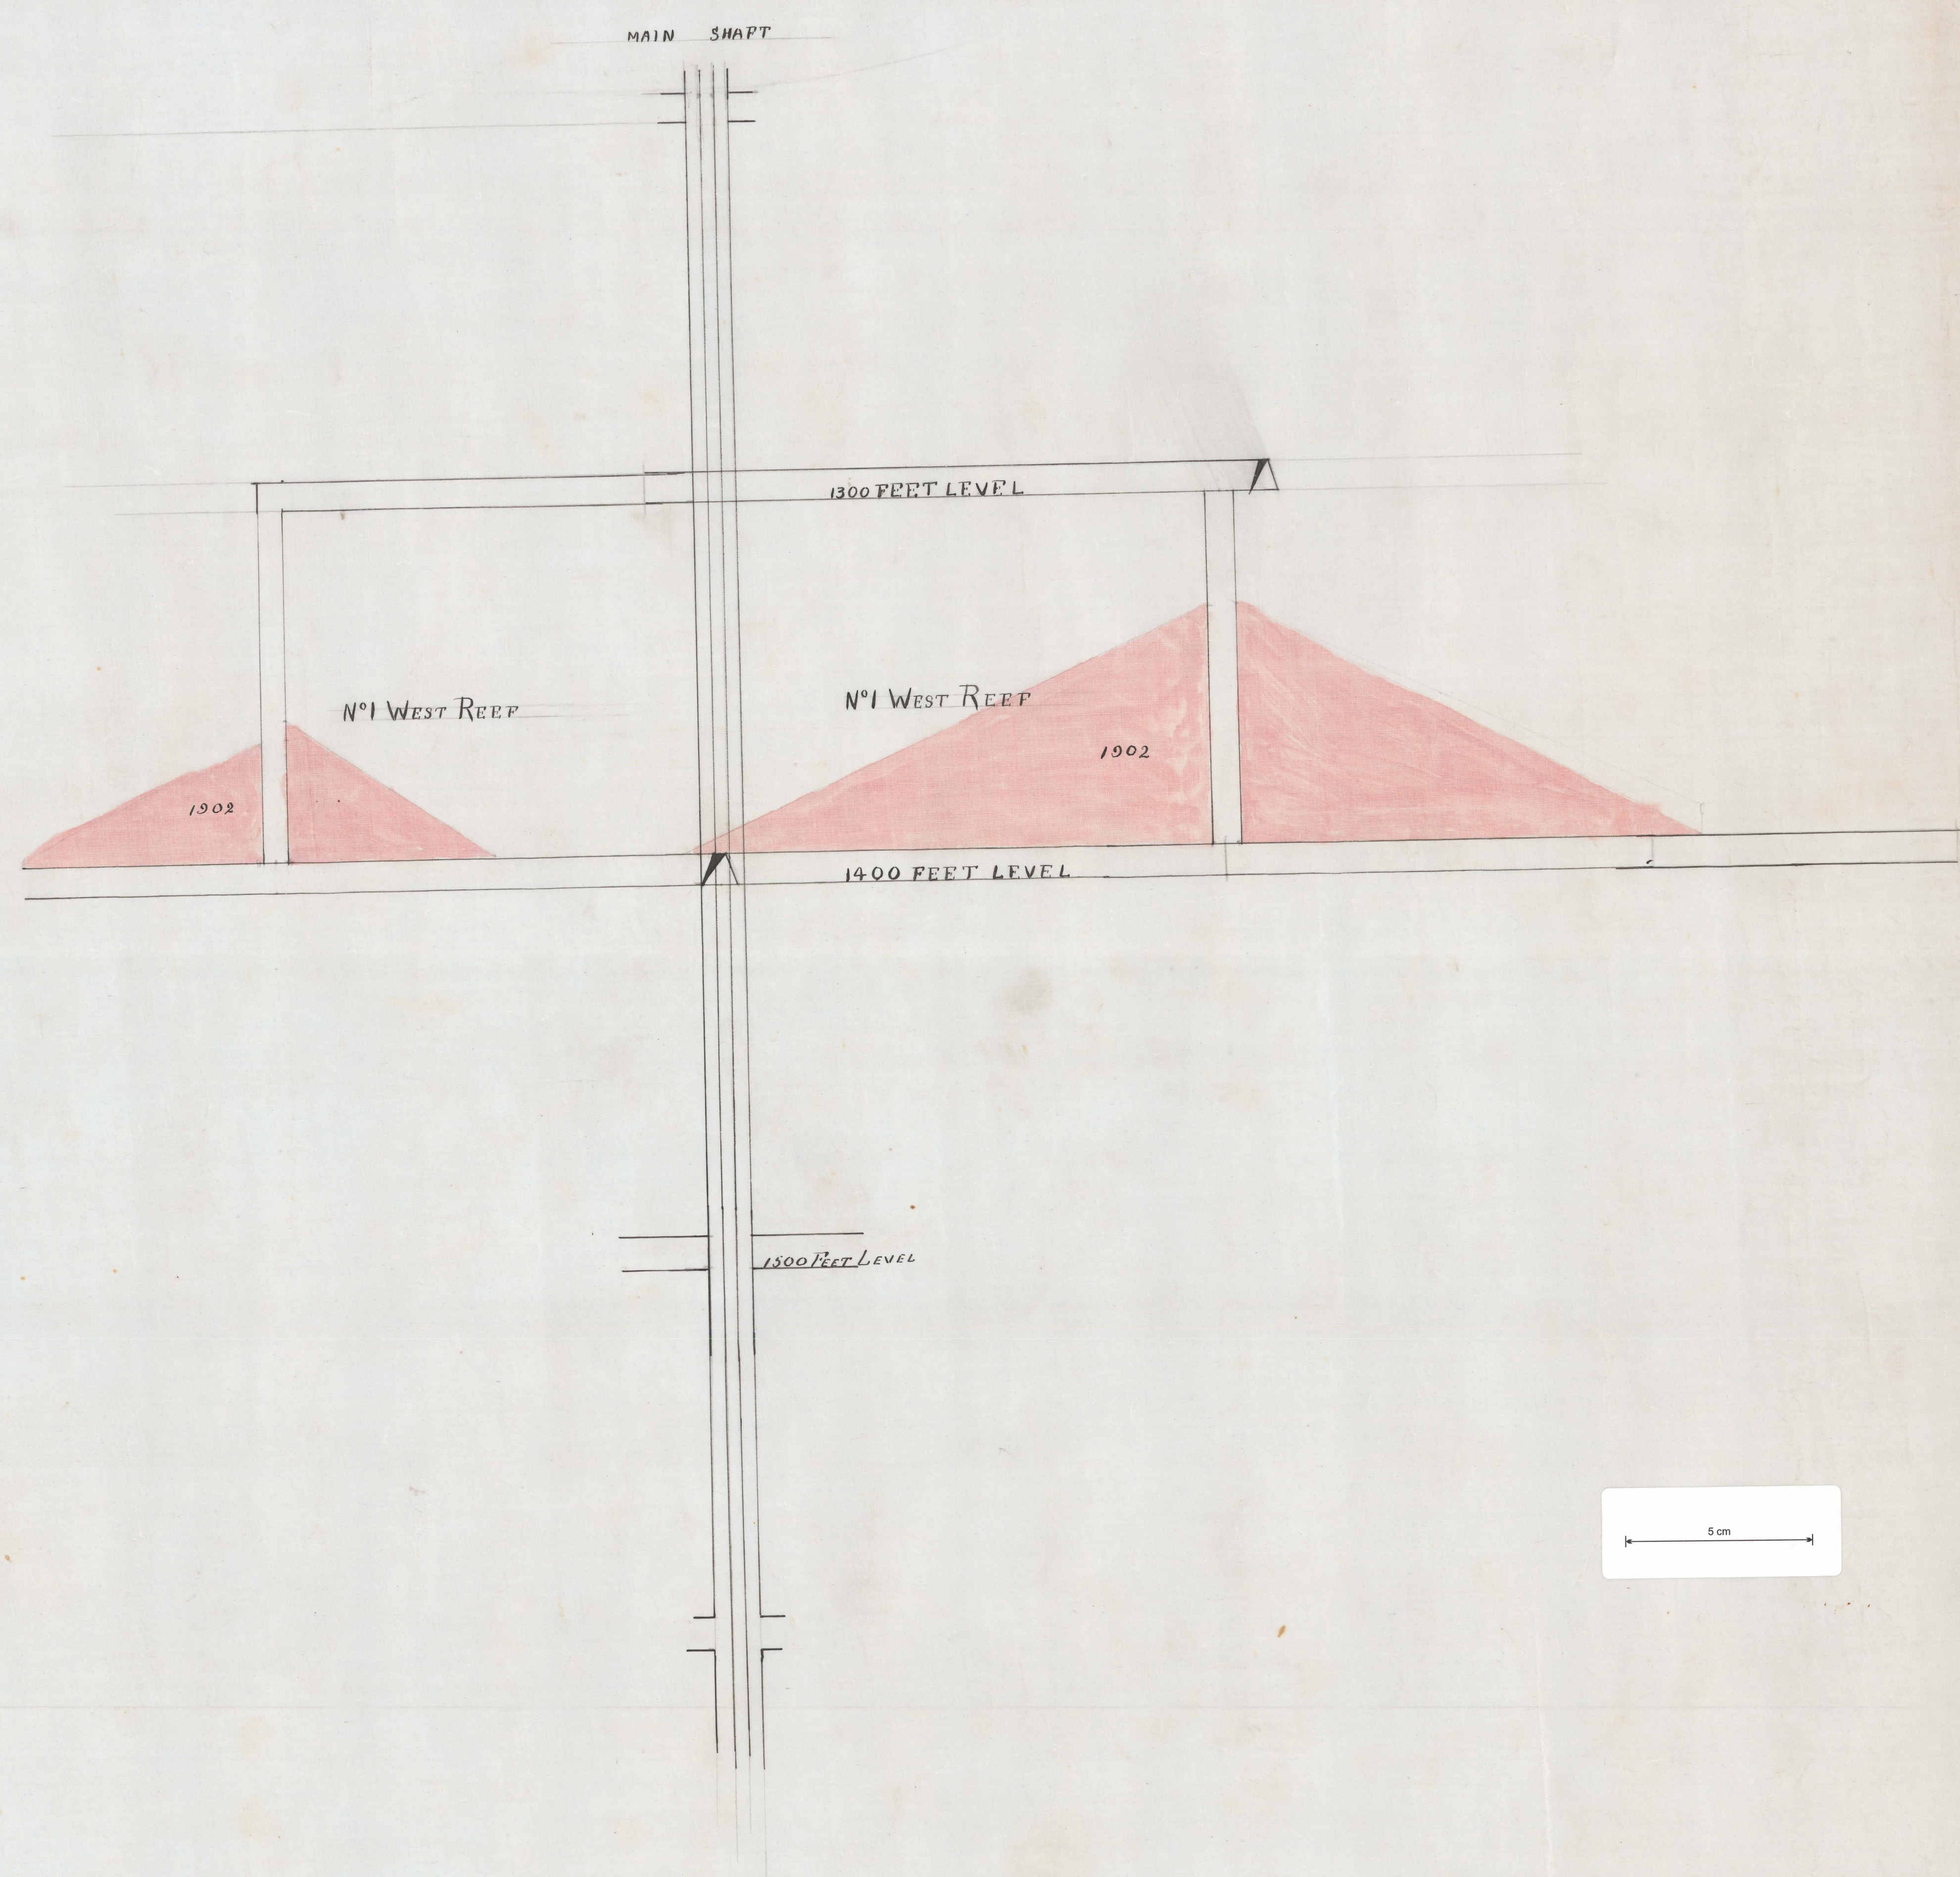

5 cm

1805
3 1/2