
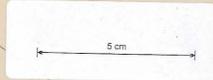


# THE TASMANANIA G.M. AND Q.C. CO. BEACONSFIELD

## TASMANIA

### PLAN OF DRIVES

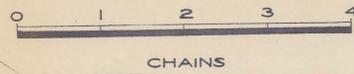

235

288  
41

155  
7 1/2


SHAW ST.

WELD

STREET

239

281

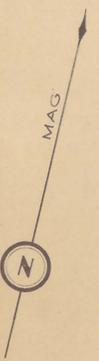

BONANZA GOLD MINING CO. A REEF CUT AT 1056 FT. 14 DWZTZ STONE

0122-015

50' level  
x cut

South  
hole

Difficult  
Grubbe slope

Surface 230 700  
Lower Main Shaft  
to Main Shaft  
New Main Shaft  
11037  
(Harts)

Shaw Shaft  
4000 800

Main Shaft

Florence Shaft

Gate Shaft

Phoenix Shaft

2 Florence

3 Florence

