

127-02

941
87C
10

890
87C
10

814
87C
10

Frederick W. Lams
Authorised Surveyor
31st January 1901

100 feet to 1 inch horizontal
40 feet to 1 inch vertical

Scale
50 feet to 1 inch

Scale, 5 chains to 1 inch

- Index to colours.
- Long tunnel
 - Lower intermediate level
 - Intermediate level
 - Upper intermediate level
 - Rosalind tunnel
 - Premier tunnel
 - Surface traverse lines
 - Underground traverse lines

RINGAROOMA G. M. CO.


LIMITED

RINGAROOMA MINE WORKINGS

COUNTY OF DORSET

PARISH OF ALBERTON

SCALE

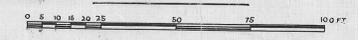

127-02

