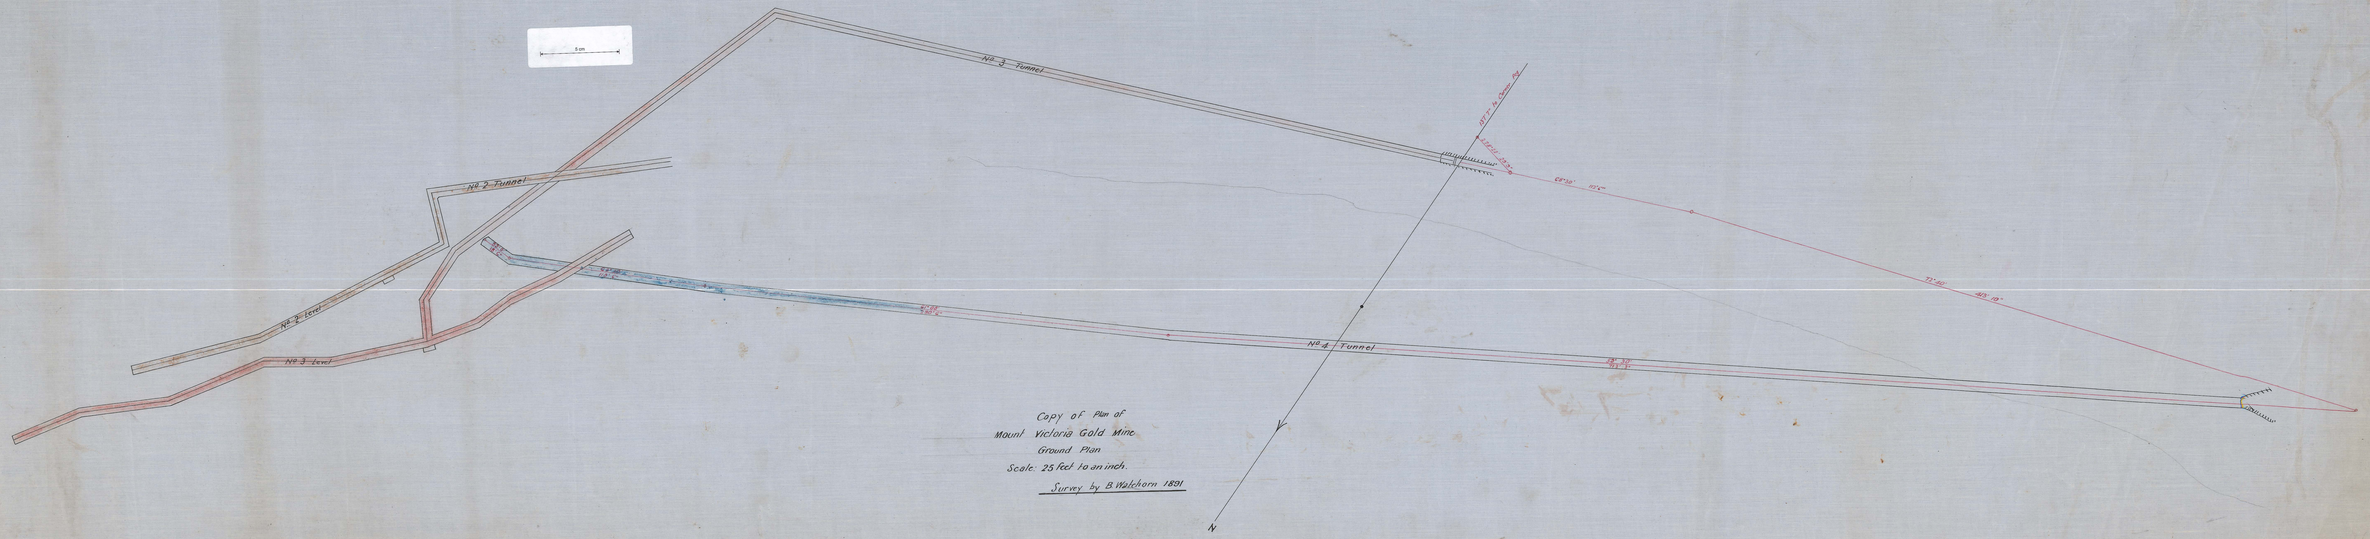

Copy of Plan of
Mount Victoria Gold Mine
Ground Plan
Scale. 25 feet to an inch.
Survey by B. Walchorn 1891

368A/40

43

0128_005