


0135-011

UTAH 139/9

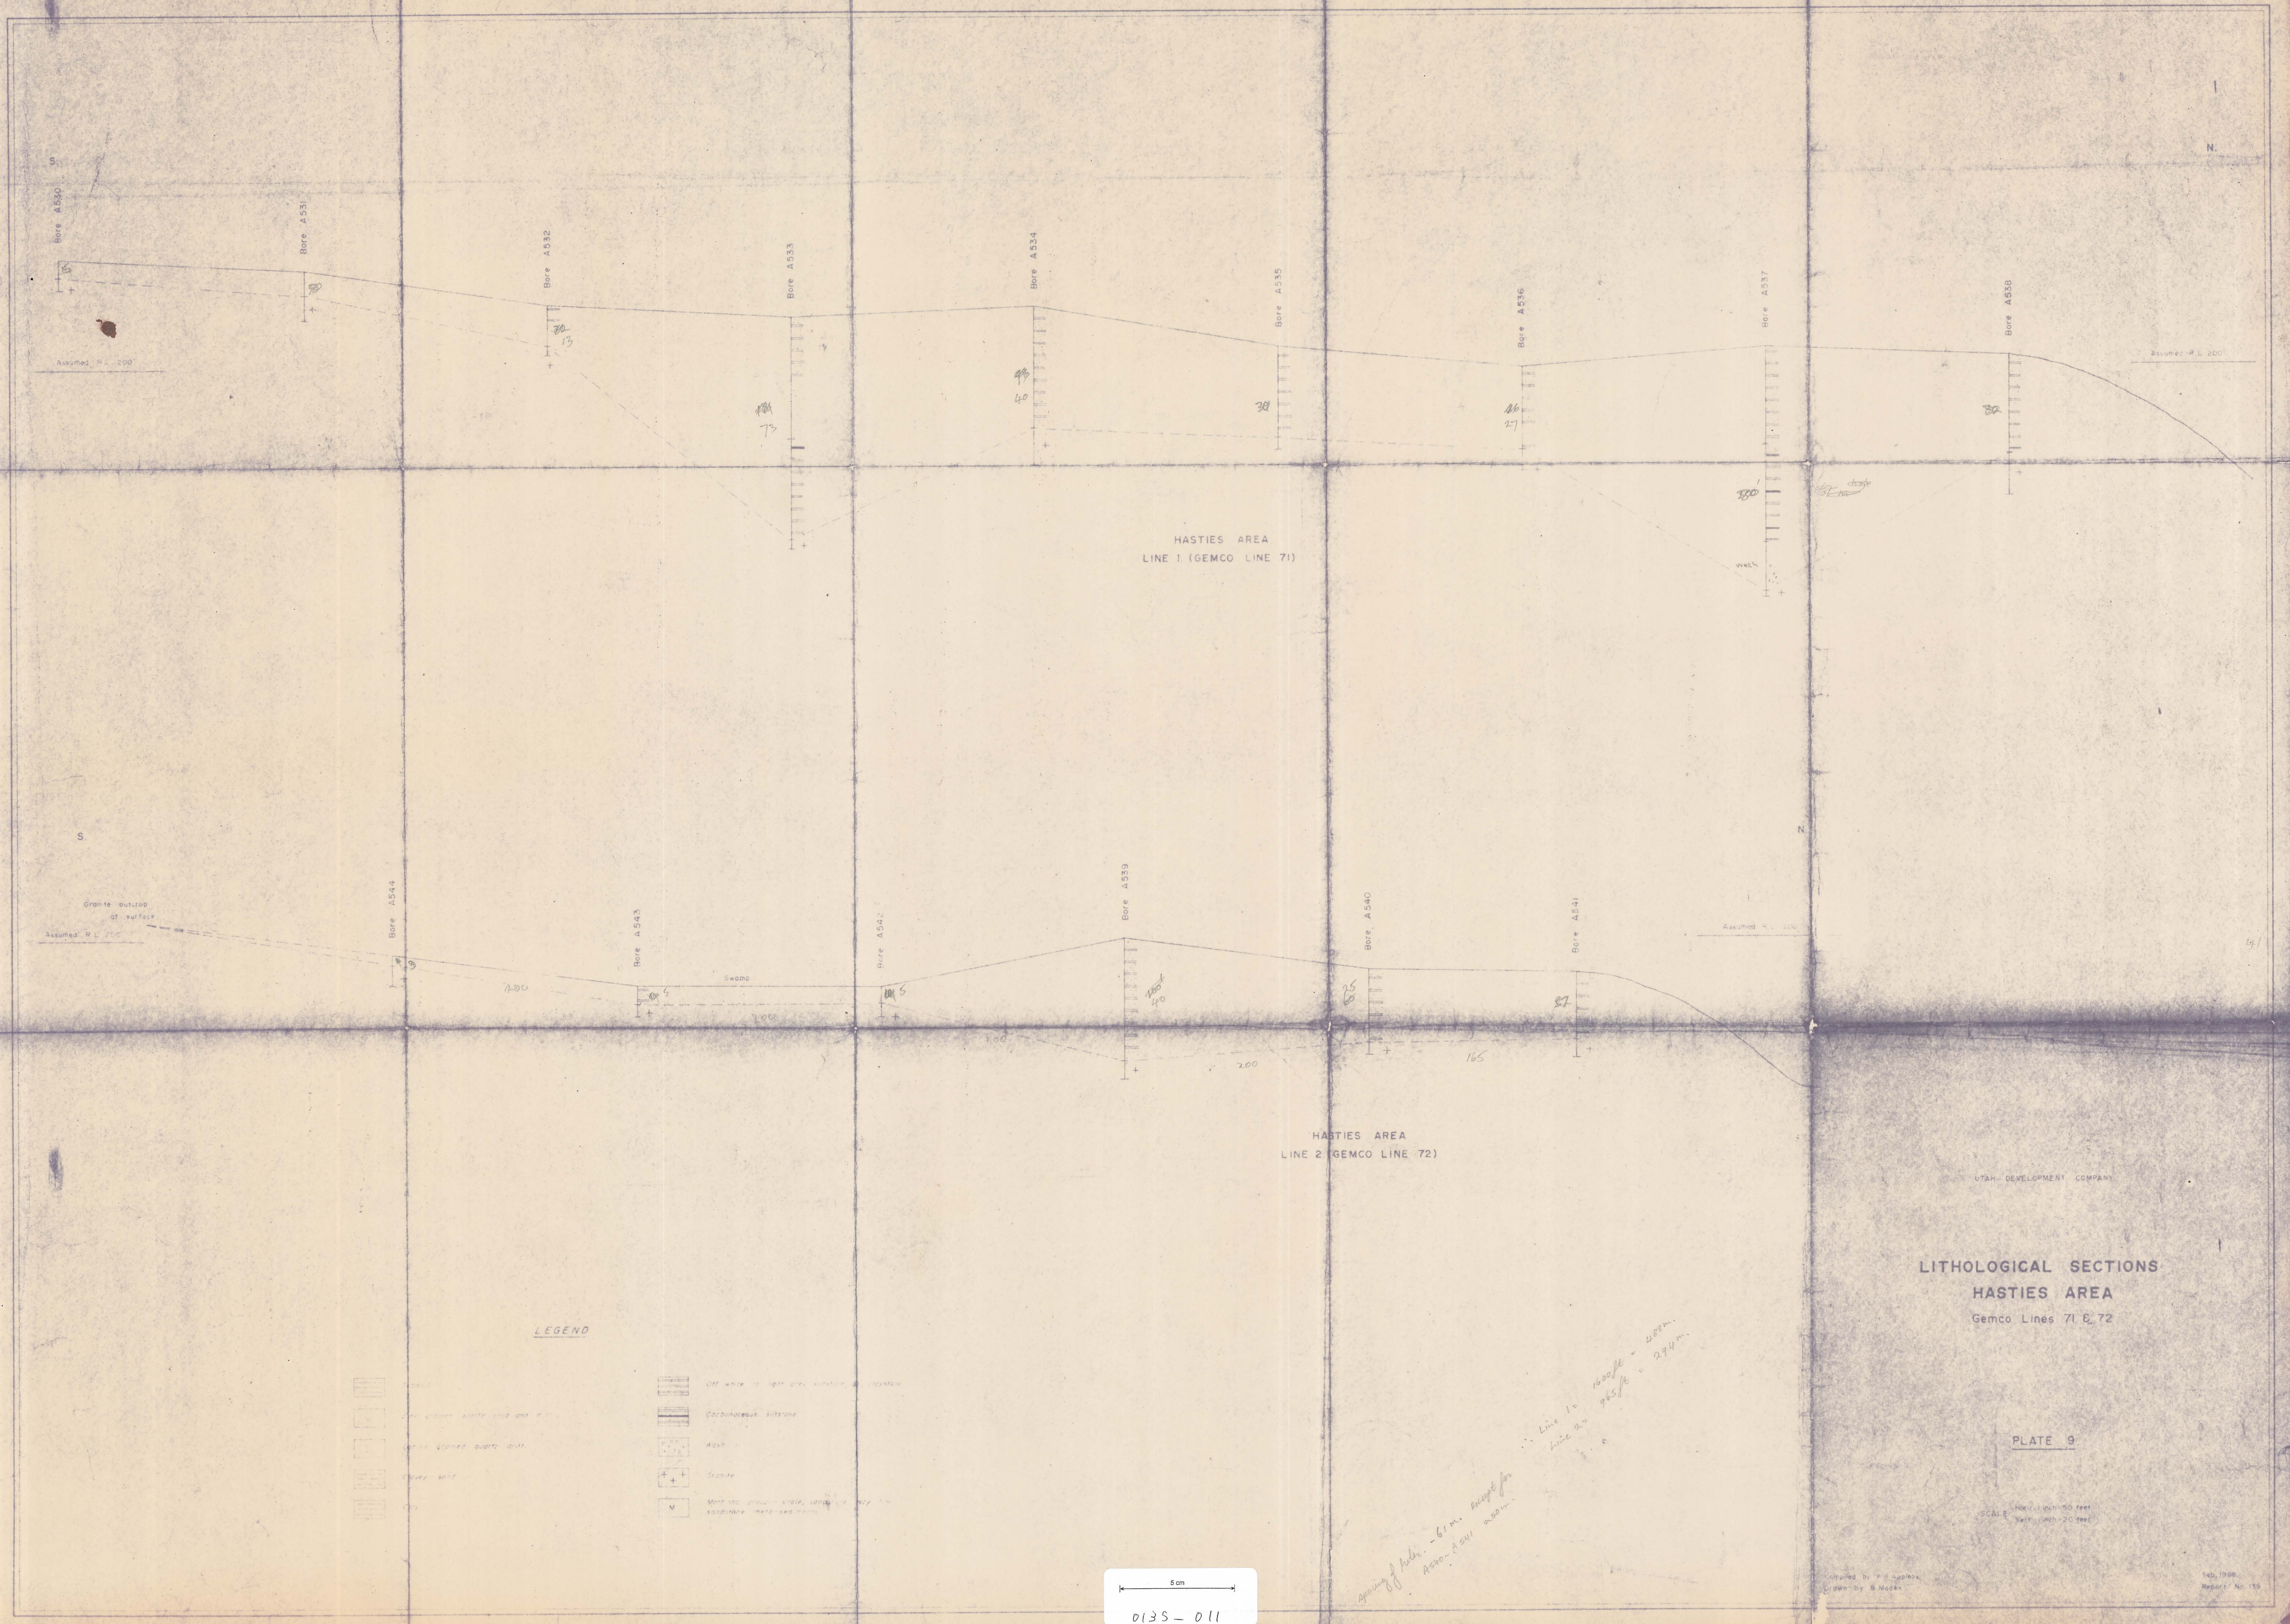

0135-011