


 






THE MOUNT LYELL M. & R. CO. LTD.

MINE DEPARTMENT

COMPOSITE PLAN

LYELL COMSTOCK & TASMAN CROWN MINES.

SCALE - 1 INCH = 30 FEET.
Brought up to 1.9.33

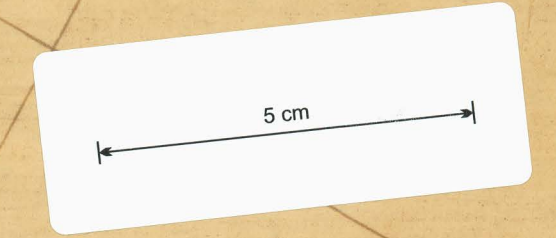

137-01