

137-02

3840  
93 M

2656  
93 M

40

1271  
93 M

4277  
93 M

73  
Mount Lyell Tasman Comstock Mine

4739  
93 M

Consolidated Lease N<sup>o</sup> 5218  
93m

4738  
93 M

201 feet  
No 2 Tunnel 10° S. of W.

120 feet  
No 1 Tunnel 4° W. of N

2135  
93 M

483  
93 M


# Plan of Workings on Leases of TASMAN COMSTOCK C<sup>o</sup>

Scale 1 inch = 2 1/2 chains

Mount Lyell Tasman Comstock Mine

Mount Lyell May 5<sup>th</sup> 1902

D. H. Finlay  
Mine Manager.

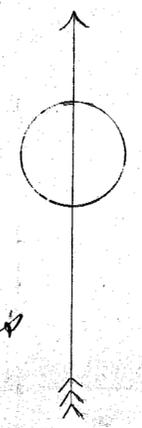

1902  
Mount Lyell Tasman Comstock Mine

100