


13703

13703

5m

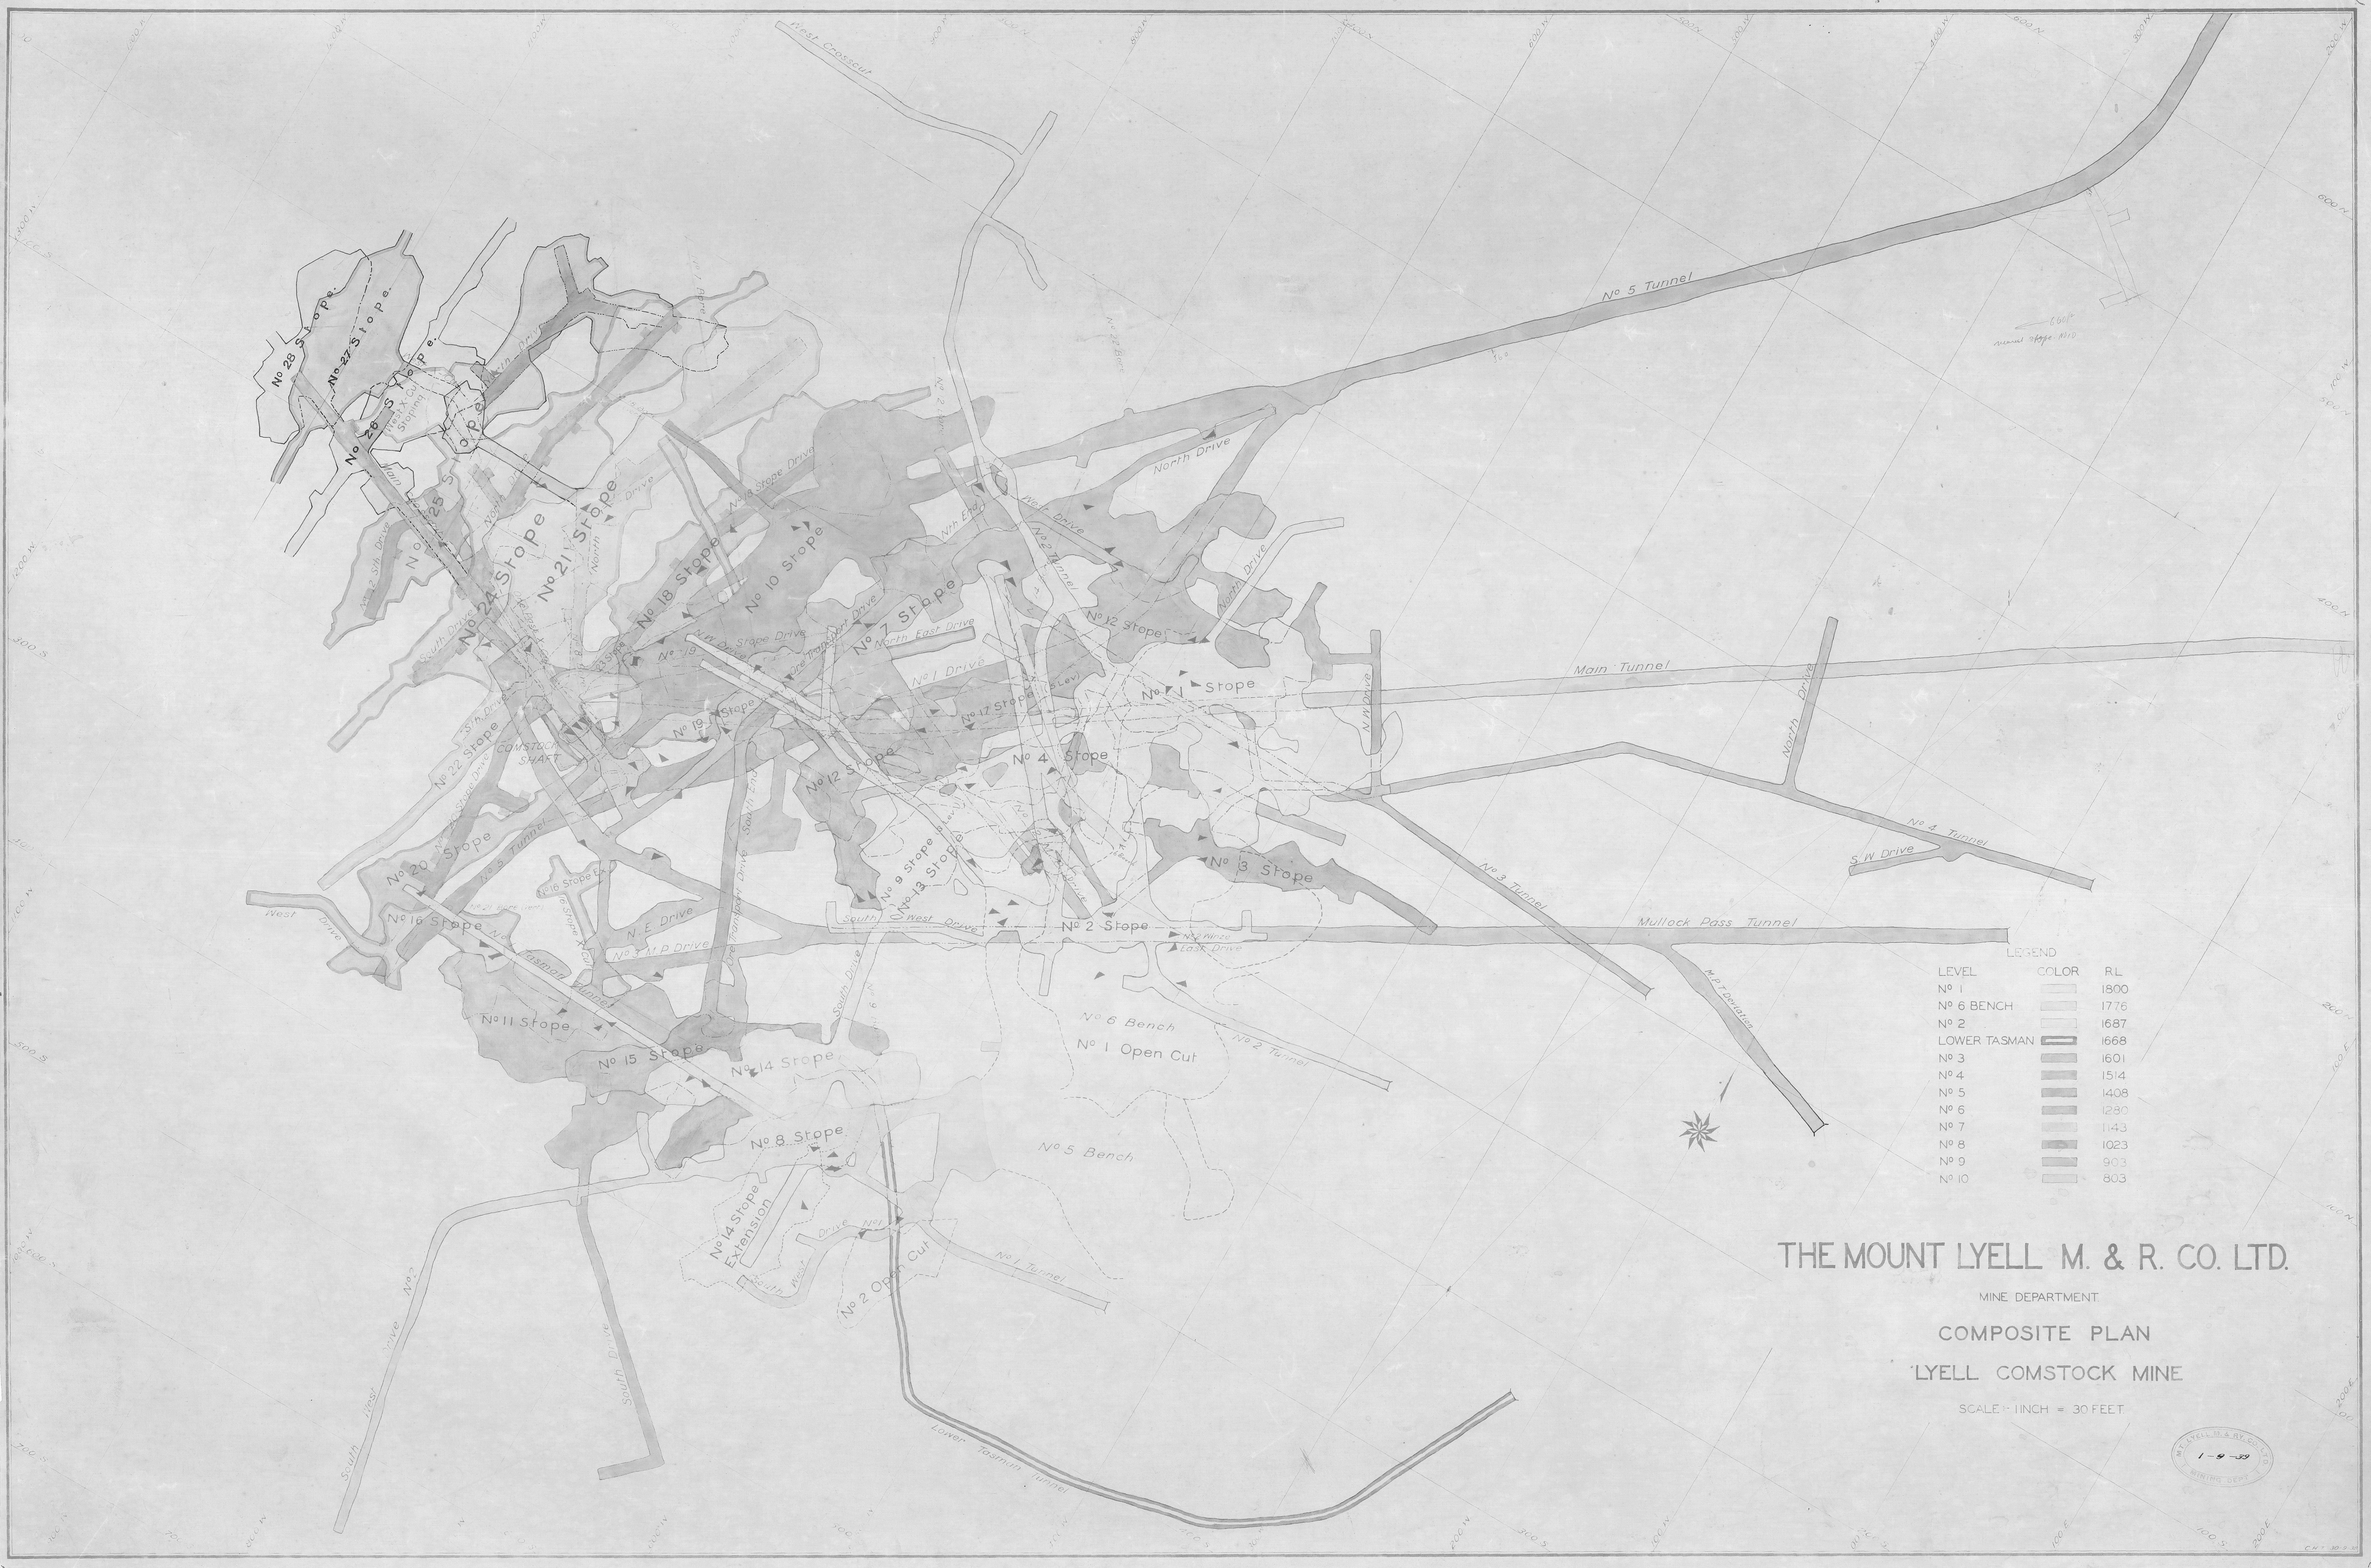

LEGEND

LEVEL	COLOR	RL
No 1		1800
No 6 BENCH		1776
No 2		1687
LOWER TASMAN		1668
No 3		1601
No 4		1514
No 5		1408
No 6		1280
No 7		1143
No 8		1023
No 9		903
No 10		803

THE MOUNT LYELL M. & R. CO. LTD.

MINE DEPARTMENT

COMPOSITE PLAN

LYELL COMSTOCK MINE

SCALE: 1 INCH = 30 FEET

