Underground Workings

February 24 1901

Western Tharsis M.Co N.L.

Scale 30 Feet to 1 Inch.

Survey made with theodolite & steel band chain

John Bower
Auth. Surveyor

CHIEF INSPECTOR OF MINES
11 MAR 1901
LAUNCESTON

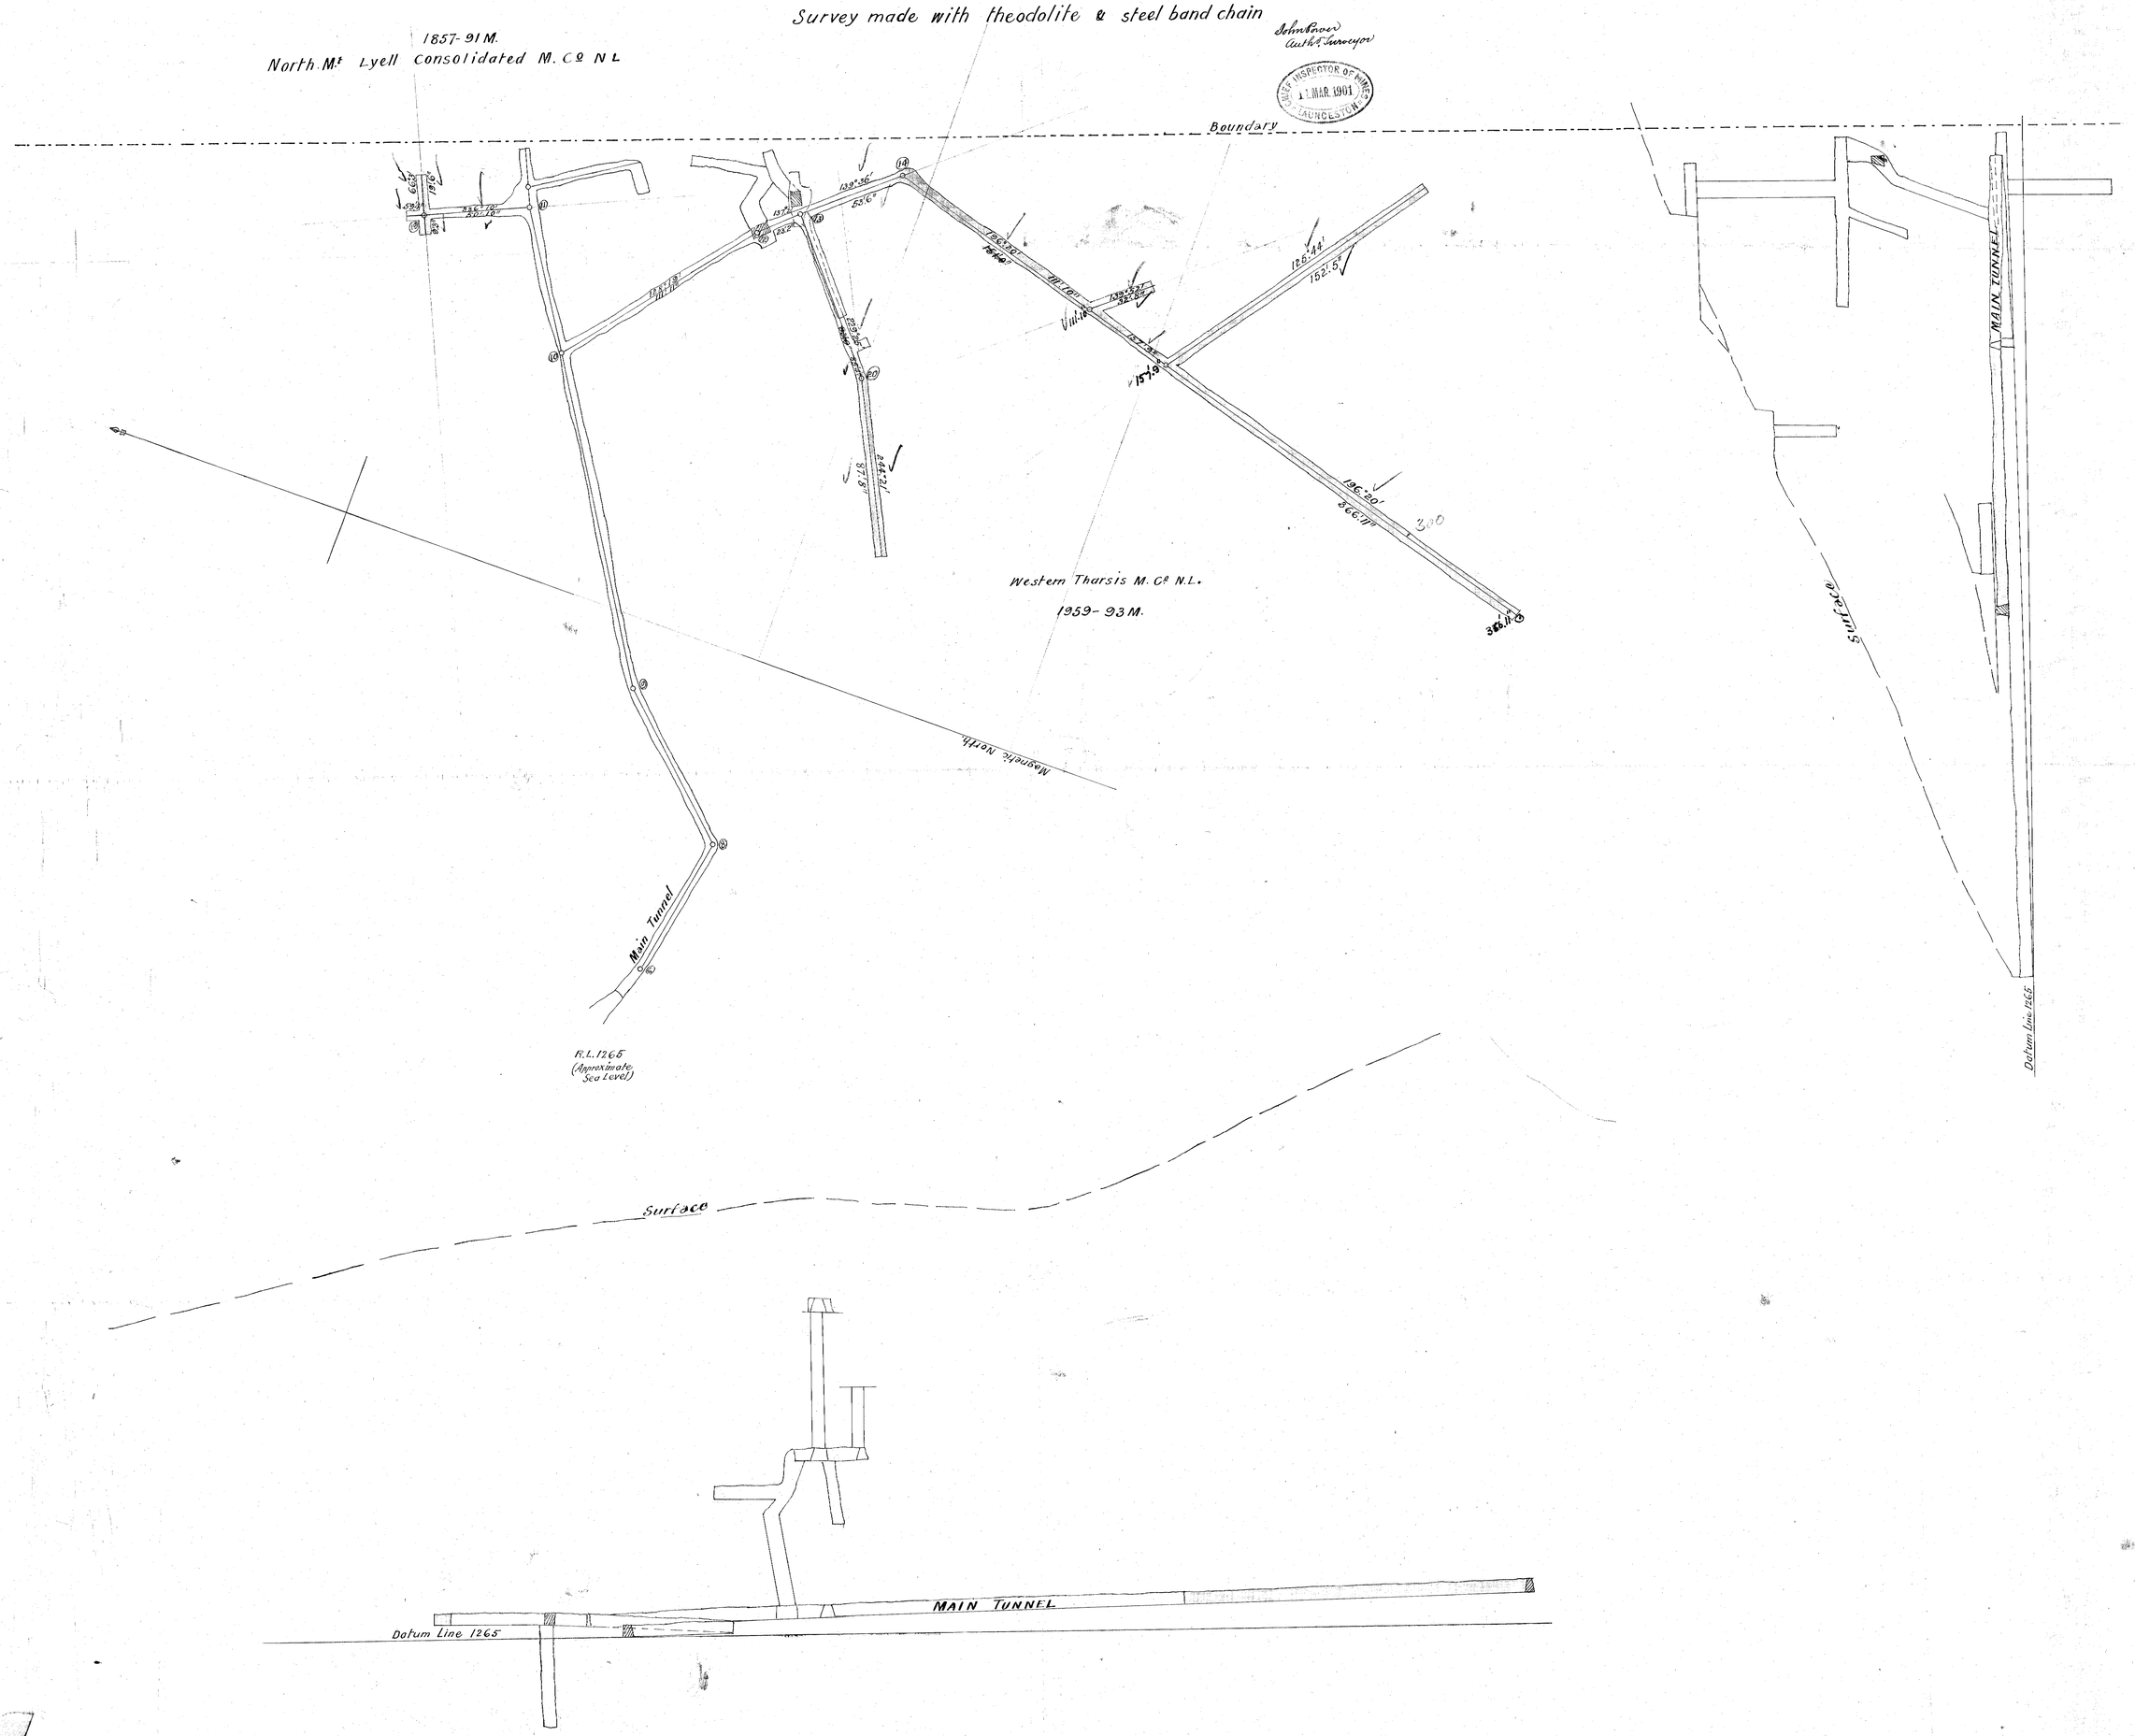

138-01