139-05

—PLAN—

—Sth Mt LYELL UNDERGROUND—

WORKINGS to 5th June 1903

—Scale – 20 Ft = 1 inch—

John Lowes
Authd Surveyor
June 5th 1903
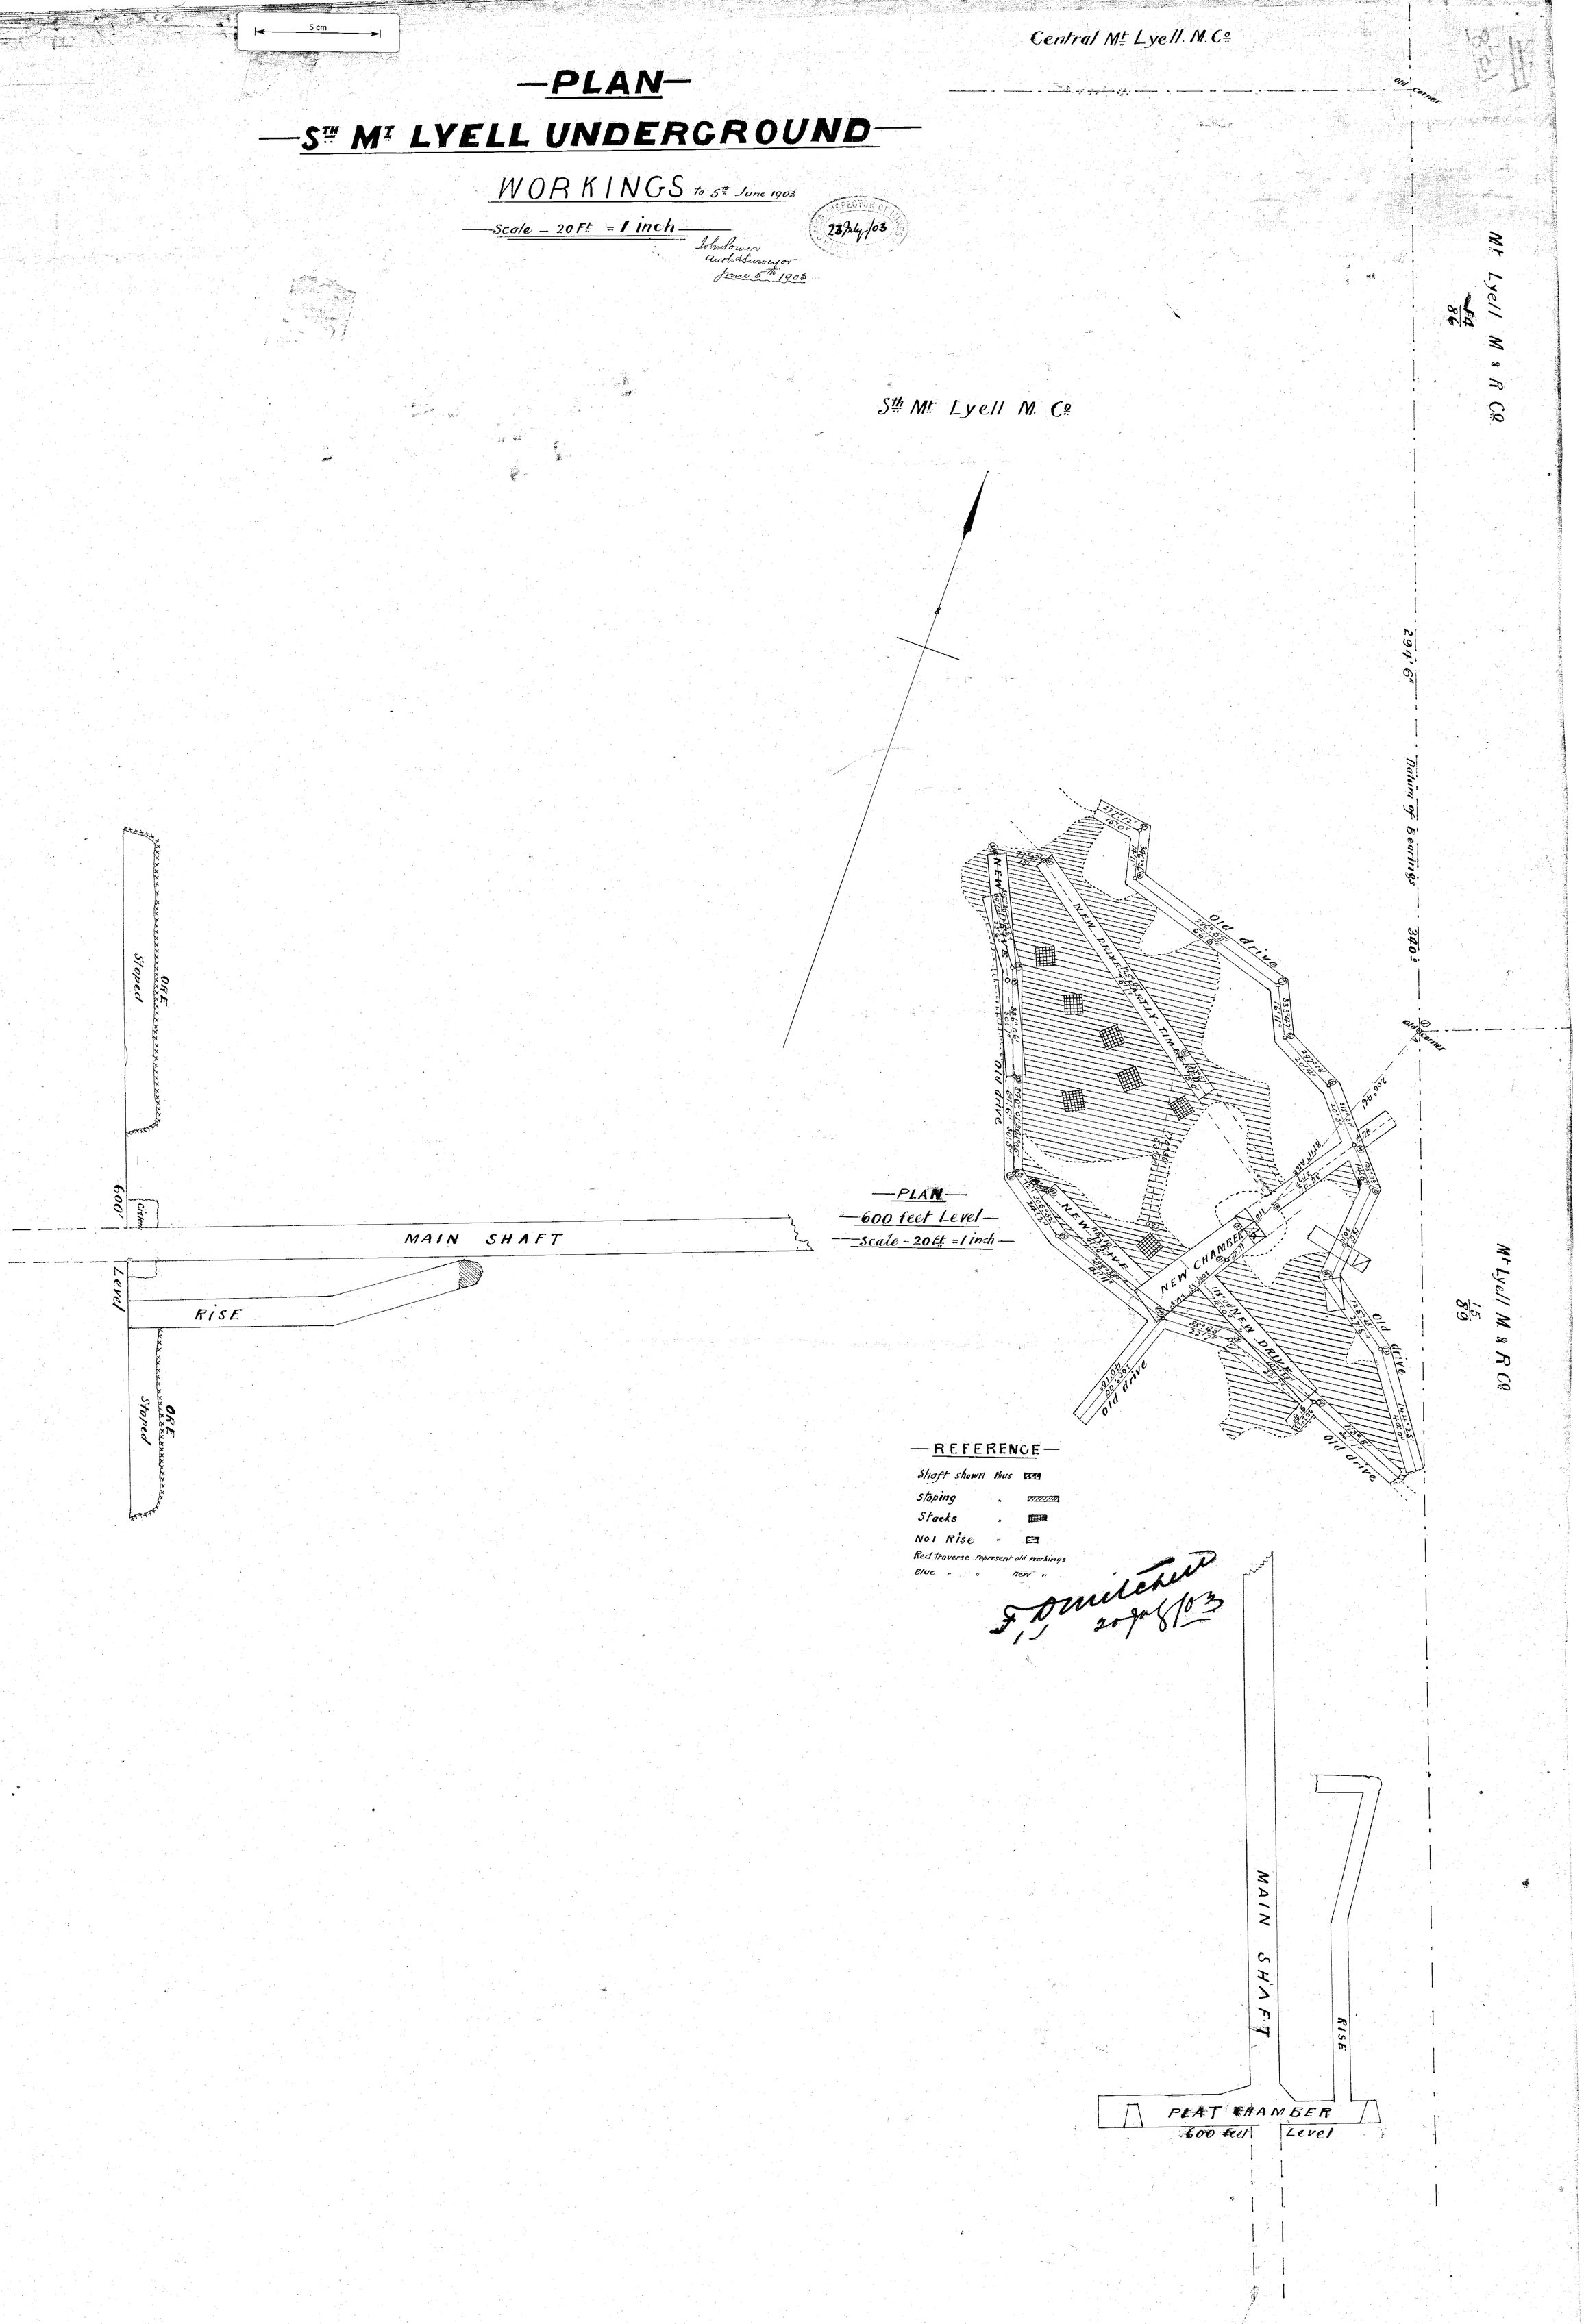
INSPECTOR OF MINES
23 July 1903