140-12

140-12

5 cm

N

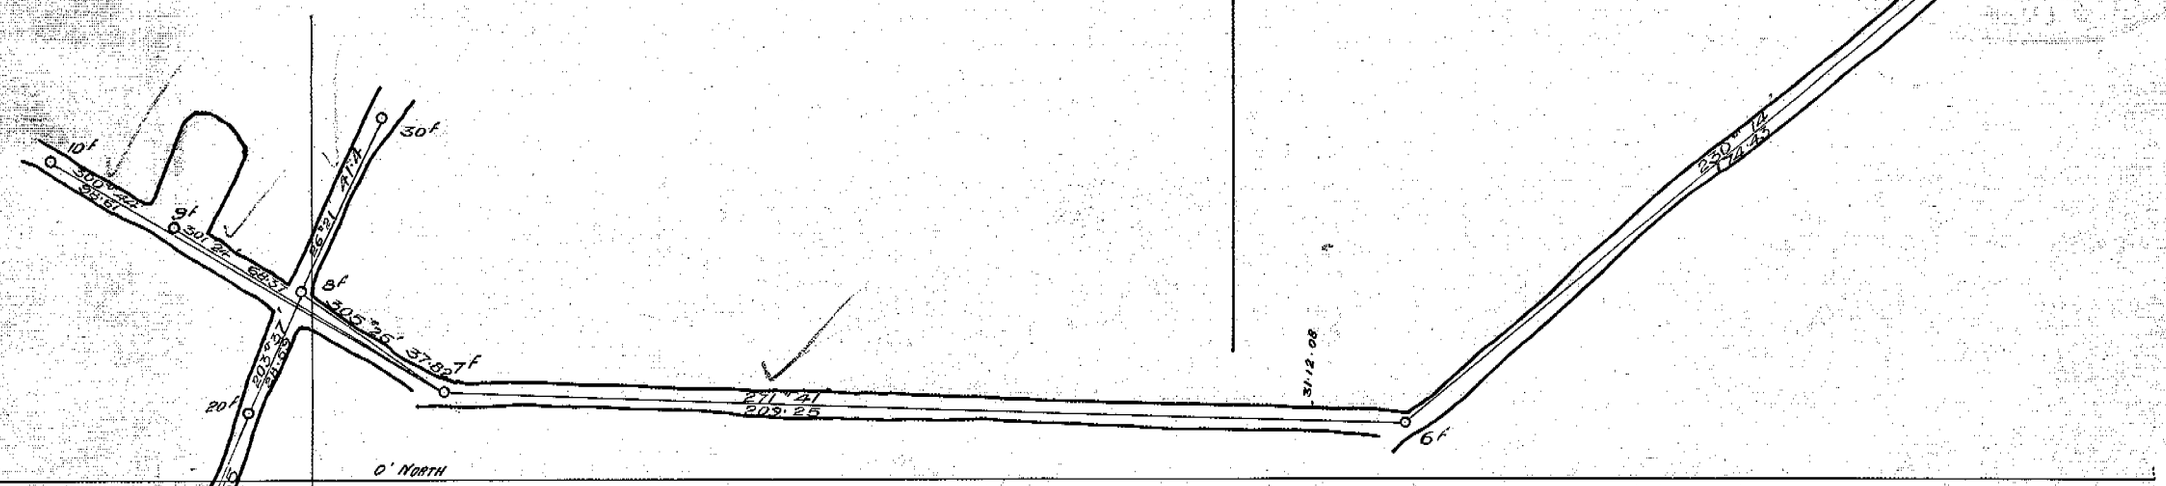

Mount Lyell Comstock

Copper Company Ltd.

UNDERGROUND PLAN

FOR YEAR ENDING DEC. 31ST 1909

SCALE 1" = 40'

2135
91 M

Charles Cook
9.2.10

NORTH WEST GEOLOGIST
FEB 14 1910
LAUNCESTON