


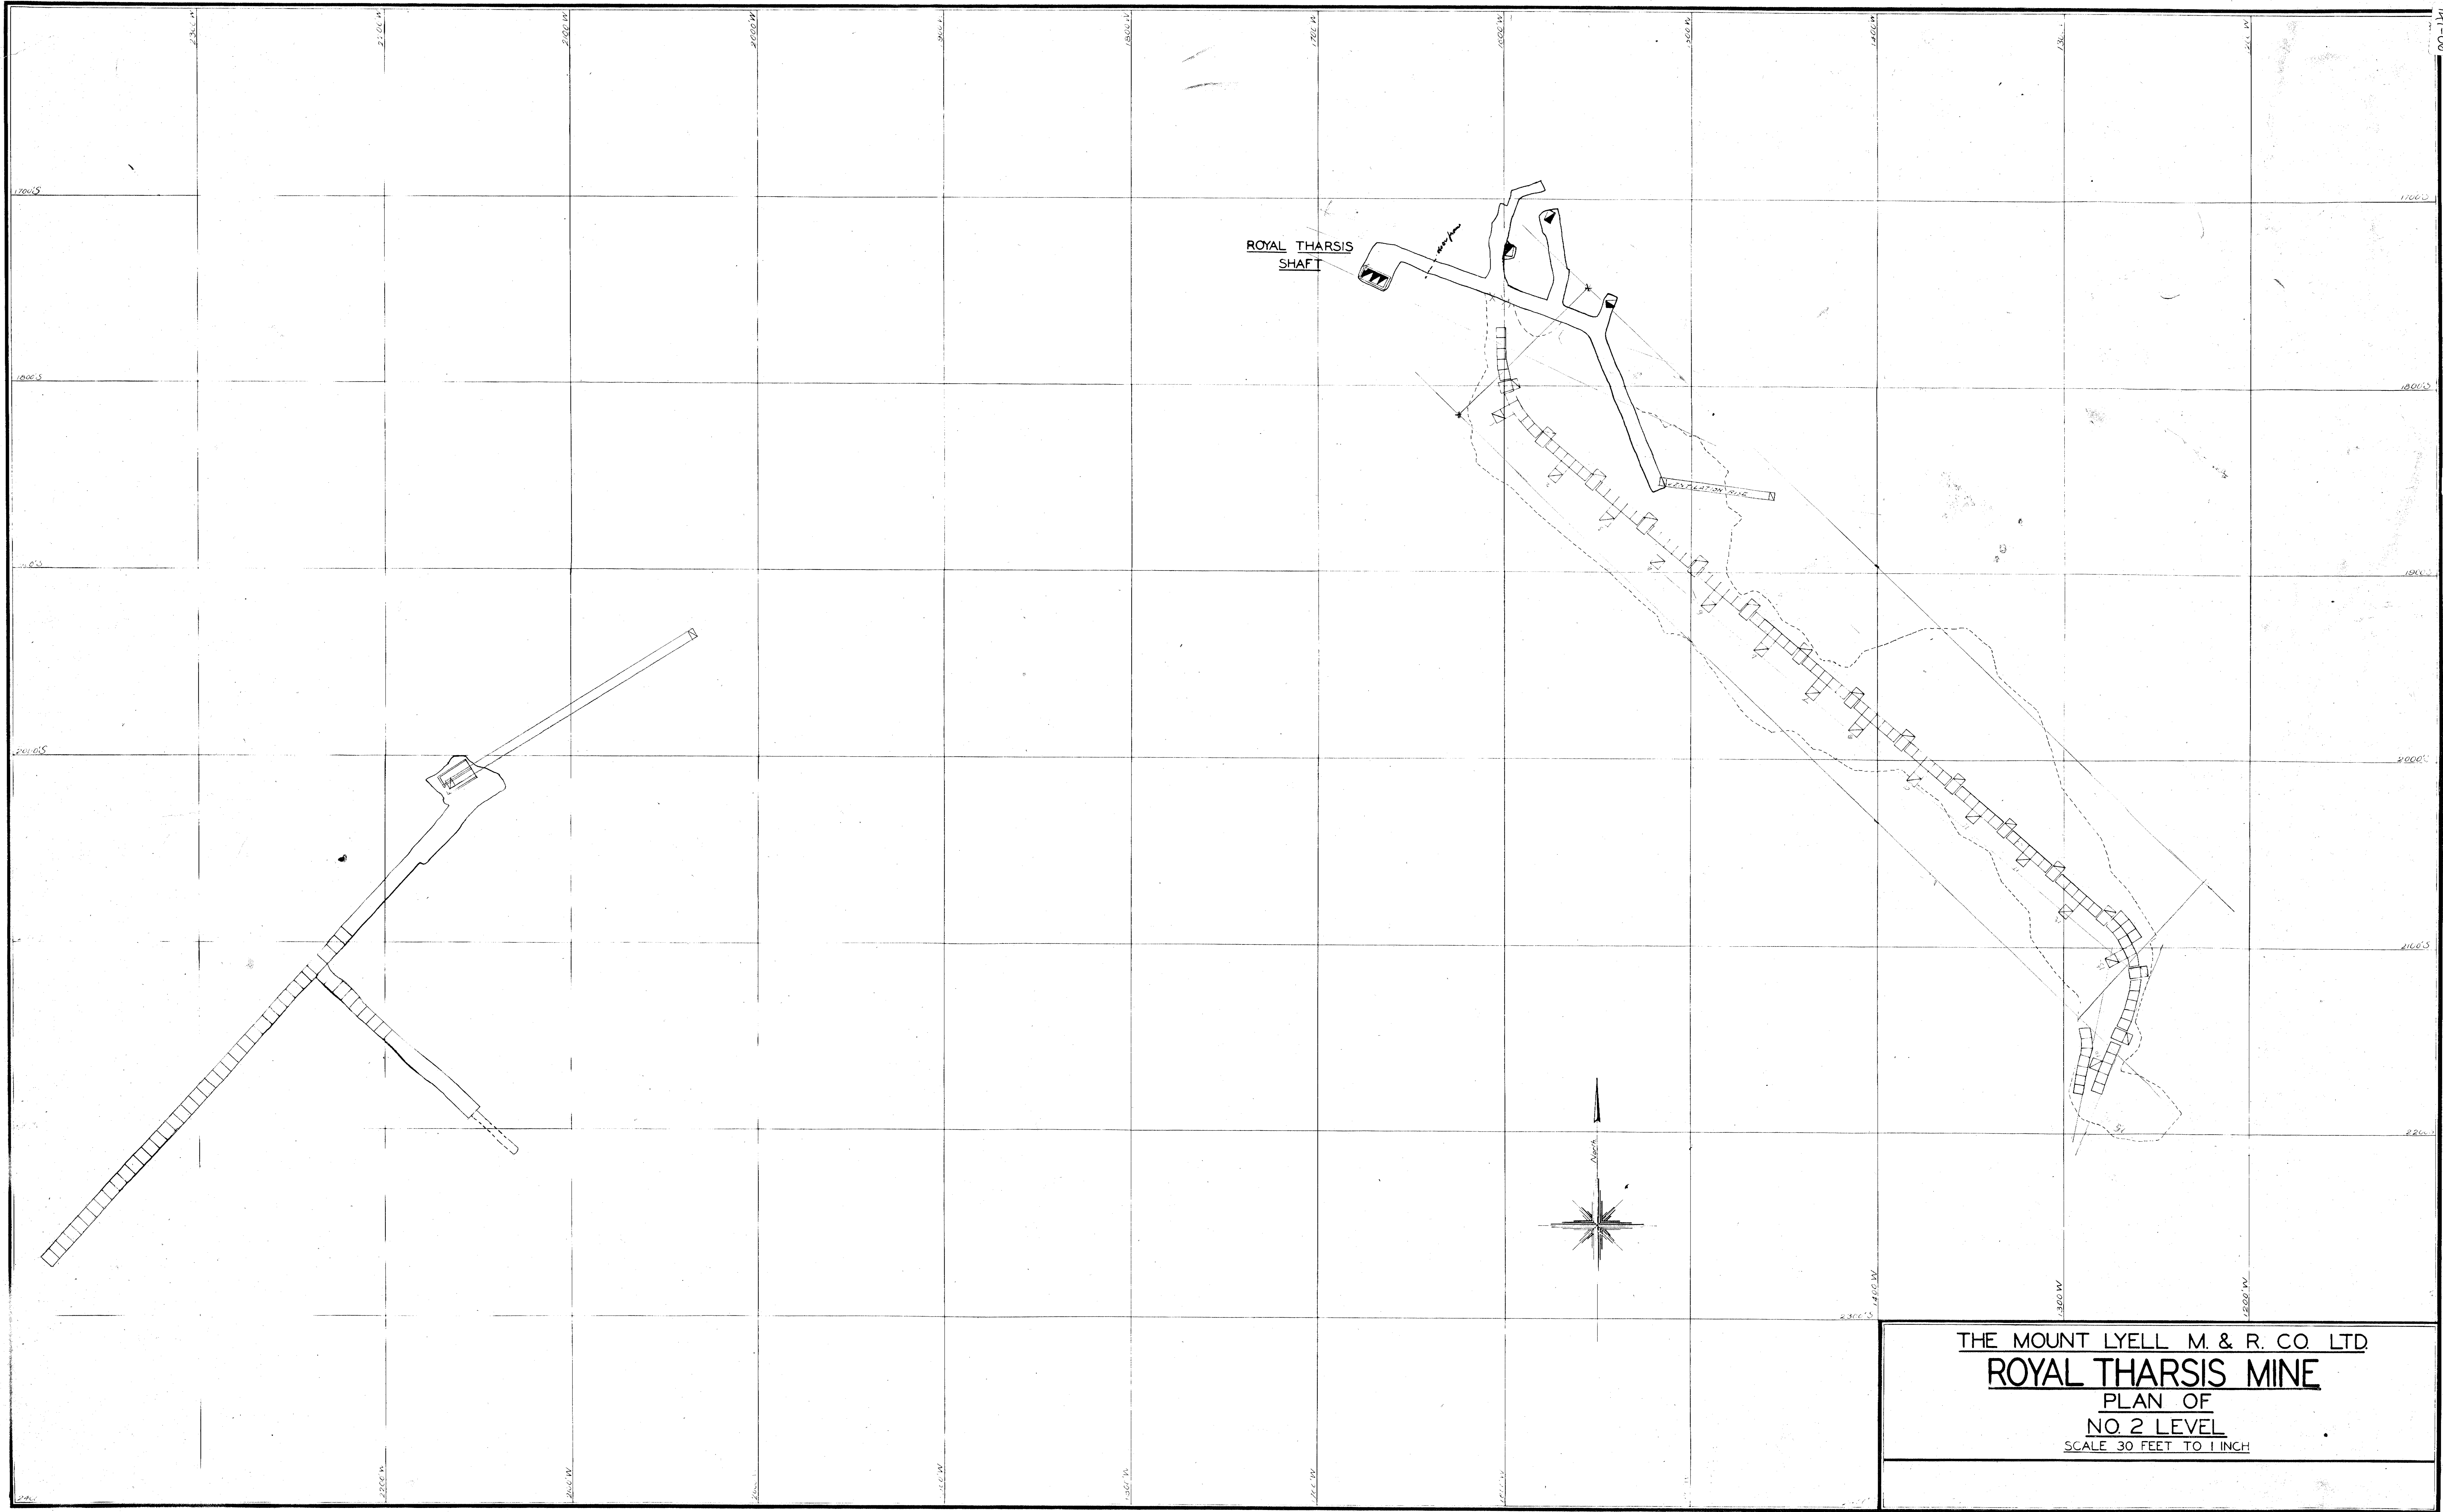

THE MOUNT LYELL M. & R. CO. LTD
ROYAL THARSIS MINE
PLAN OF
NO. 2 LEVEL
SCALE 30 FEET TO 1 INCH