143-02

THE TASMAN LYELL COPPER Co. LTD.

Underground Survey for 1901

Scale-25 feet=1 inch

Survey made with 5" inch Theodolite & steel band chain
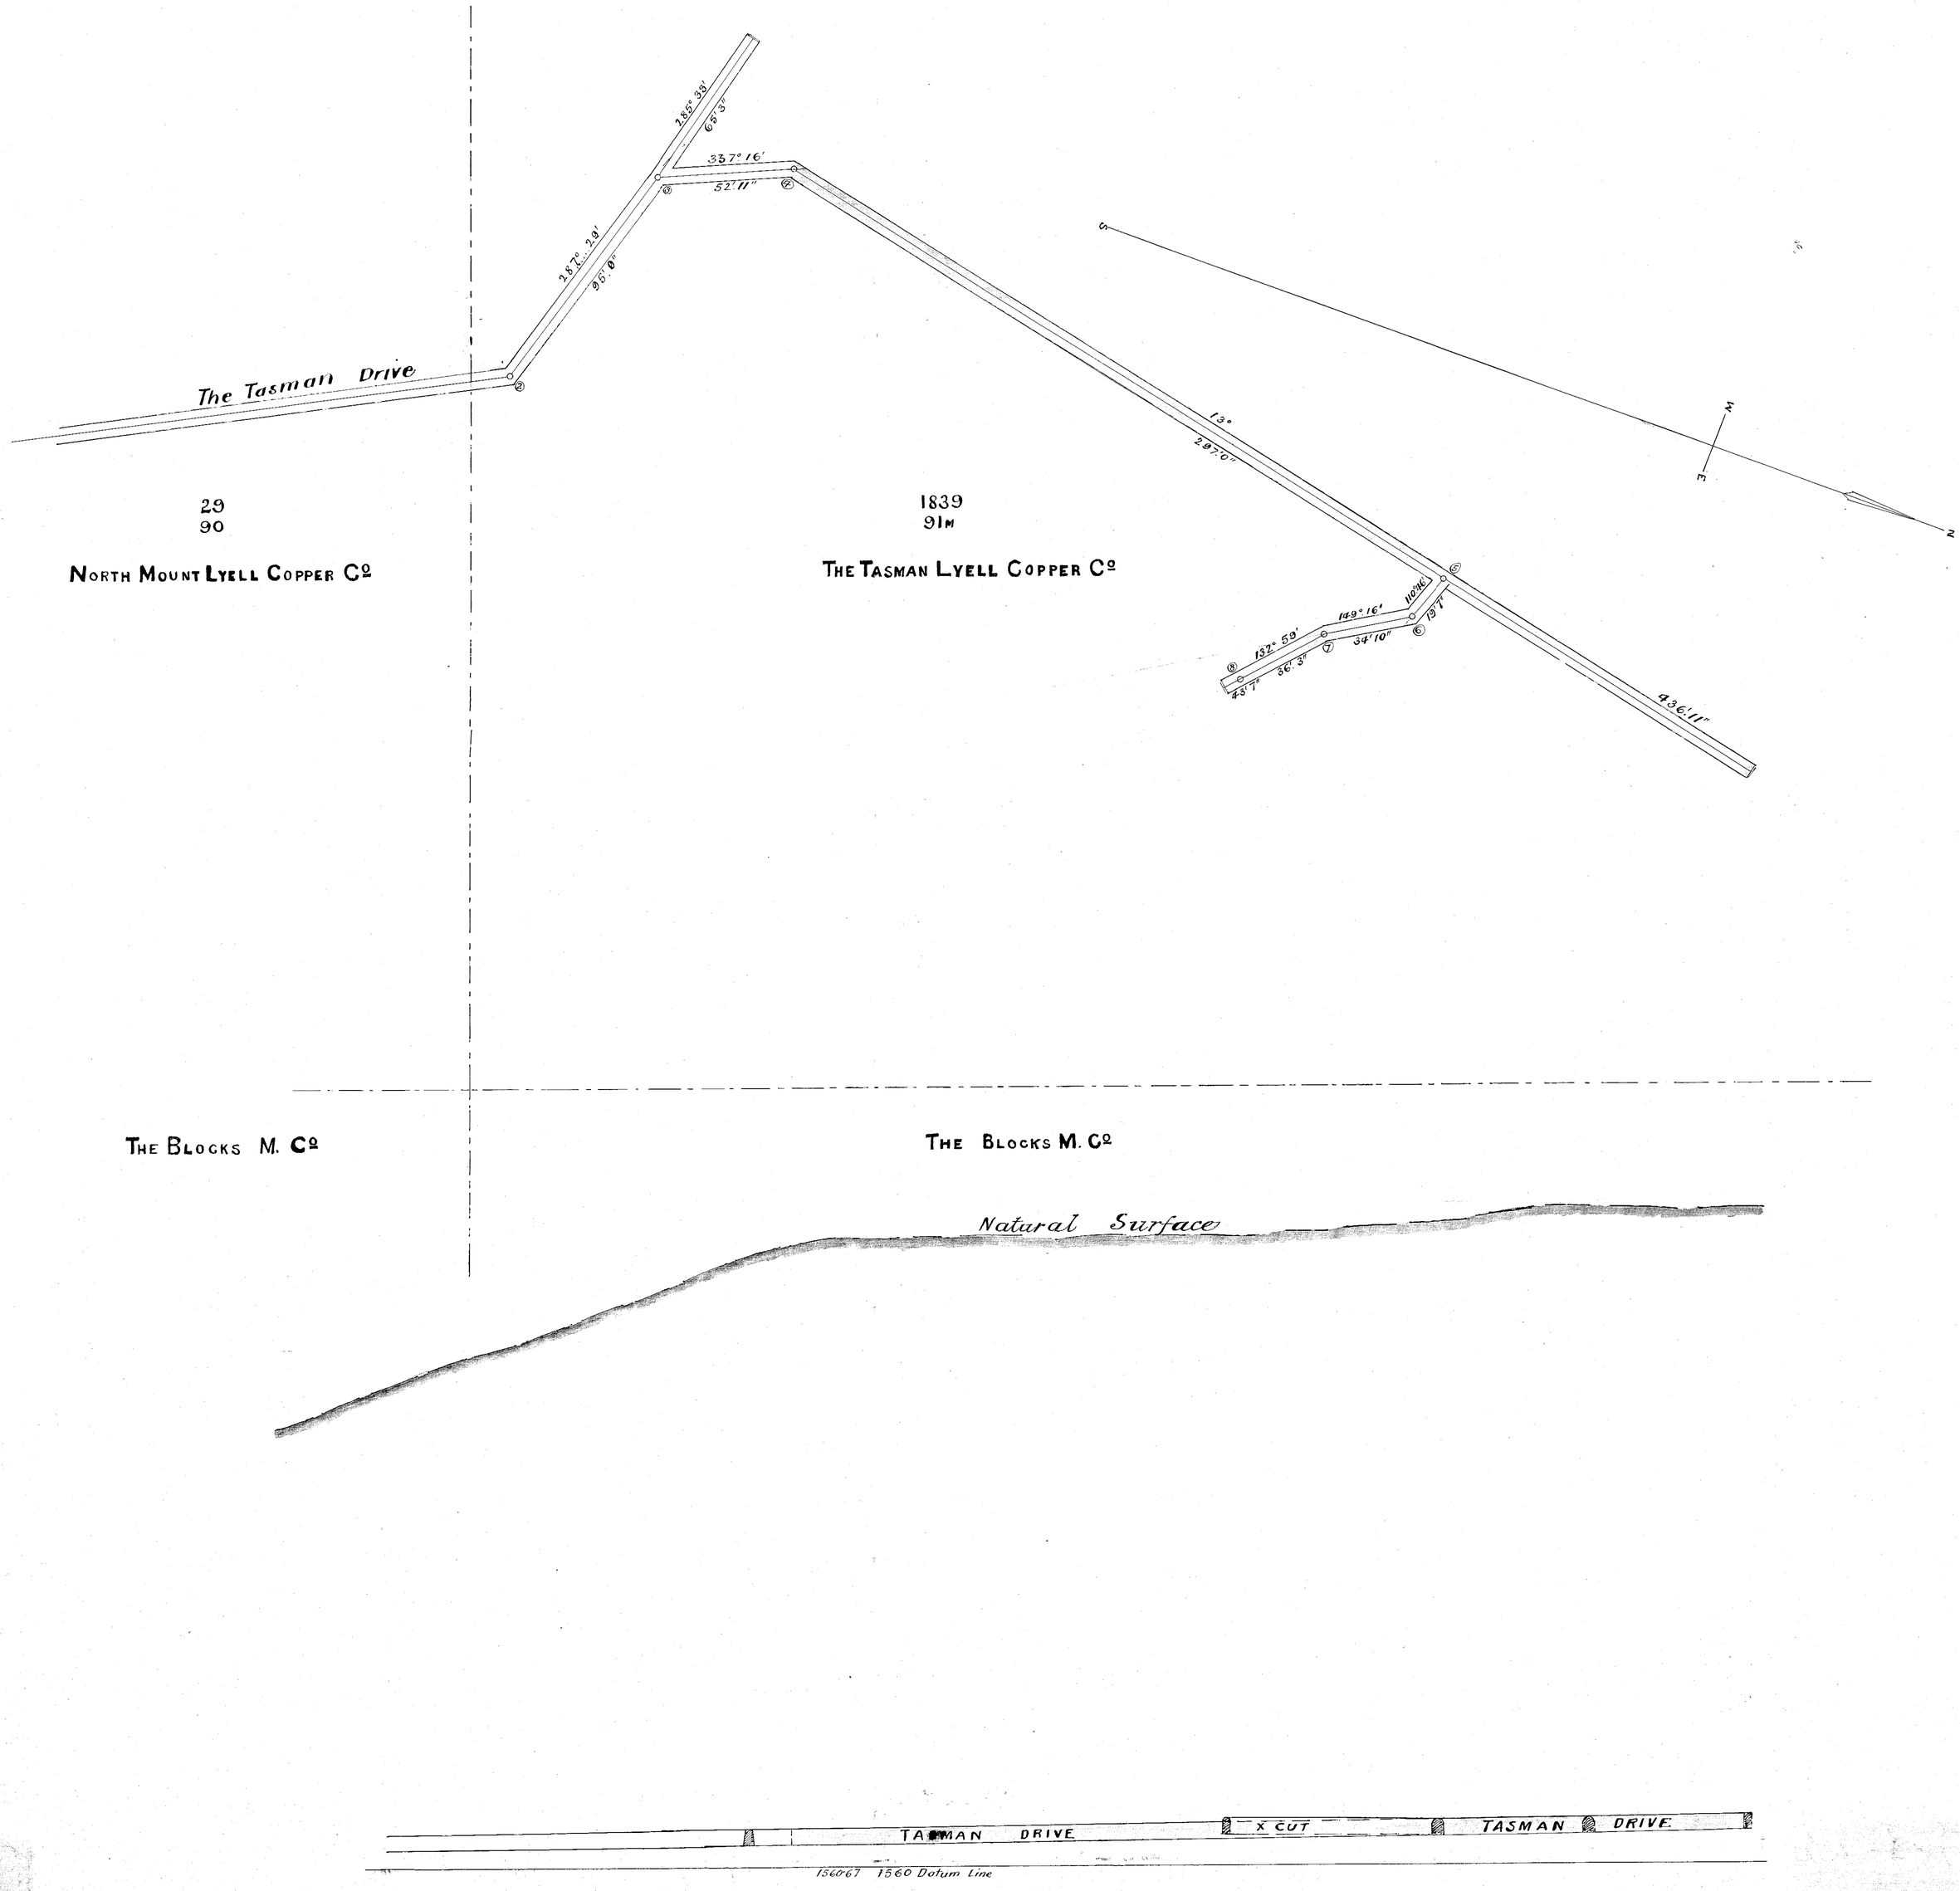
John Power
Author Surveyor
March 1902