145-04

5 cm

145-04

TASMAN & CROWN LYELL EXTENDED

Scale 4 chains to 1 Inch.

Workings as at 31 Decr 1900.

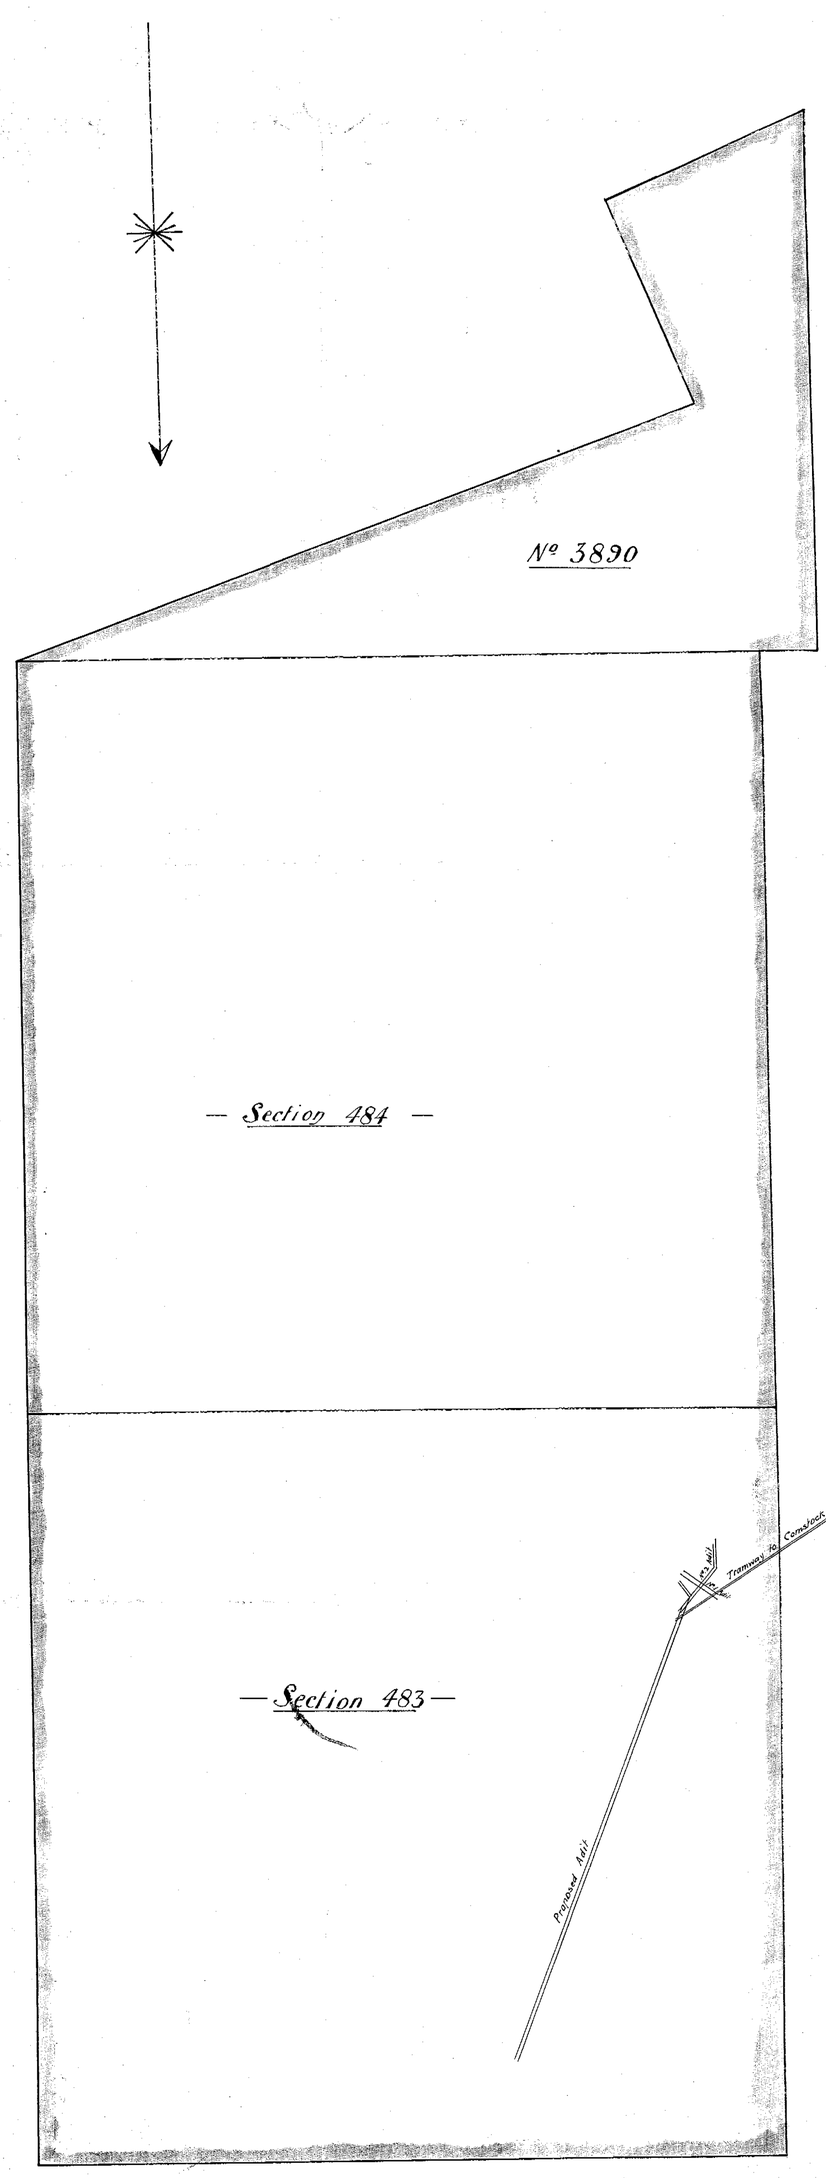

Section Nº 1 Adit

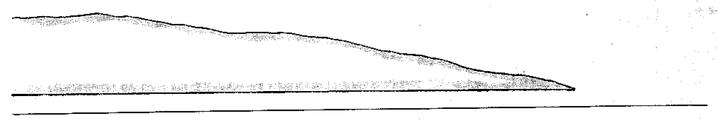

Scale 30 ft to 1 Inch

Section Nº 2 Adit

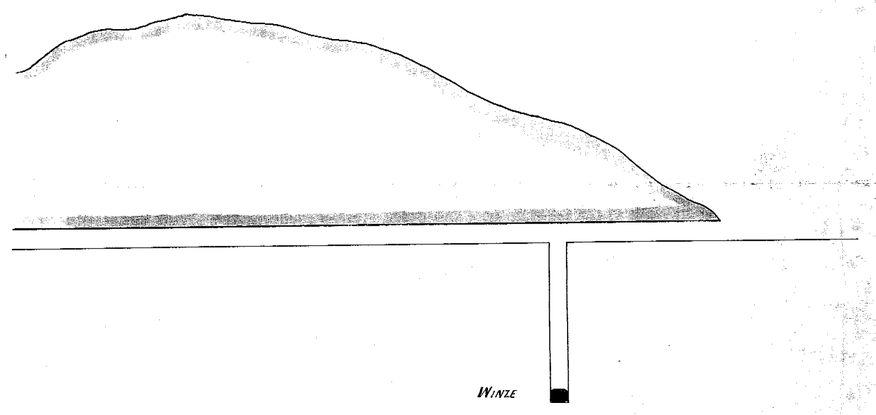

PLAN OF UNDERGROUND WORKINGS

Scale 30 ft to 1 Inch.

Nº 1 ADIT

Nº 2 ADIT

DRIVE 43' LEVEL

E Holeham
Mine Manager

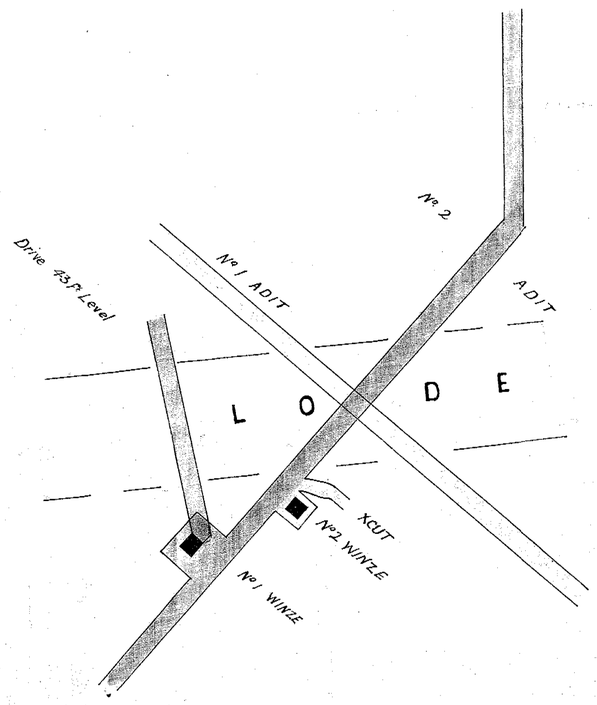

COMSTOCK

CHIEF INSPECTOR OF MINES
12 AUG 1901
LAUNCESTON